

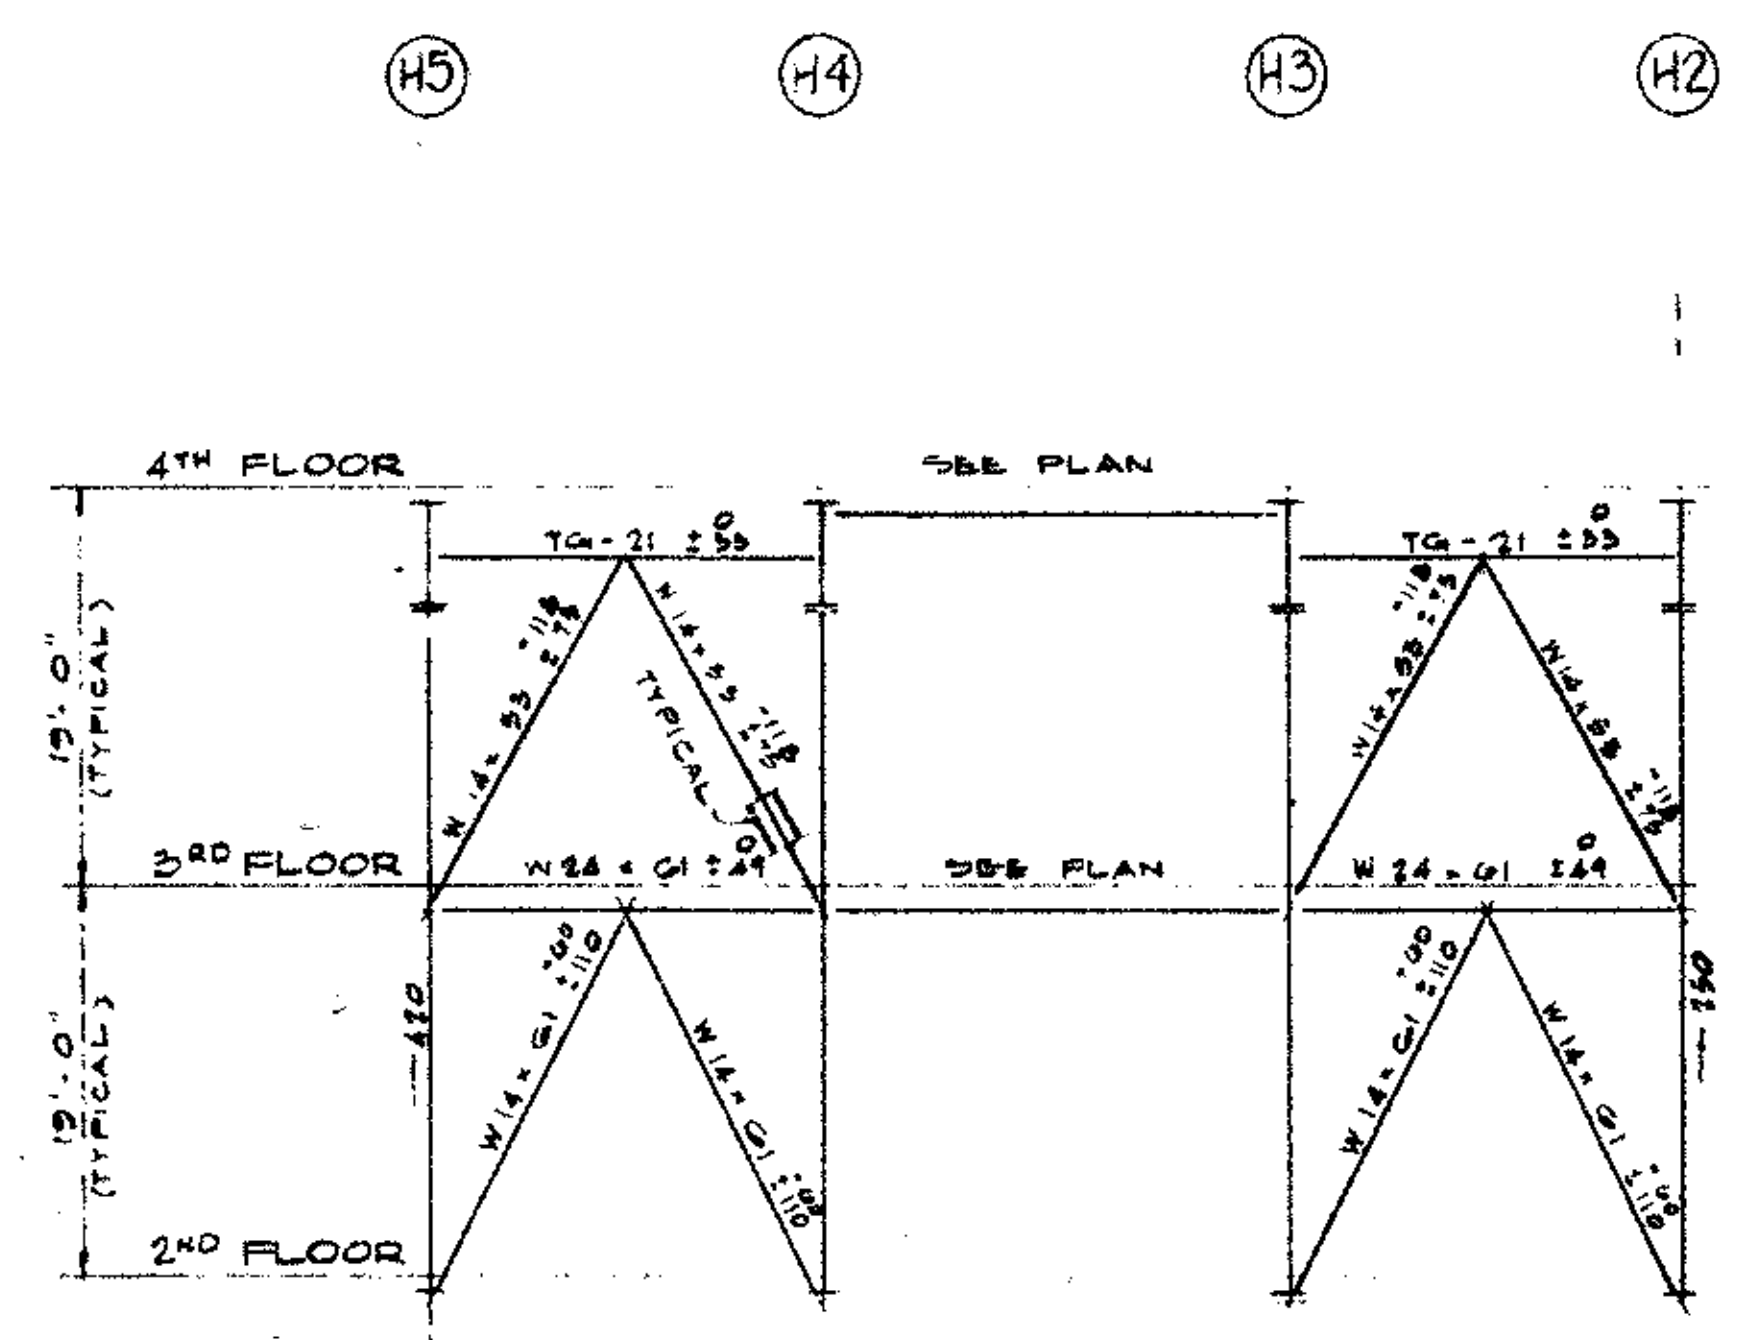



WIND BENT Nº T-1
AT COL. LINE 1

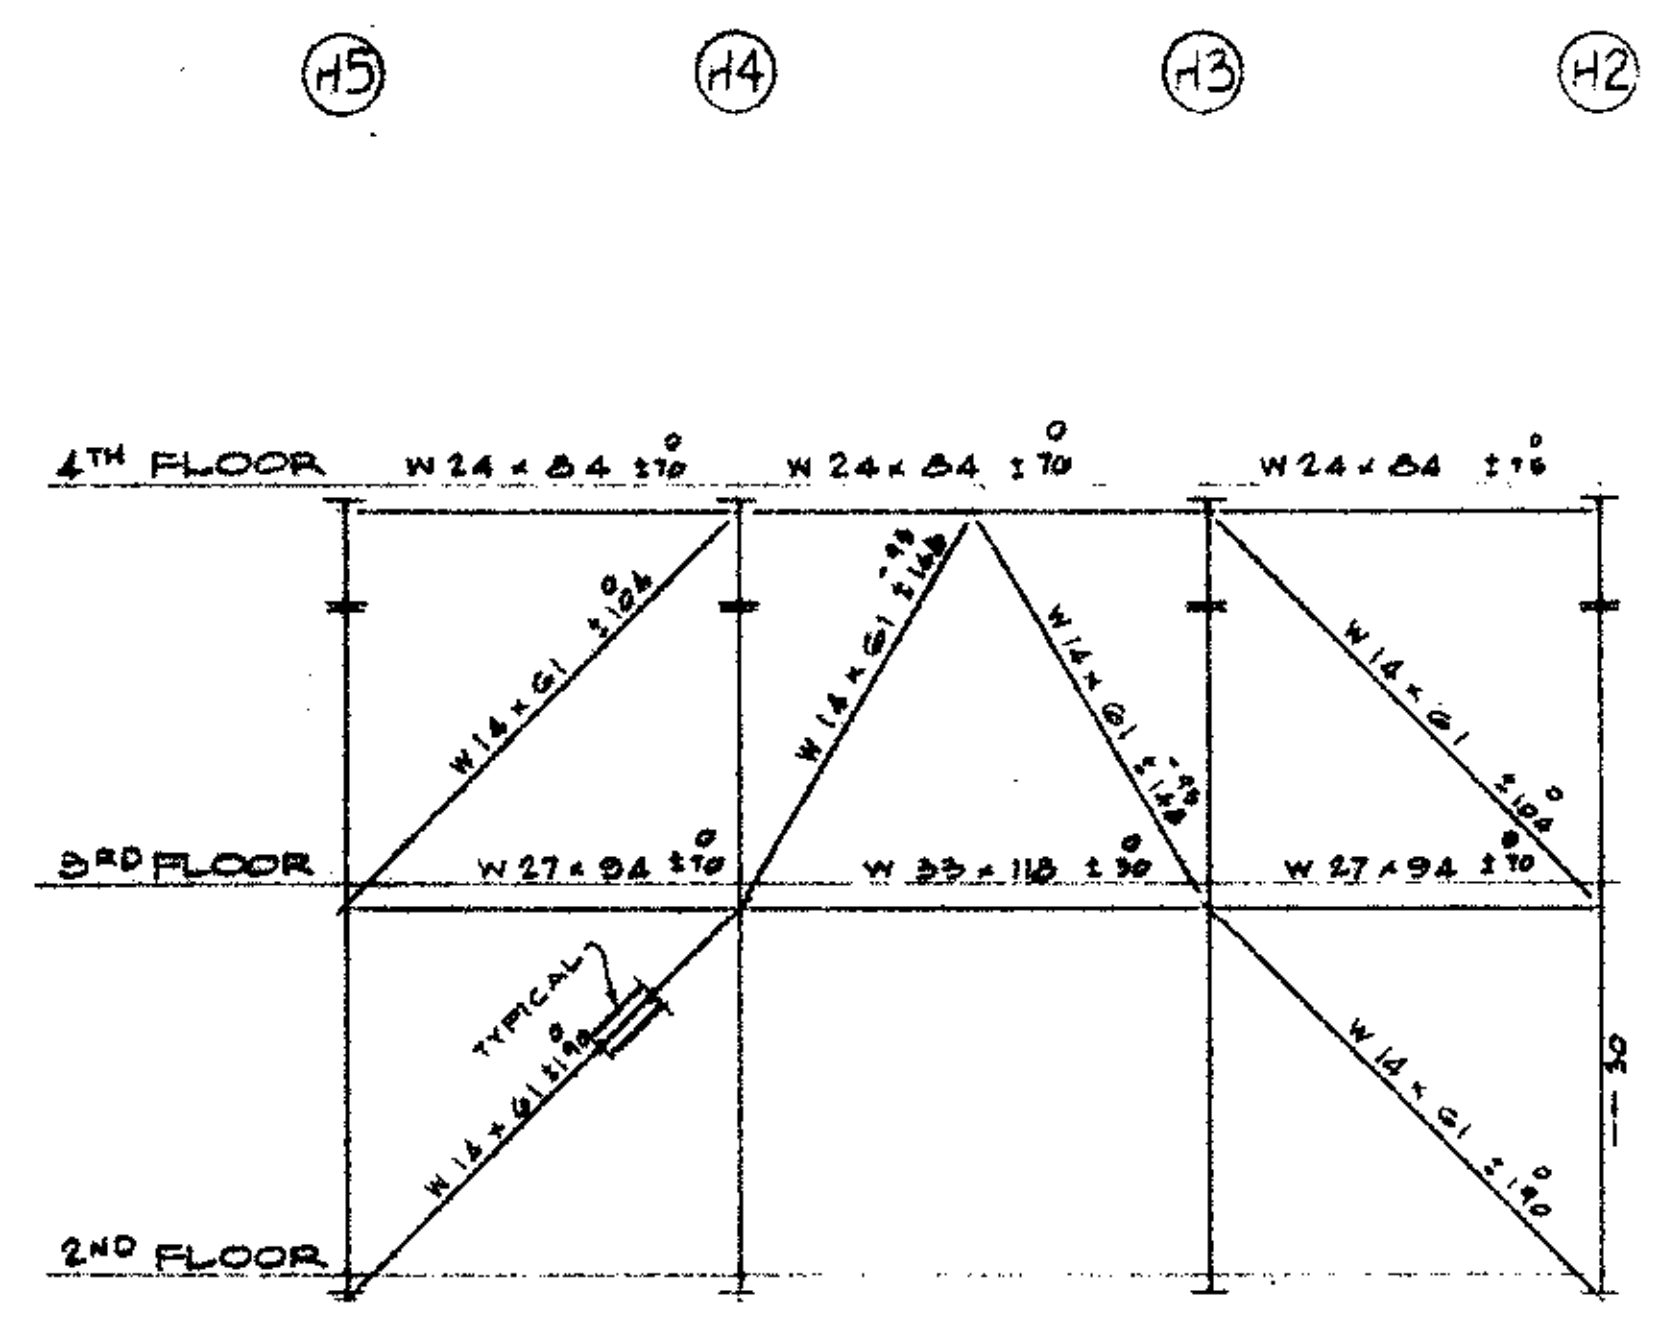


WIND BENT Nº T-2
AT COL. LINE 2

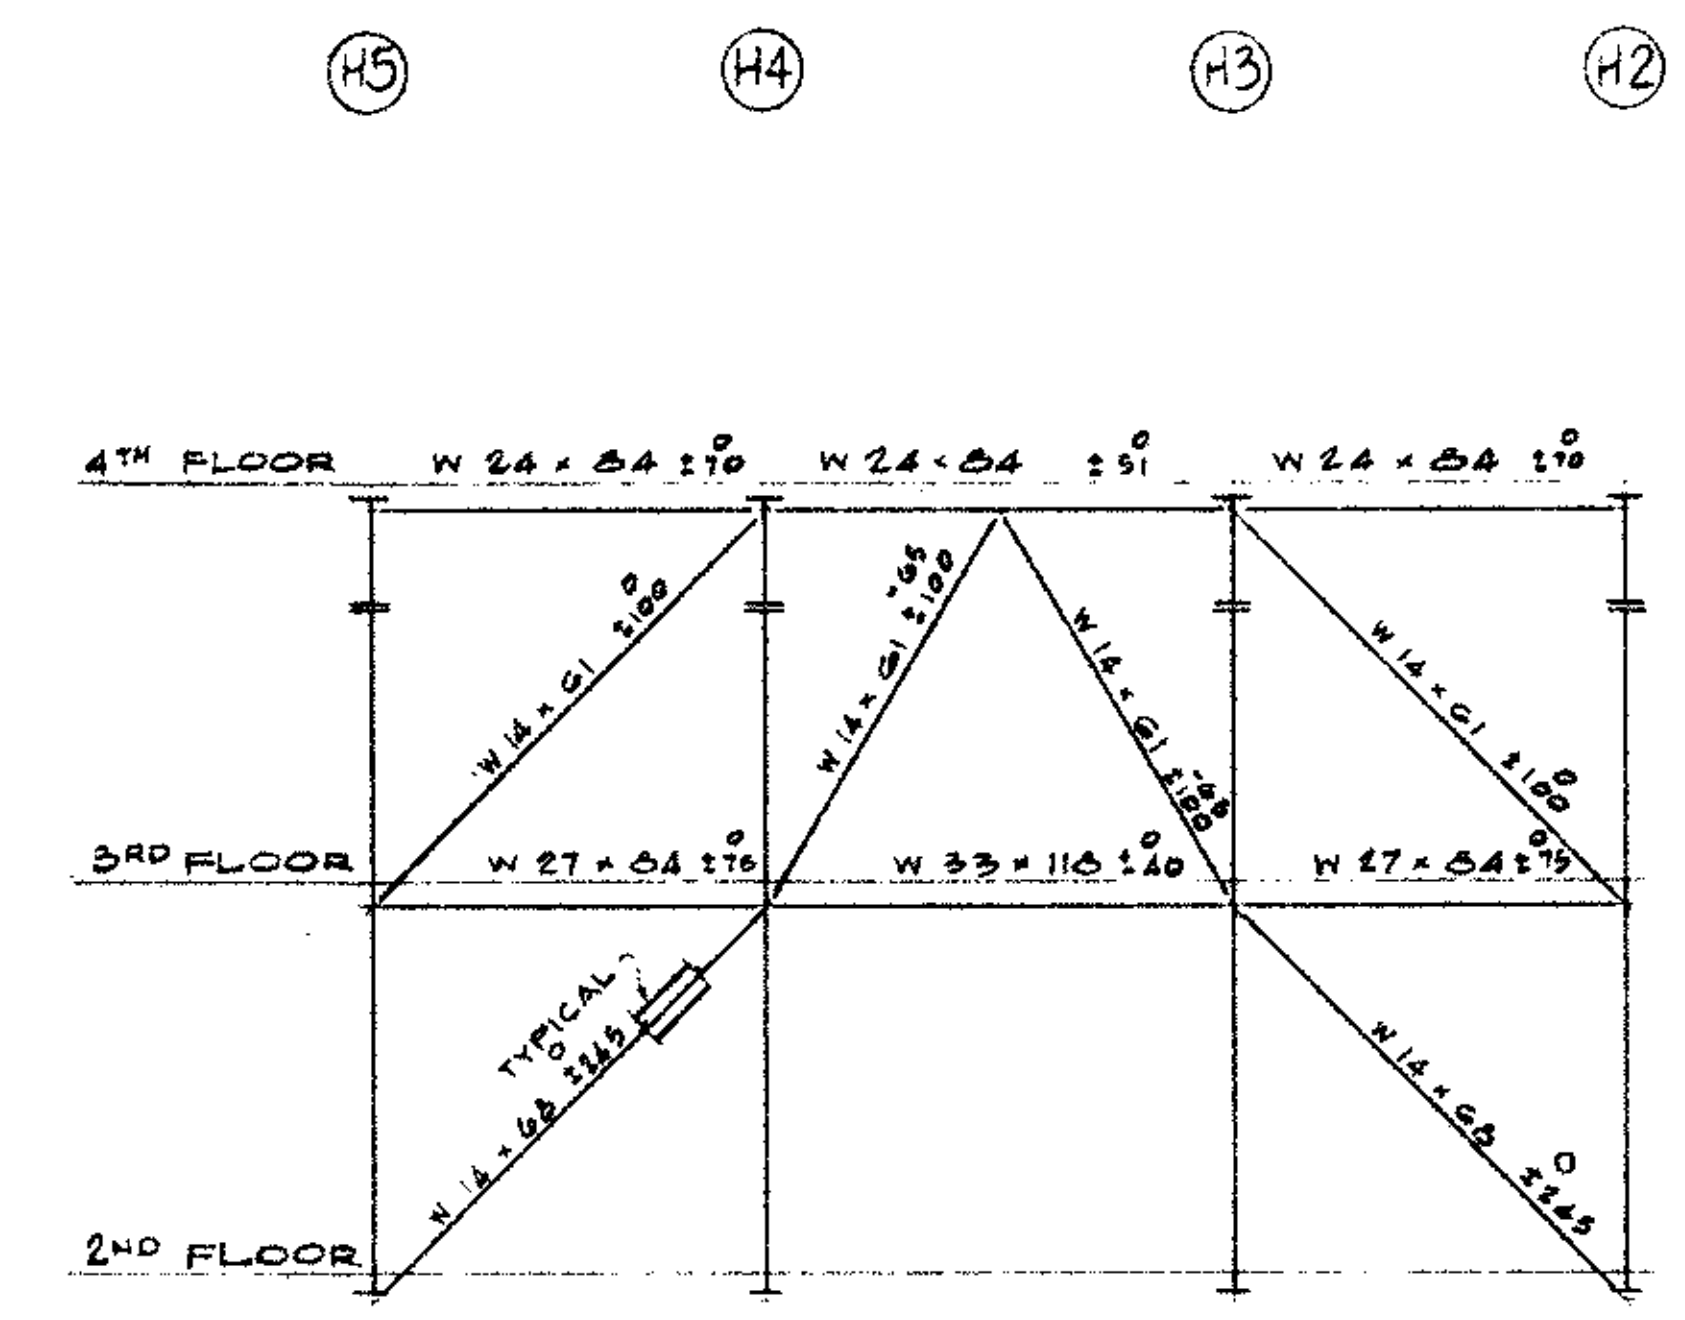


WIND BENT Nº T-3
AT COL. LINE 3

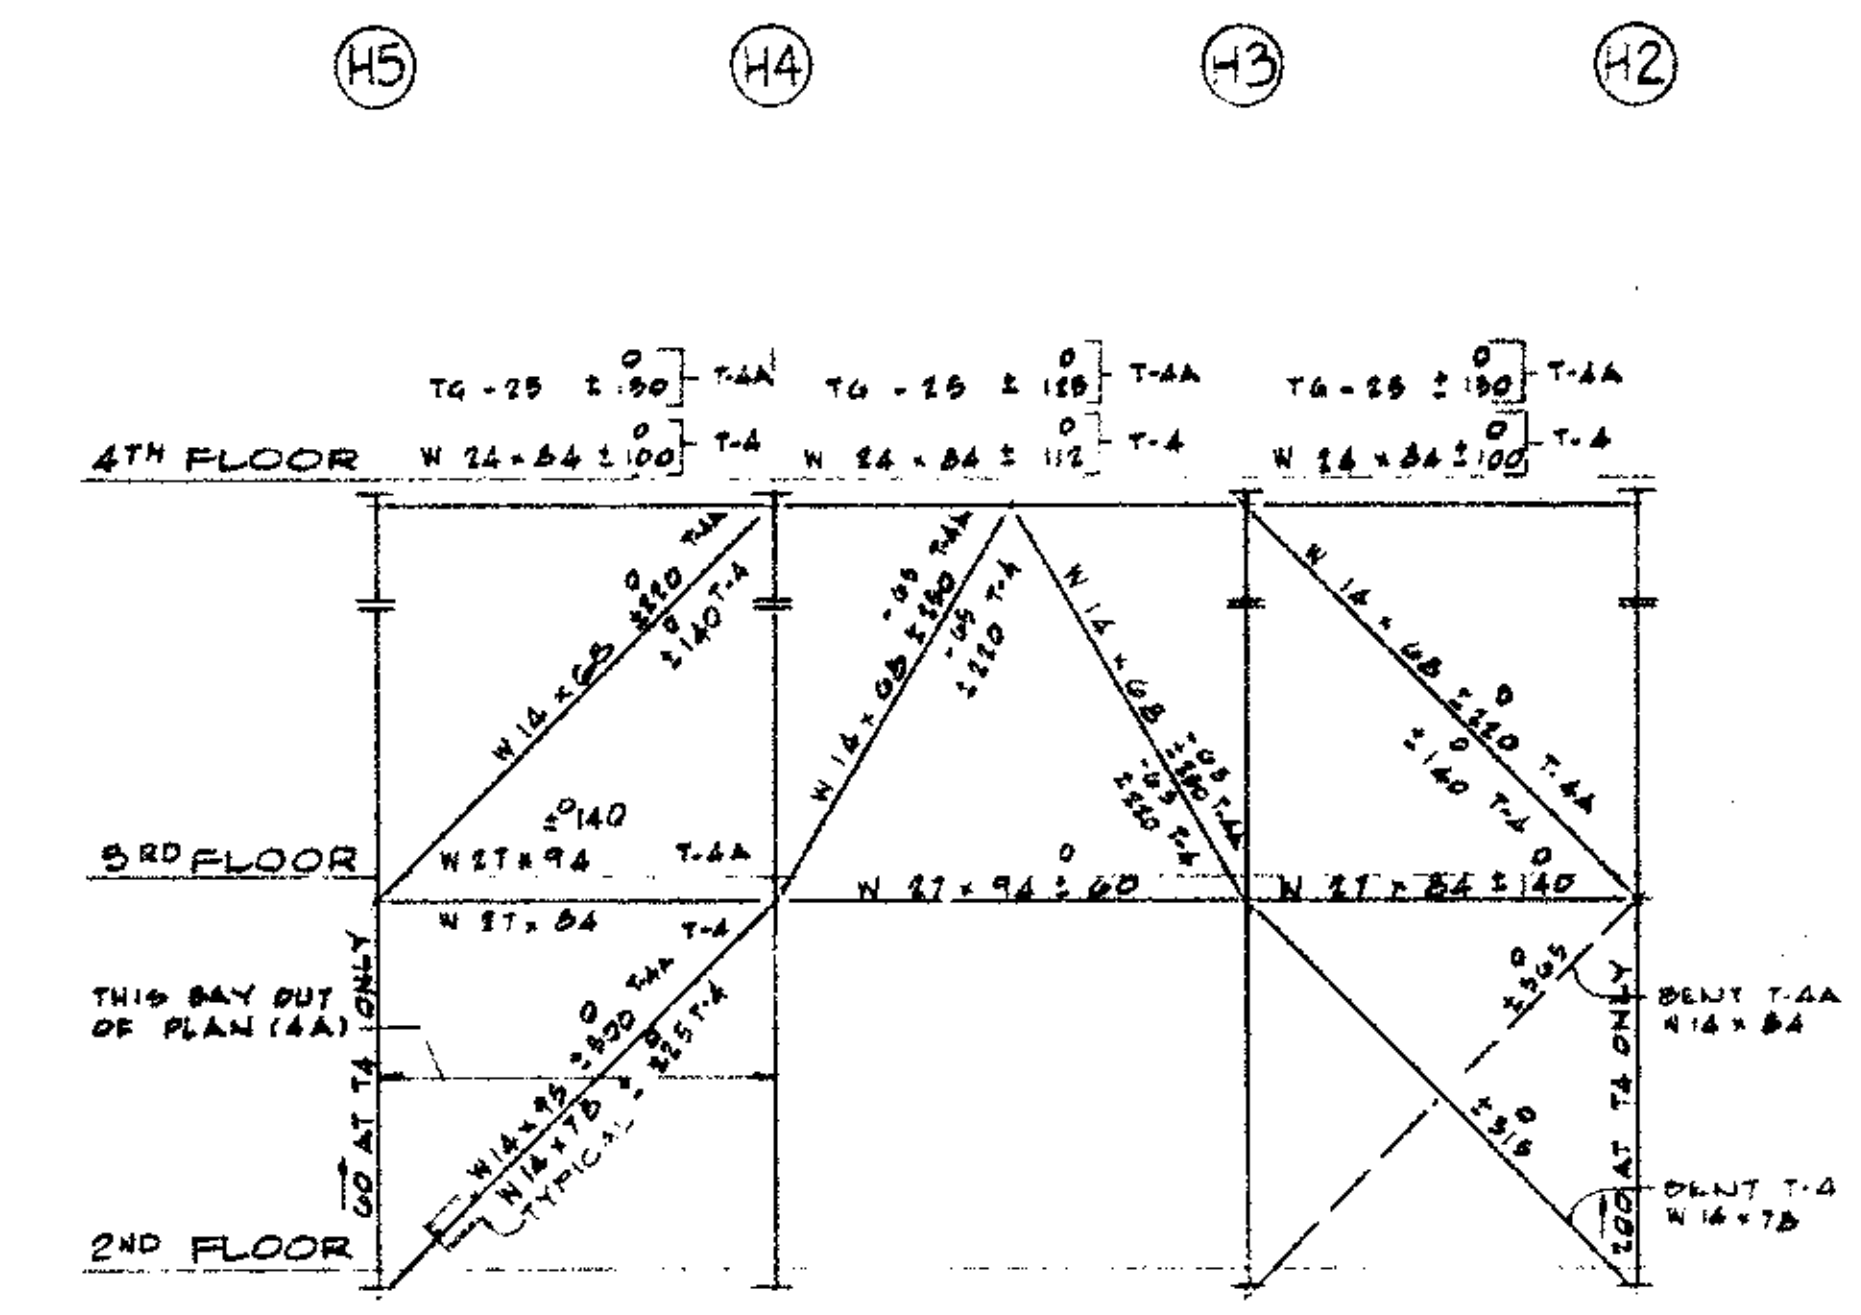


WIND BENT Nº T-4 AT COL. LINE 4
WIND BENT Nº T-4A AT COL. LINE 5

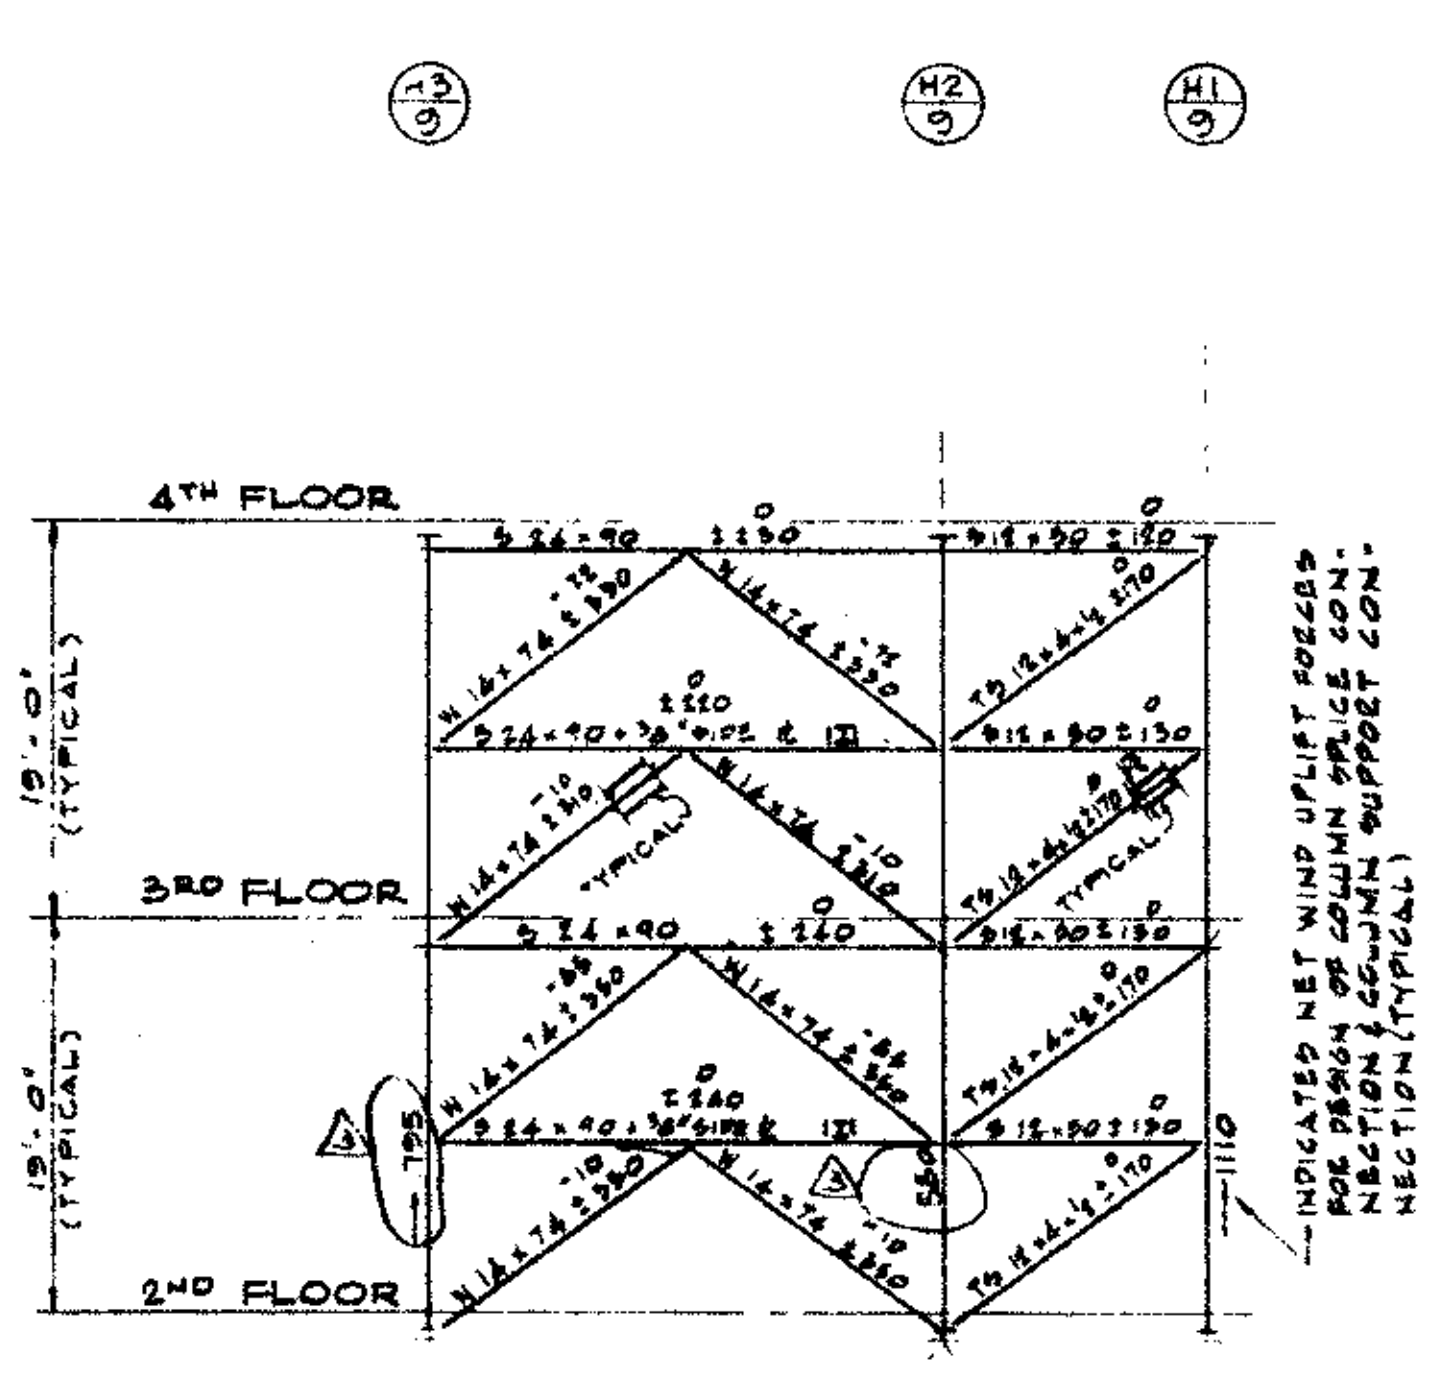


WIND BENT Nº T-5
AT COL. LINE 9

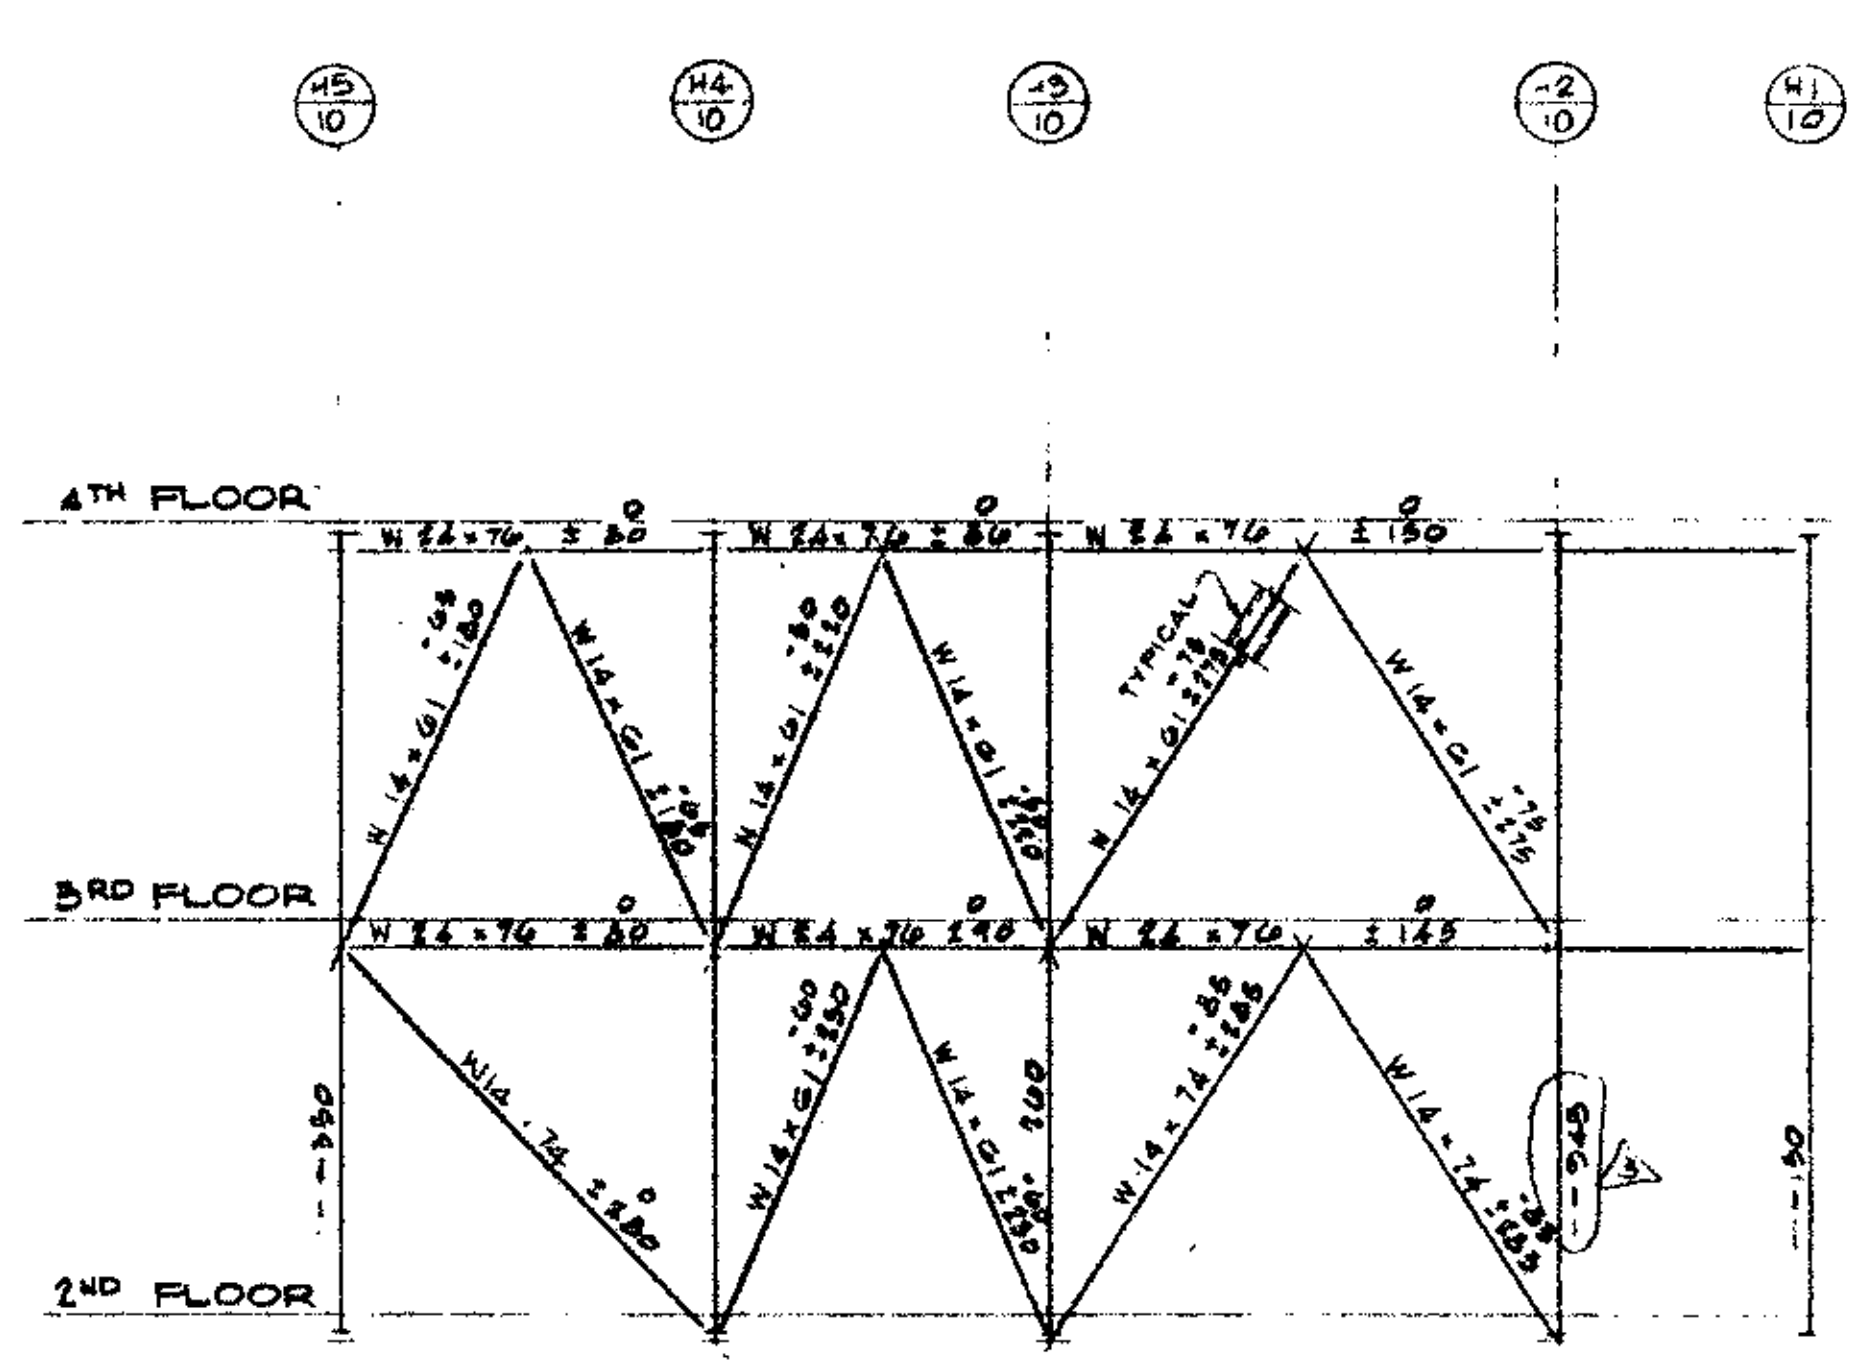


WIND BENT Nº T-6
AT COL. LINE 10

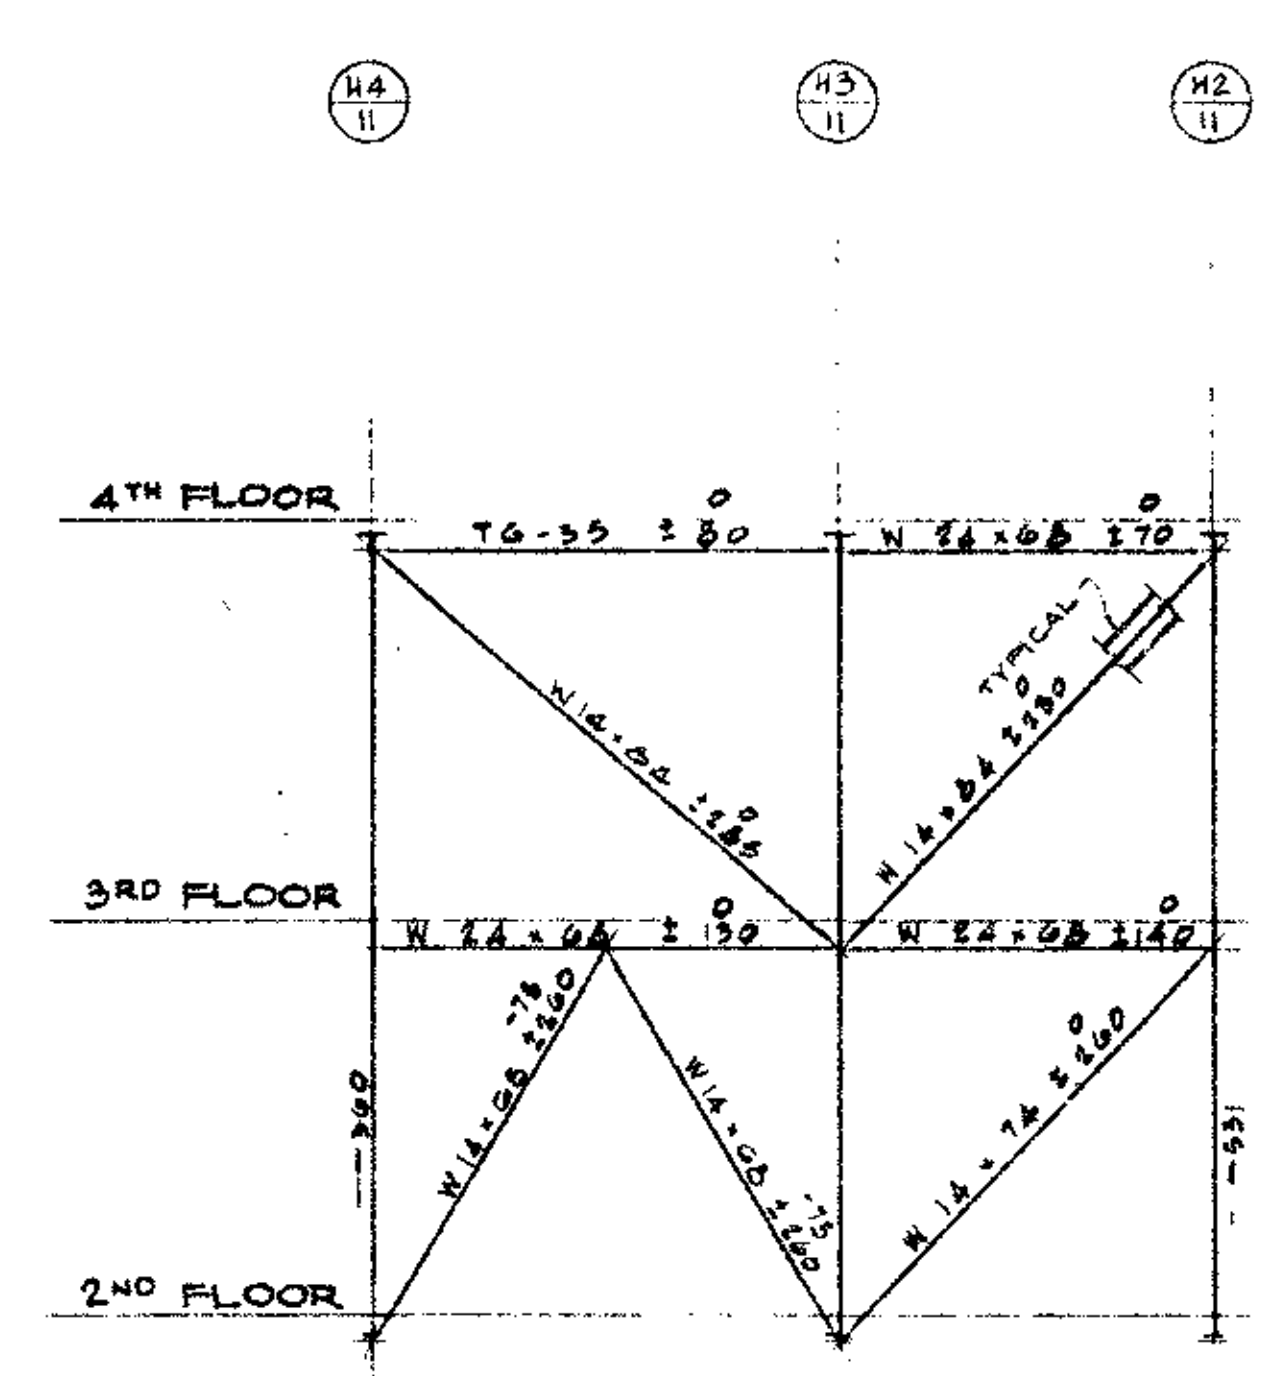

WIND BENT Nº T-7
AT COL. LINE 11

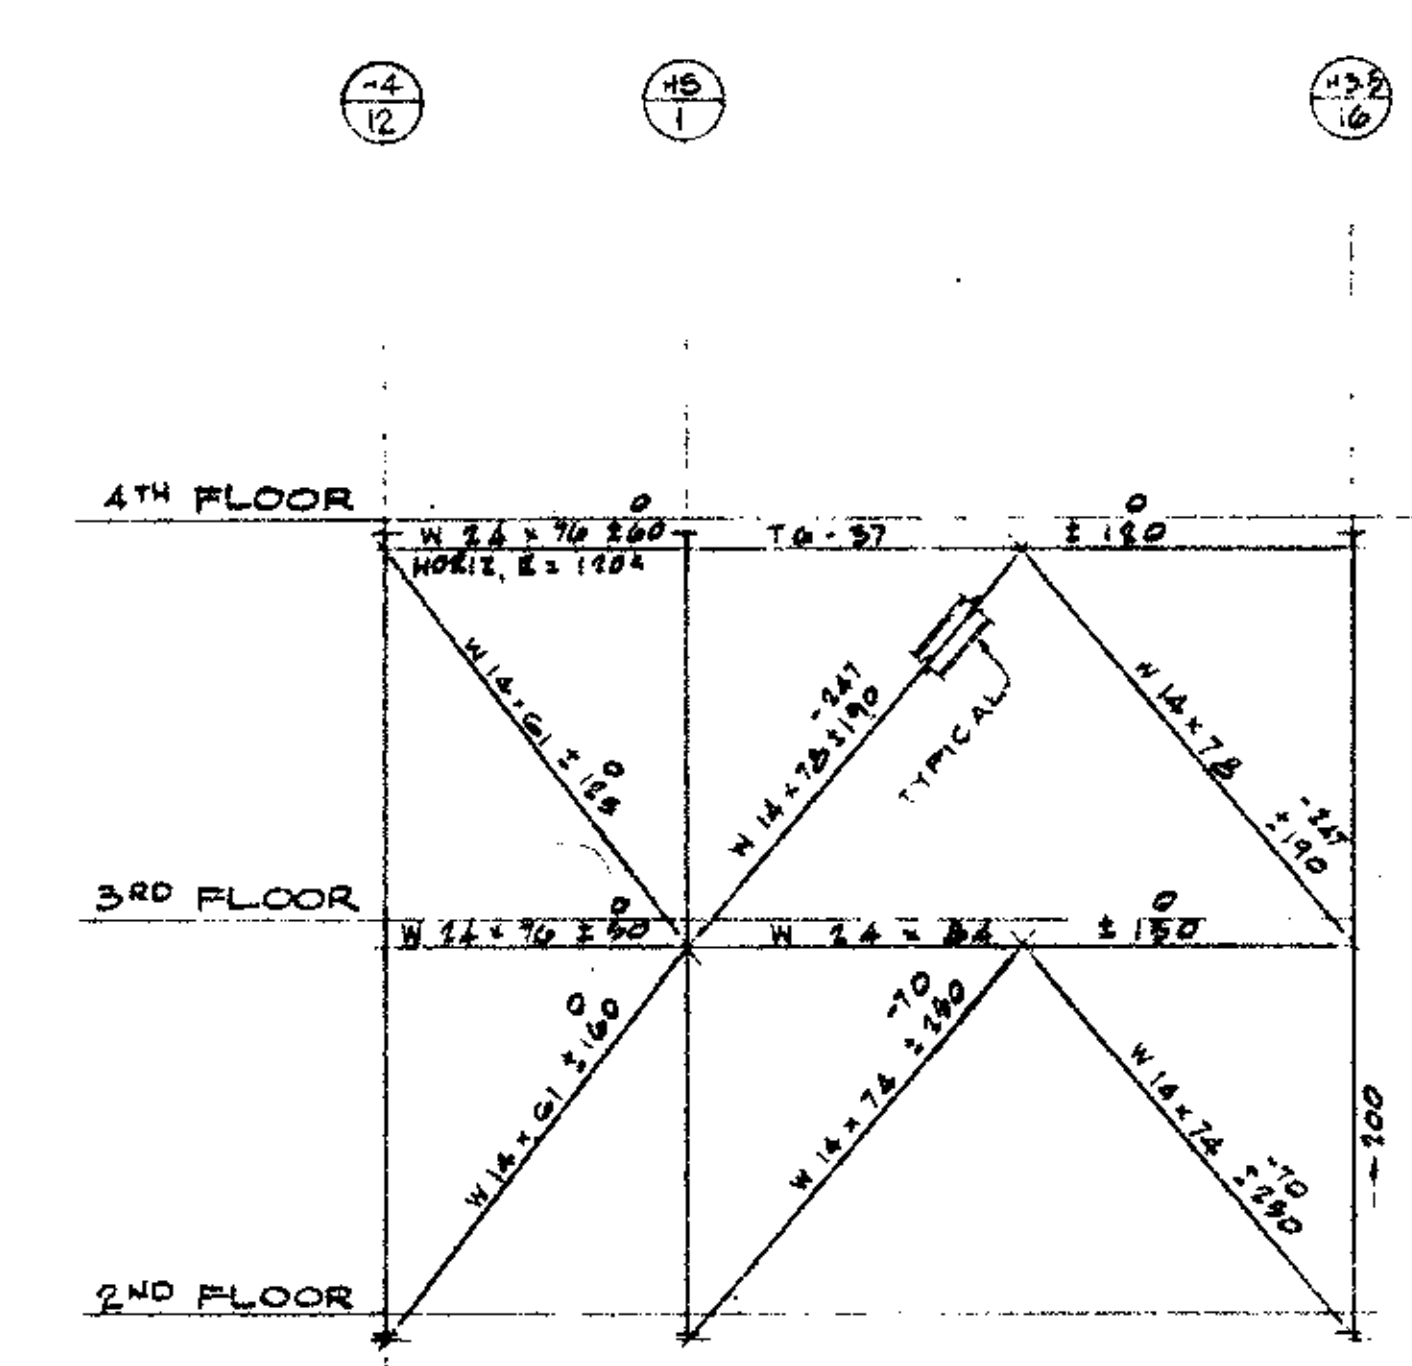

WIND BENT Nº T-8

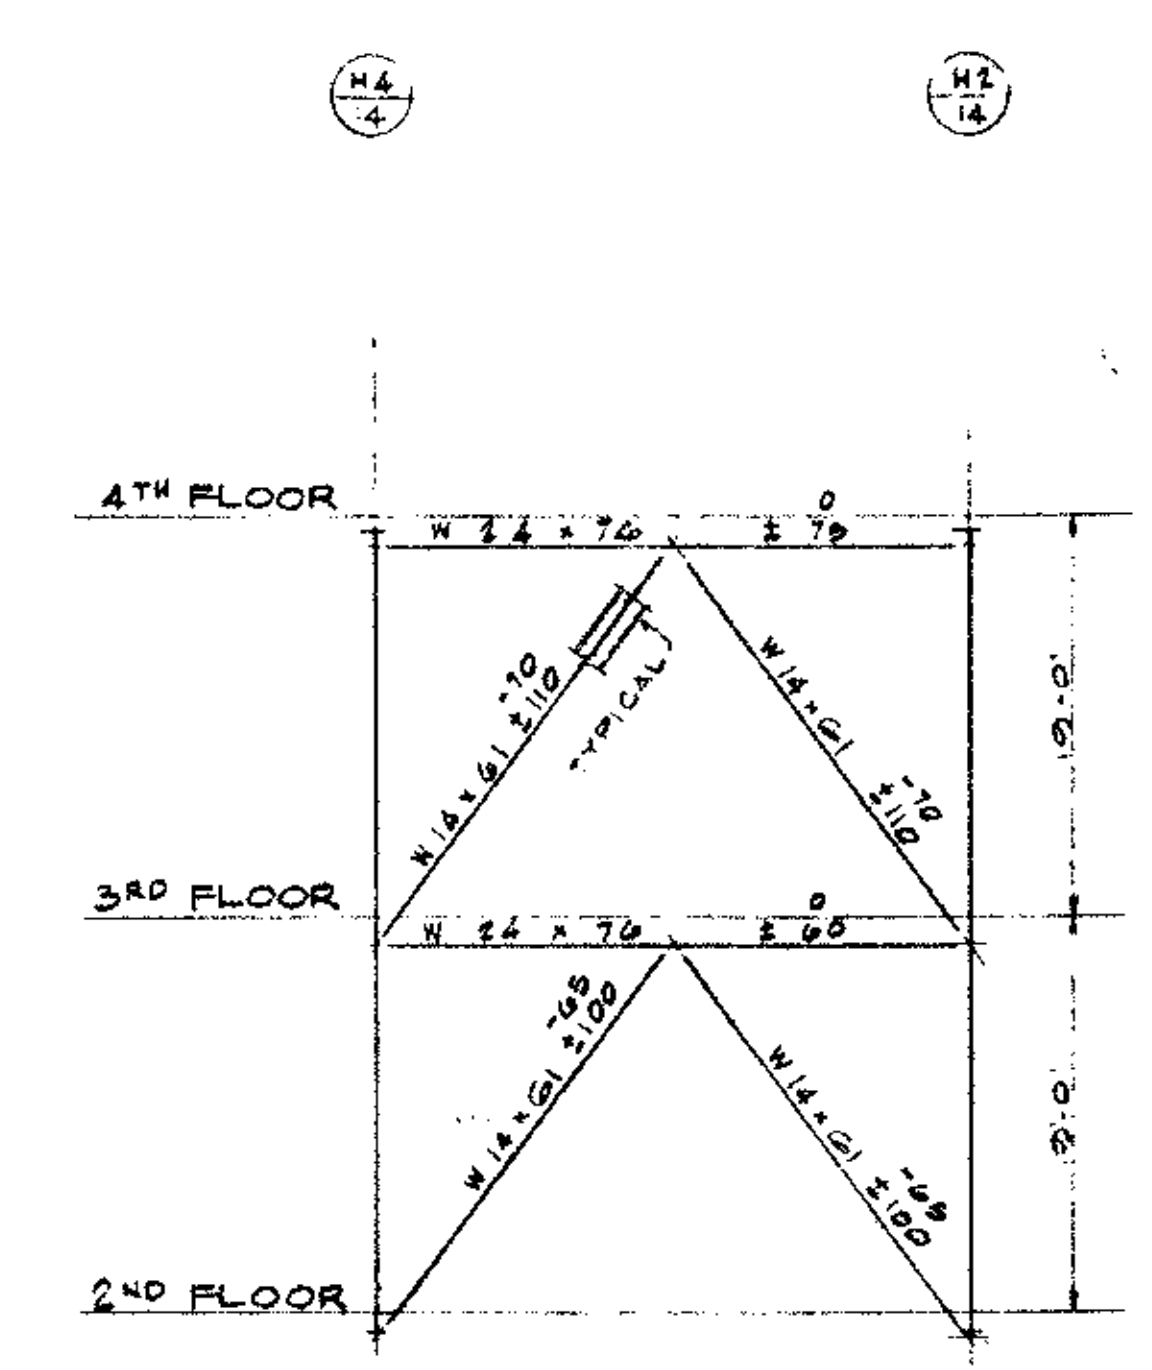

WIND BENT NºT-9
AT COL. LINE 14

RECEIVED
FEB 8 1991
LESLIE E. ROBERTSON
ASSOCIATES
211 EAST 46TH ST., N.Y.C. 10017

LEGEND:
AXIAL FORCES ON WIND MEMBERS ARE GIVEN IN KIPS
TOP LINE INDICATES GRAVITY FORCES
SECOND LINE INDICATES WIND FORCES
+ INDICATES TENSION IN MEMBERS
- INDICATES COMPRESSION IN MEMBERS

AS-BUILT DWGS

WORLD TRADE CENTER HOTEL

THE WORLD TRADE CENTER
NEW YORK NEW YORK

SKIDMORE, OWINGS & MERRILL
ARCHITECTS
400 PARK AVENUE, NEW YORK

WEISKOPF & PICKWORTH
STRUCTURAL ENGINEERS
200 PARK AVENUE, NEW YORK

JAROS, BAUM & BOLLES
MECHANICAL ENGINEERS
345 PARK AVENUE, NEW YORK

NO.	DATE	REVISIONS
	1-15-79	ISSUED FOR PORT AUTHORITY REVIEW
	1-3-79	ISSUED TO PORT AUTHORITY
3	12-6-78	SEE BULLETIN # 11
2	10-27-78	SEE BULLETIN # 6
	10-16-78	ISSUED TO PORT AUTHORITY
1	10-18-78	SEE BULLETIN Nº 5
	9-14-78	
	6-8-78	ISSUED FOR STRUCTURAL STEEL ONLY
	7-31-78	ISSUED FOR INFORMATION ONLY

WIND BENTS & DETAILS
SHEET 3

DATE: JUNE 1, 1978
SCALE:
DRAWING NO. S-13