




SECTION 1-1
SCALE 3/4" = 1'-0"

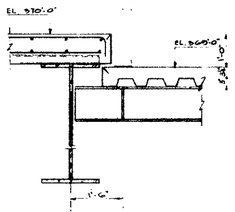


SECTION 2-2
SCALE 3/4" = 1'-0"

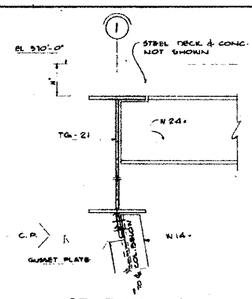


SECTION 3-3
SCALE 3/4" = 1'-0"

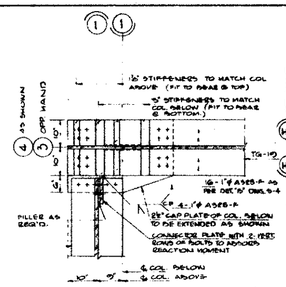


DETAIL 4
SCALE 3/4" = 1'-0"

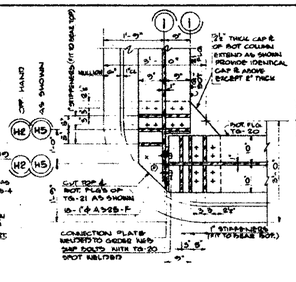

DETAIL 5
SCALE 3/4" = 1'-0"

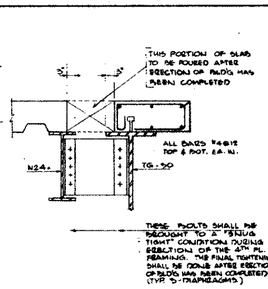


SECTION 6-6
SCALE 3/4" = 1'-0"

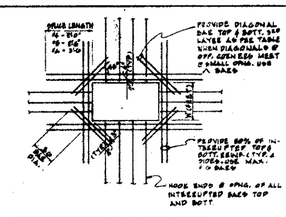


DIAGONAL BAR TABLE	
W (LEAST DIMENSION OF OPNG. IN FEET)	BARS- TOP & BOTT BA. GIRDERS
W TO 5'-0"	1- 1-#8
5'-0"< W ≤ 6'-0"	2-#8
6'-0"< W ≤ 8'-0"	2-#10
8'-0"< W ≤ 10'-0"	3-#10


DETAIL 7
SCALE 3/4" = 1'-0"

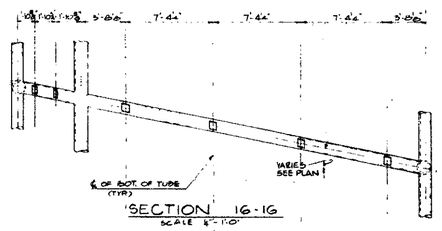


SECTION 16-16

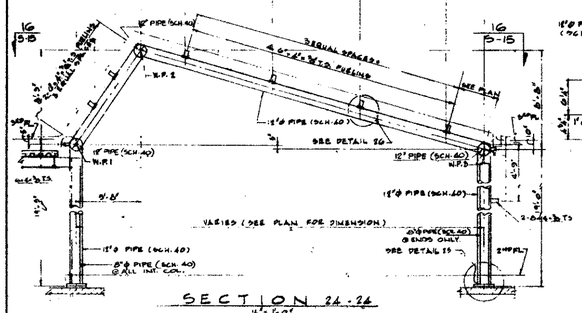

SECTION 24-24
1/4" = 1'-0"

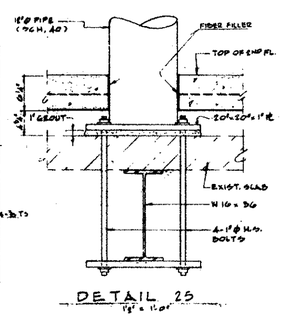


DETAIL 25
1½" = 1'-0"

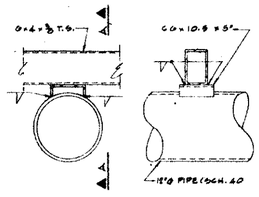

VIEW A-A

DETAIL 26
1½" = 1'-0"

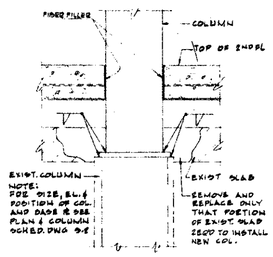

DETAIL 27

WORLD TRADE CENTER HOTEL

THE WORLD TRADE CENTER
NEW YORK NEW YORK

SKIDMORE, OWINGS & MERRILL
ARCHITECTS
400 PARK AVENUE, NEW YORK

WEISKOPF & PICKWORTH
STRUCTURAL ENGINEERS
200 PARK AVENUE, NEW YORK

JAROS, BAUM & BOLLES
MECHANICAL ENGINEERS
345 PARK AVENUE, NEW YORK

RECEIVED
FEB 8 1991
LESLIE E. ROBERTSON ASSOCIATES
211 EAST 43RD ST., N.Y.C. 10017

AS-BUILT DWGS

NO.	DATE	REVISIONS
	1-15-19	ISSUED FOR PORT AUTHORITY REVIEW
	1-5-19	ISSUED TO PORT AUTHORITY
5	12-28-18	SEE BULLETIN # 14
4	12-6-18	SEE BULLETIN # 11
3	10-17-18	SEE BULLETIN # 6
	9-10-18	ISSUED TO PORT AUTHORITY
	10-16-12	ISSUED FOR MILL ORDERS

STRUCTURAL DETAILS N° 2

DRAWING NO. S-15