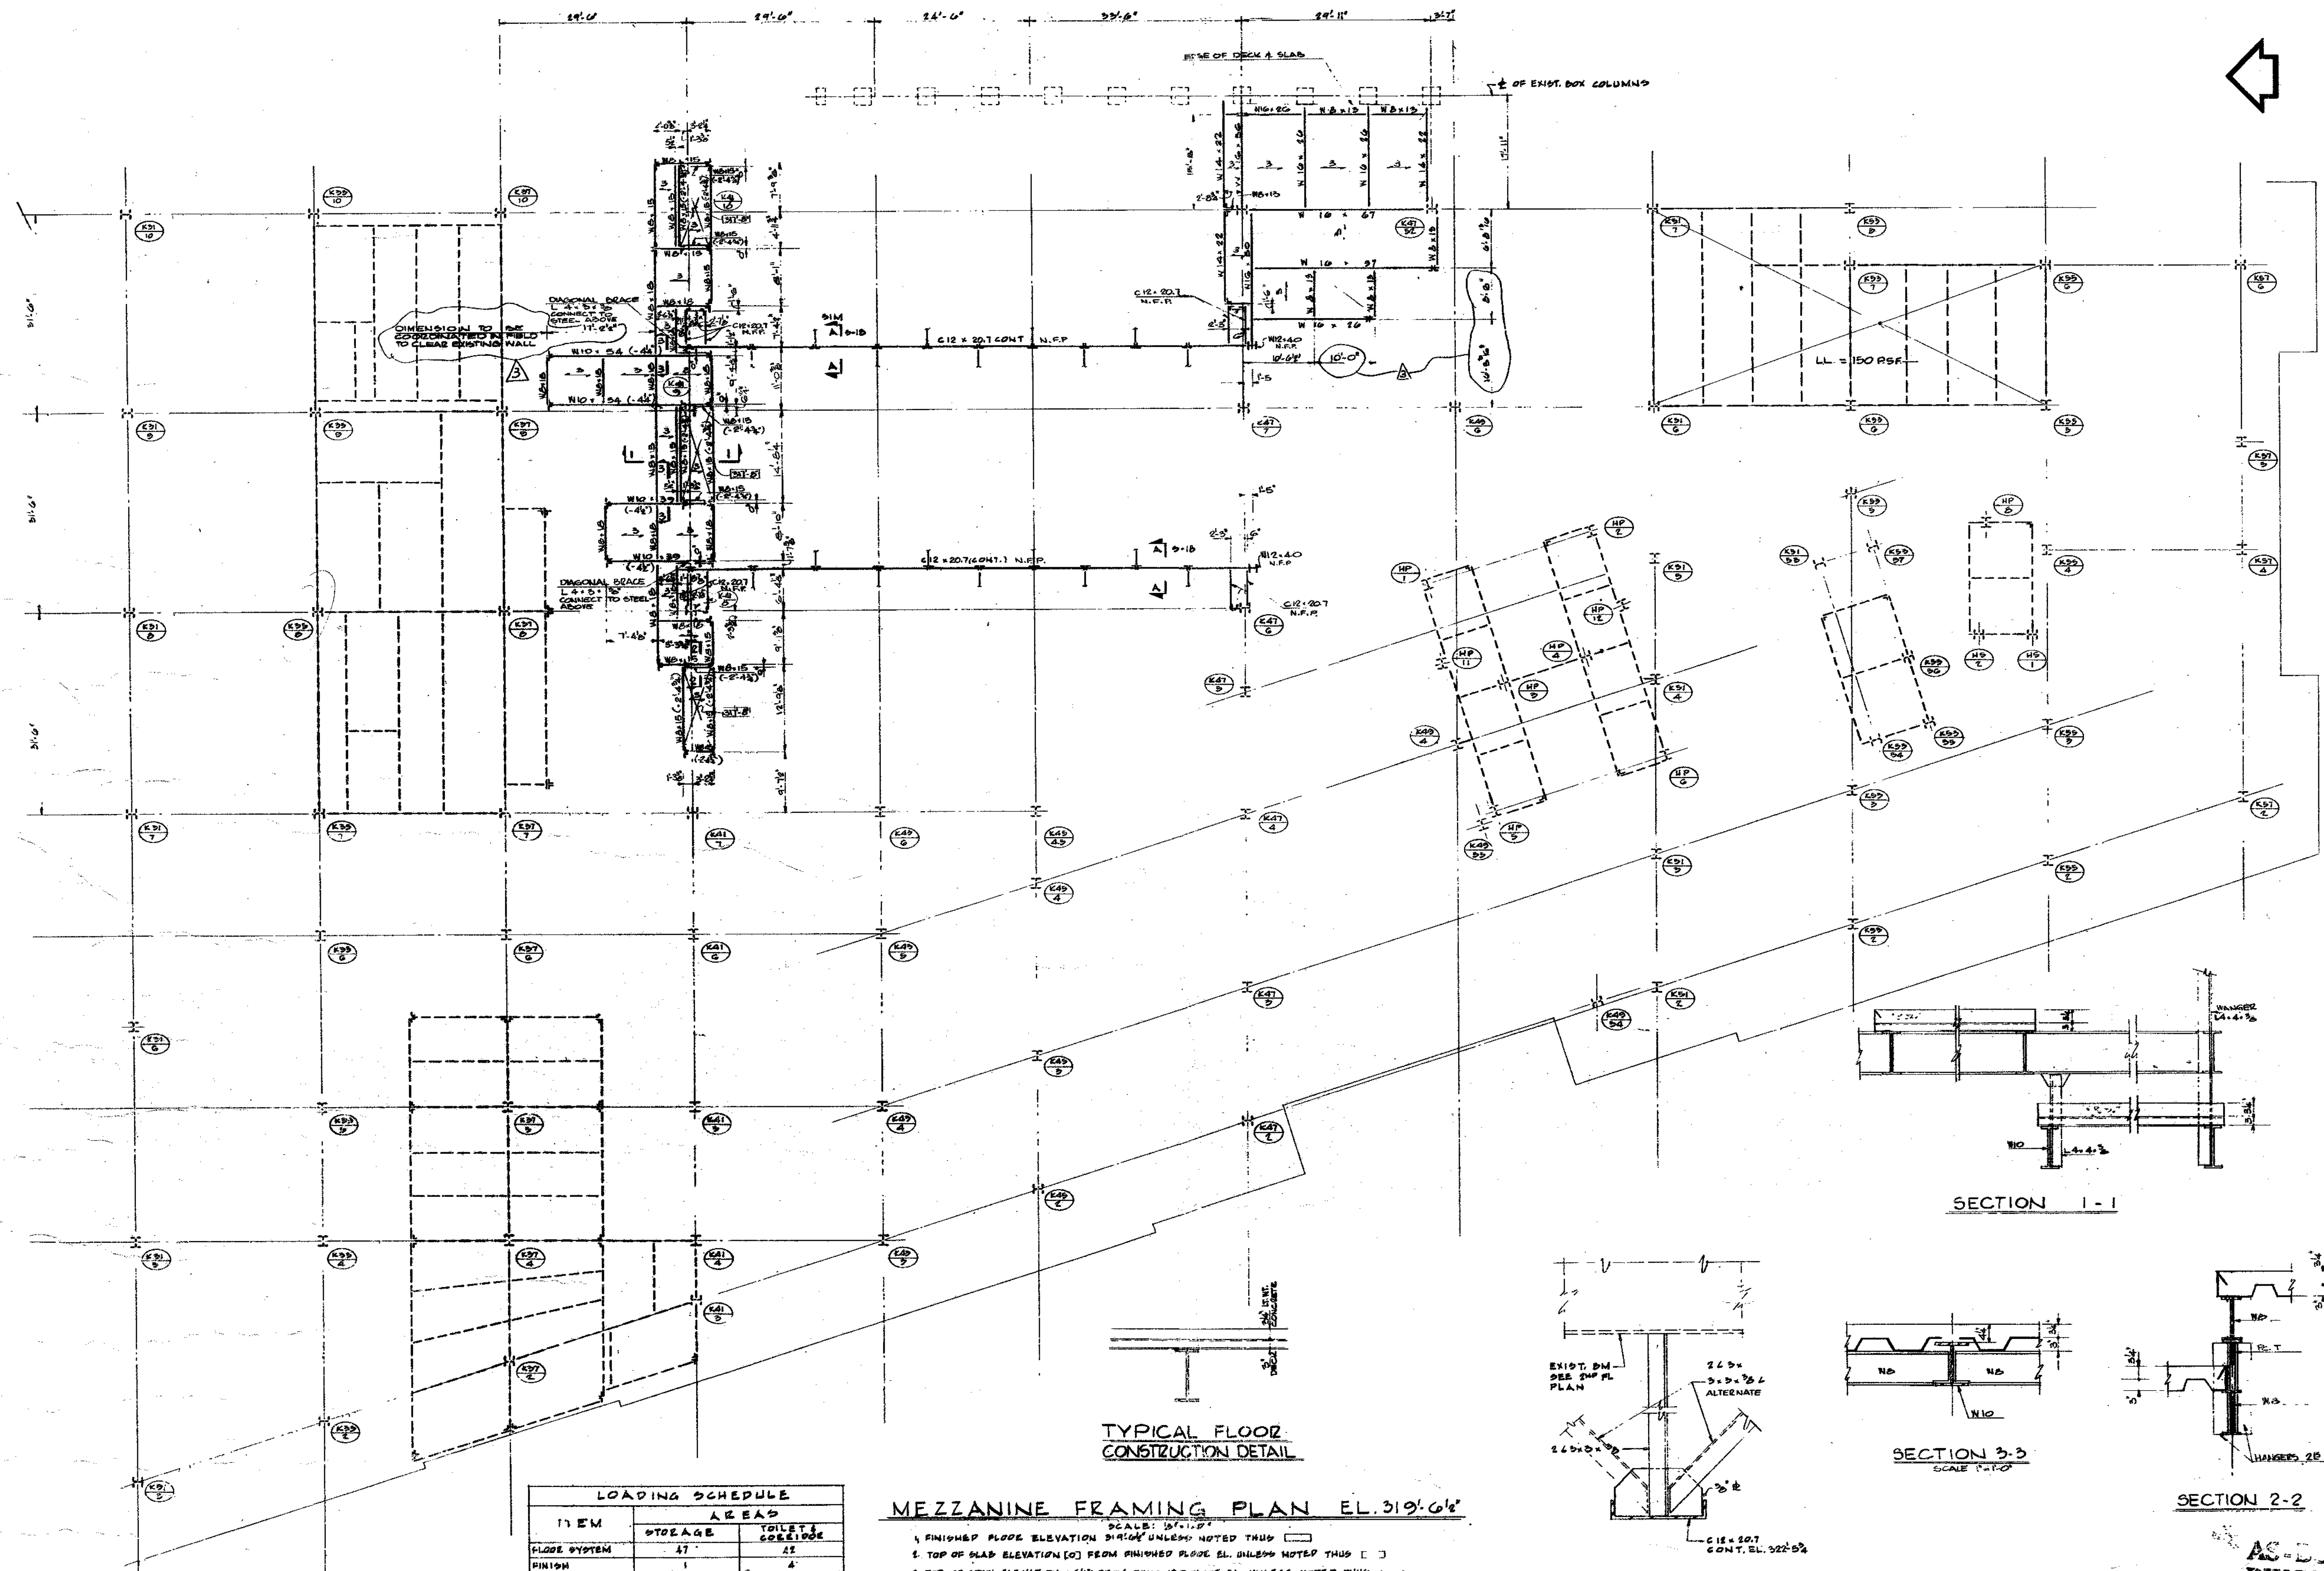


TYPICAL FLOOR CONSTRUCTION DETAIL

SECTION A-A
SCALE: 1½"=1'-0"

SECTION 1-1

SECTION 3-3
SCALE 1"=1'-0"

SECTION 2-2

LOADING SCHEDULE		
ITEM	AREAS	
	STORAGE	TOILET & CORRIDOR
FLOOR SYSTEM	47	42
FINISH	1	4
CEILING	3	3
PARTITIONS	10	30
STEEL & F.P.	AS THEY OCCUR	
MECH & ELECT'L	2	5
TOTAL DEAD LOAD	63	86
LIVE LOAD	100	40
TOTAL LOAD	163	126

MEZZANINE FRAMING PLAN EL. 319'-6½"

SCALE: 1/8"=1'-0"

1. FINISHED FLOOR ELEVATION 319'-6½" UNLESS NOTED THUS ▭
2. TOP OF SLAB ELEVATION [0] FROM FINISHED FLOOR EL. UNLESS NOTED THUS [ ]
3. TOP OF STEEL ELEVATION (-6¼") FROM FINISHED FLOOR EL. UNLESS NOTED THUS ( )
4.
5. —3— INDICATES DIRECTION OF 3" METAL DECK
6. METAL DECK SHALL BE "LOK FLOOR" 20 GA. (U.S. DECK INC.)
7. HANGERS SHALL BE 2 L 4×4×3/8 UNLESS NOTED.

WORLD TRADE CENTER HOTEL

THE WORLD TRADE CENTER
NEW YORK NEW YORK

SKIDMORE, OWINGS & MERRILL
ARCHITECTS
400 PARK AVENUE, NEW YORK

WEISKOPF & PICKWORTH
STRUCTURAL ENGINEERS
200 PARK AVENUE, NEW YORK

JAROS, BAUM & BOLLES
MECHANICAL ENGINEERS
345 PARK AVENUE, NEW YORK

NO.	DATE	REVISIONS
3	5-25-79	BULLETIN # 26
2	4-5-79	BULLETIN # 22
	1-15-79	ISSUED FOR PORT AUTHORITY REVIEW
1	1-15-79	BULLETIN # 15
	1-3-79	ISSUED TO PORT AUTHORITY
	11-6-78	ISSUED FOR STRUCTURAL STEEL BULLETIN # 10
	10-26-78	ISSUED TO PORT AUTHORITY
	9-14-78	

AS-BUILT DWGS

MEZZANINE FRAMING PLAN

DRAWING NO. S-1B

RECEIVED
NOV 19 1992
LESLIE E. ROBERTSON ASSOCIATES
211 E. 46th ST. N.Y., N.Y.C. 10017