WORLD TRADE CENTER HOTEL


THE WORLD TRADE CENTER
NEW YORK, NEW YORK

SKIDMORE, OWINGS & MERRILL
ARCHITECTS
ONE PARK AVENUE, NEW YORK

WEIDLINGER & FICKENTHEN
STRUCTURAL ENGINEERS
ONE PARK AVENUE, NEW YORK

JAROS, BAUM & BOLLES
MECHANICAL ENGINEERS
ONE PARK AVENUE, NEW YORK

COLUMN SCHEDULE - PLAZA EXTENSION AREA

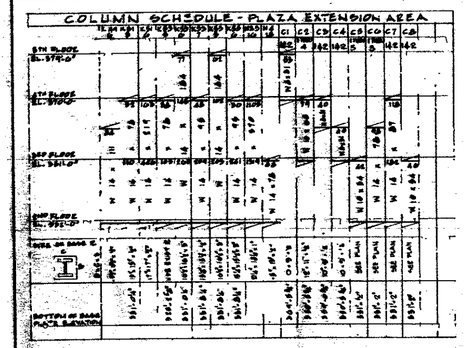

NOTE: COORDINATE EXACT HANGER LOCATIONS W. M. METZ. STRUCTURAL DWG. S-15.

SECTION 1-1
(@ ELEVATOR SHAFT)

SECTION 3-3

SECTION 4-4

SECTION 5-5

SECTION 6-6

SECTION 7-7

SECTION 8-8

SECTION 9-9

TYPICAL FLOOR CONSTRUCTION

SECTION 2-2

LEGEND
1. ——— INDICATES EXISTING STEEL TO REMAIN
2. ——— INDICATES EXISTING STEEL TO REMOVE
3. ——— INDICATES NEW BEAMS SHOWN THUS N--

2ND FLOOR FRAMING PLAN EL. 331'-6"

1. TOP OF NEW SLAB [6"]
2. TOP OF EXISTING SLAB [6"] UNLESS NOTED THUS [ ] ON PLAN
3. TOP OF NEW METAL DECK (-3½") UNLESS NOTED THUS ( ) ON PLAN
4. ——— INDICATES DIRECTION OF METAL DECK
5. TOP OF STEEL EL. (-0'-6") FROM PIN PLANE EL. UNLESS NOTED THUS ( )

NOTE:
CONTRACTOR SHALL VERIFY ALL EXISTING CONDITIONS AT POINTS OF SUPPORTS OF THE NEW STEEL WORK. ANY DISCREPANCIES FROM THE DRAWINGS SHALL BE REPORTED TO THE ARCHITECT. NO WORK SHALL BE PROCEEDED AT THESE POINTS UNTIL THE CONTRACTOR RECEIVES SPECIFIC INSTRUCTIONS FROM THE ARCHITECT.

LOADING SCHEDULE		
ITEM	AREAS	
	EXIST. PLAZA	NEW: KITCHEN COFFEE SHOP & LOUNGE
PLANTING	25	-
FLOOR SYSTEM	55	91
FINISH	10	2
CEILING	10	3
PARTITIONS	-	10
GRAVEL, MEMBRANE & INSULATION	29	-
CONC. TOPPING	69	-
STEEL & F.P.	AS THEY OCCUR	AS THEY OCCUR
MECHANICAL & ELECT.	0	5
TOTAL DEAD LOAD	208	119
LIVE LOAD	100	100
TOTAL LOAD	308	219

NO.	DATE	REVISIONS
5	5-25-79	BULLETIN #20
4	1-5-79	BULLETIN #22
	1-15-79	ISSUED FOR POST AUTHORITY REVIEW
3	1-5-79	BULLETIN #15
	1-3-79	ISSUED TO PORT AUTHORITY
2	12-14-78	BULLETIN #12
1	9-15-78	BULLETIN #10
	9-25-78	ISSUED TO PORT AUTH
	8-18-78	ISSUED FOR ESTIMATE
	5-24-78	
	3-8-78	ISSUED FOR INFORM ONLY.

AS-BUILT
DWG. 2ND FLOOR FF PL

RECF
NOV

LESLIE E.
ASS
211 E. 46th S