

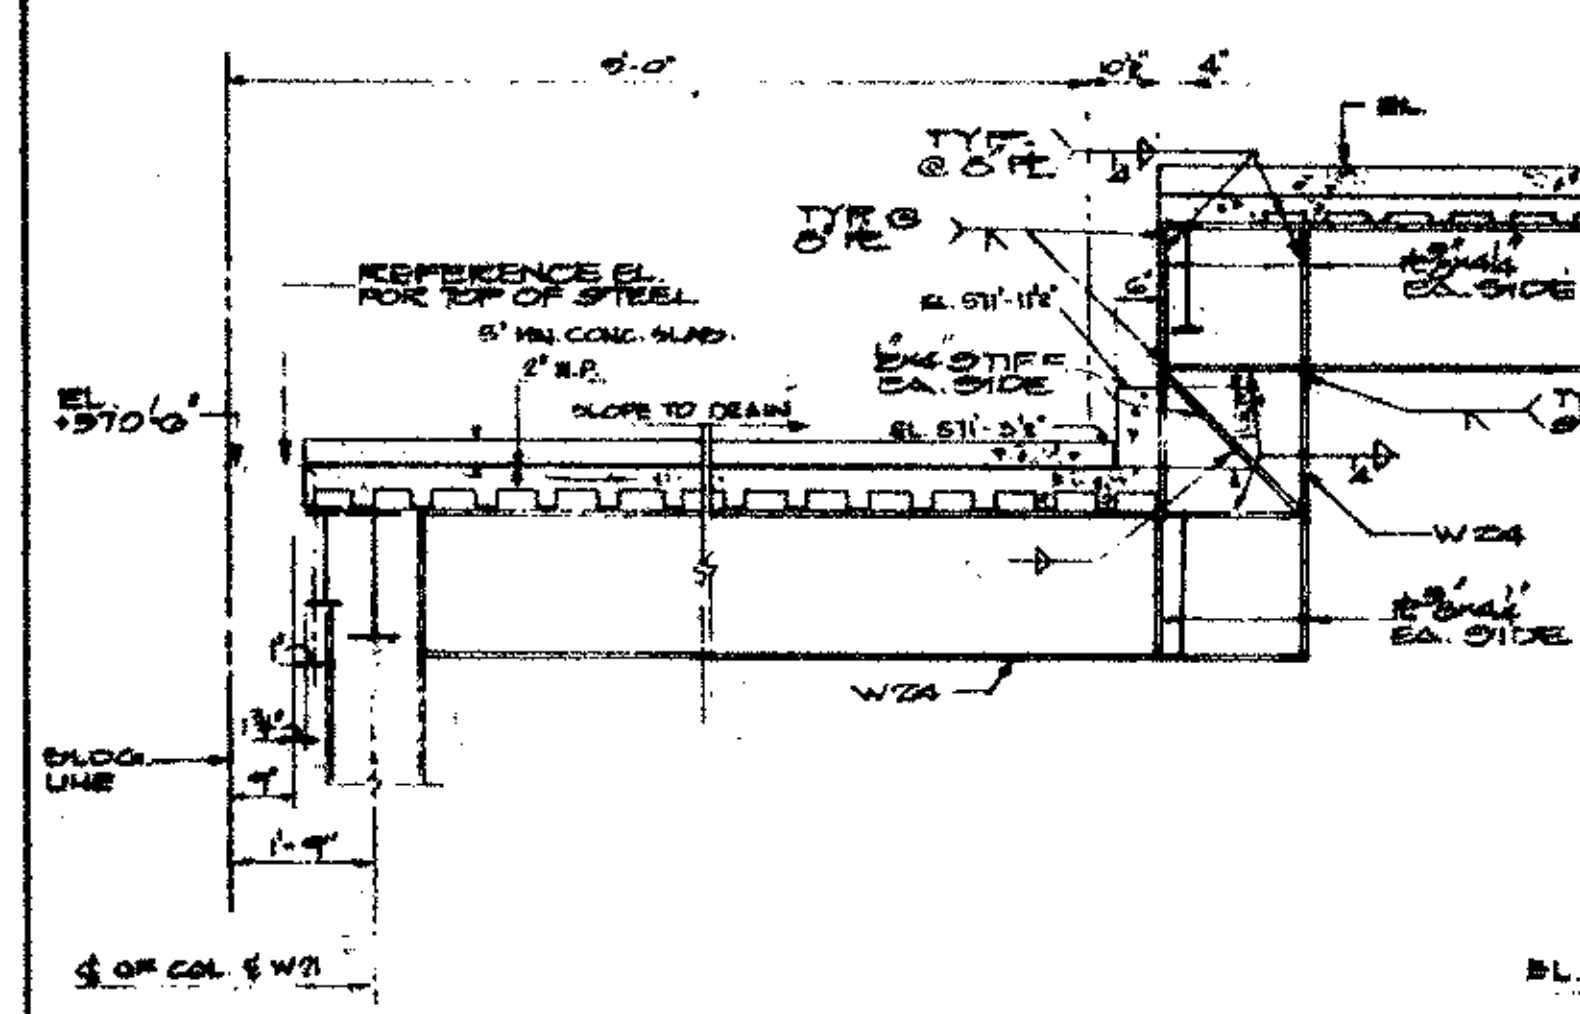



SECTION 1-1
SCALE: ½"=1'-0"

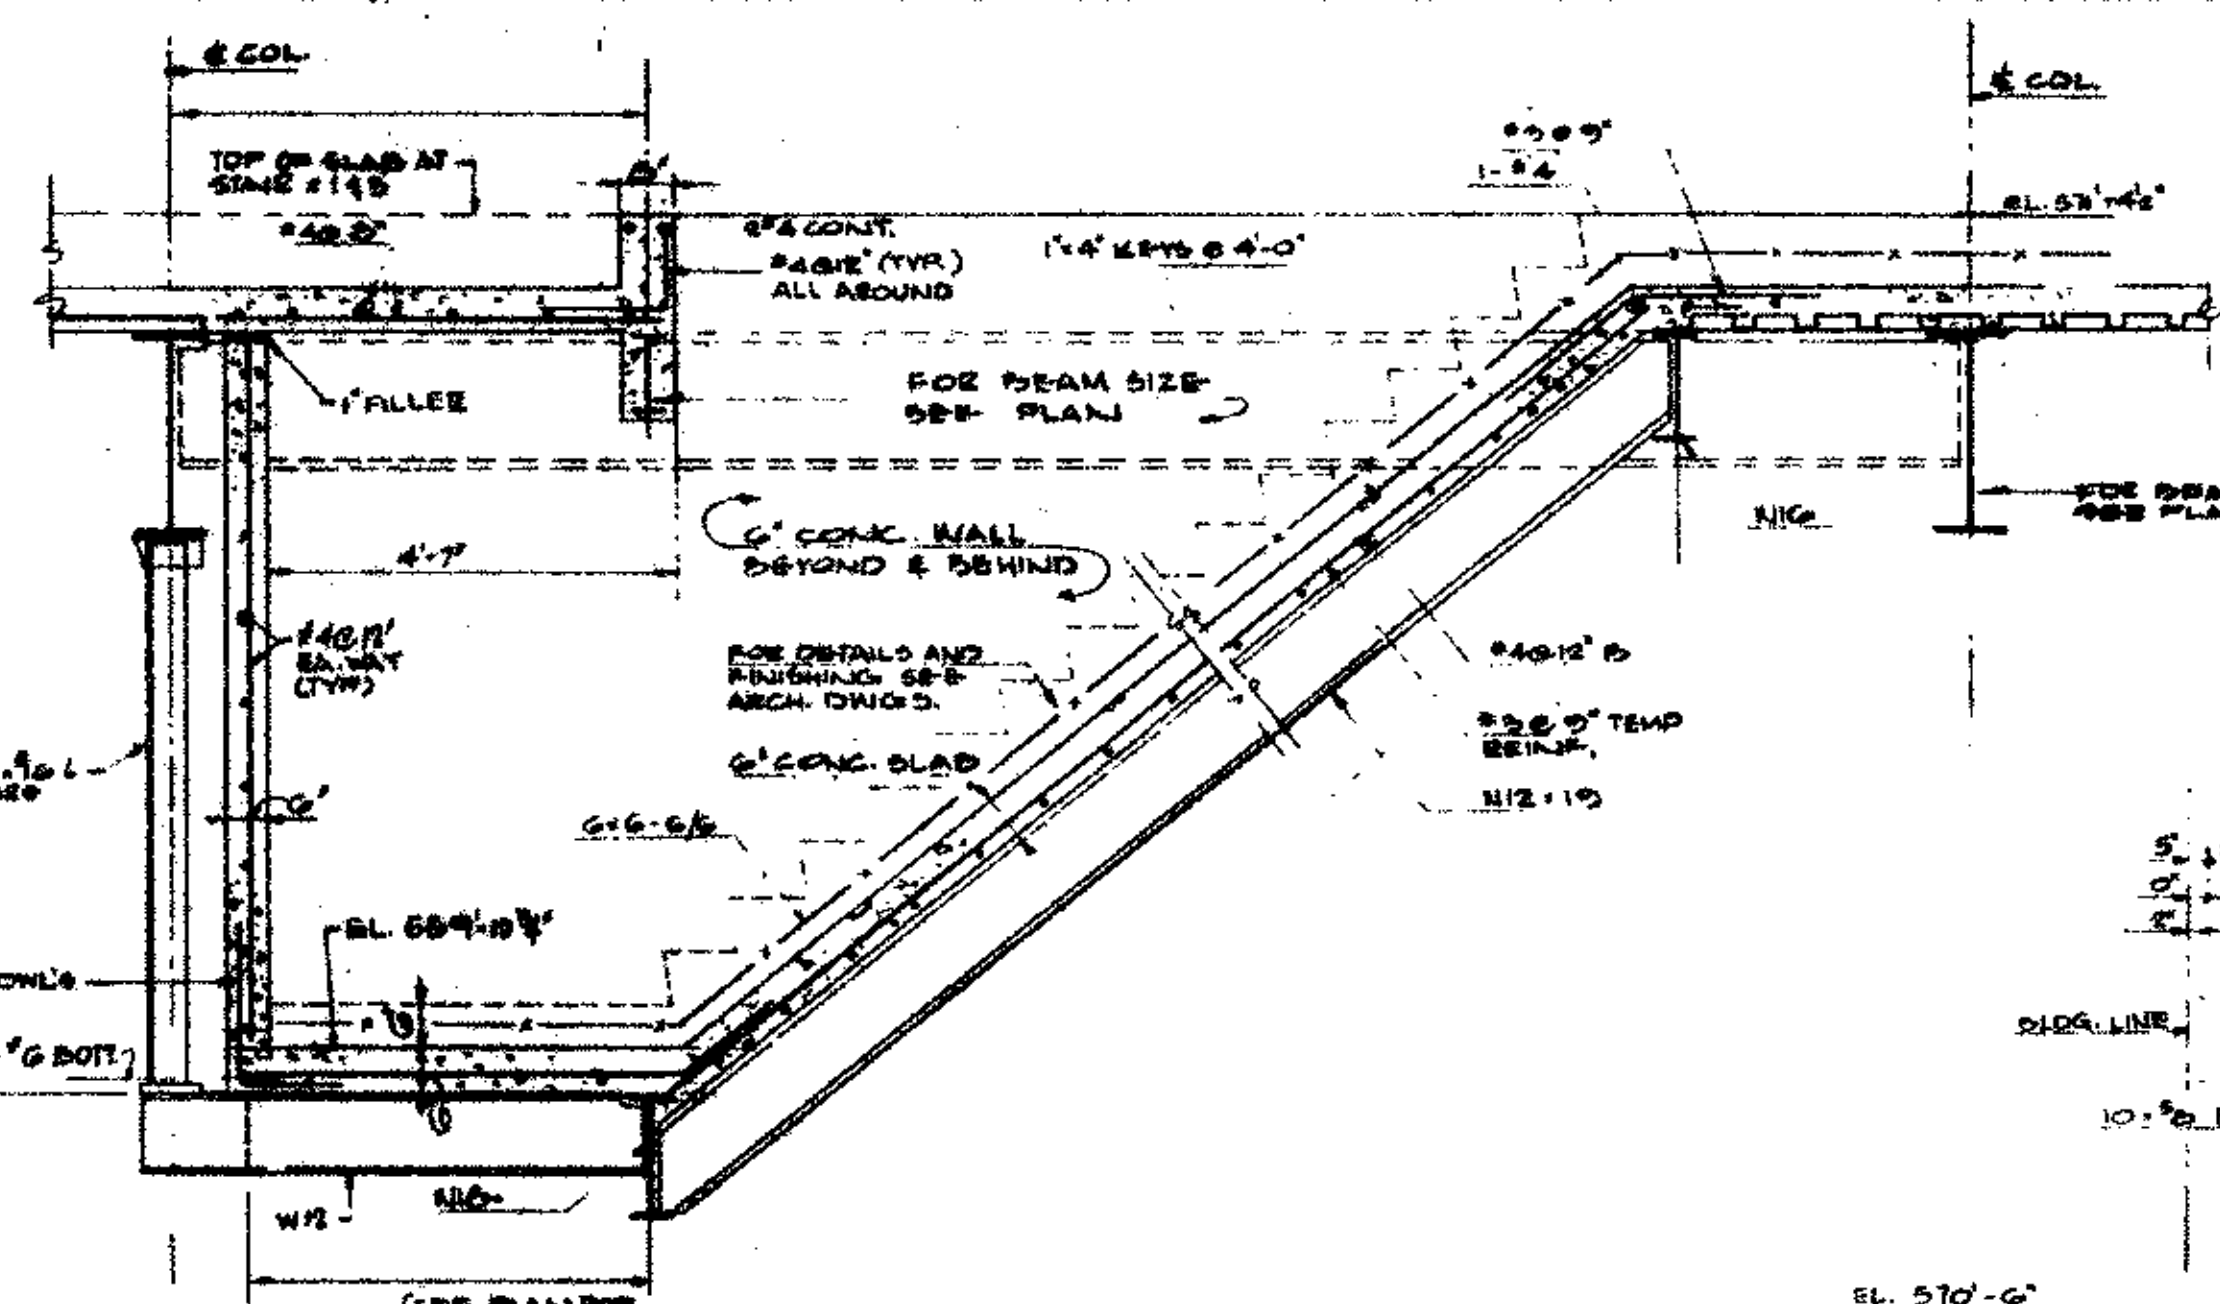


SECTION 3-3
SCALE: ½"=1'-0"

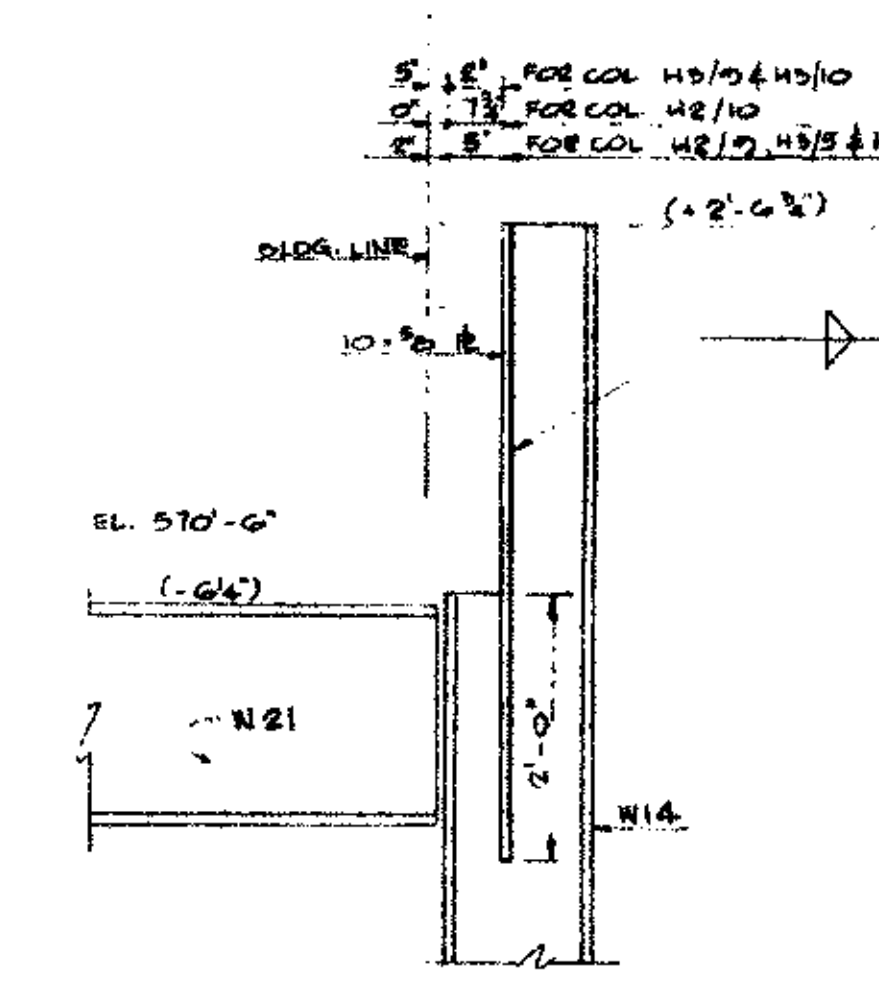


TYPICAL DETAILS AT COLUMNS
H2/9 & H3/9 - AS SHOWN
H2/10 & H3/10 - OPP. HAND

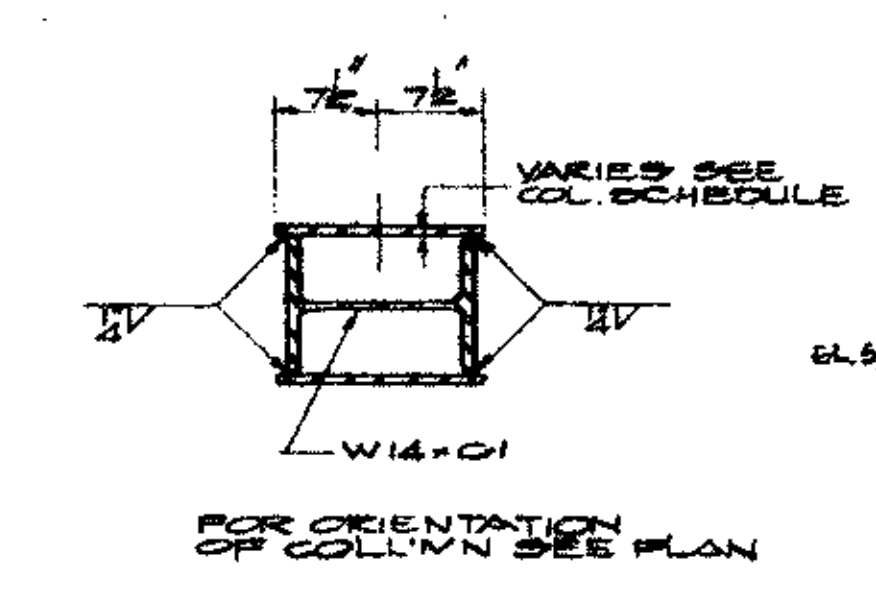


DETAIL 'X'
SCALE: 1"=1'-0"
(TYPICAL AT ROOF WIND BENTS)
SEE ASCO COL. SCHEDULE)

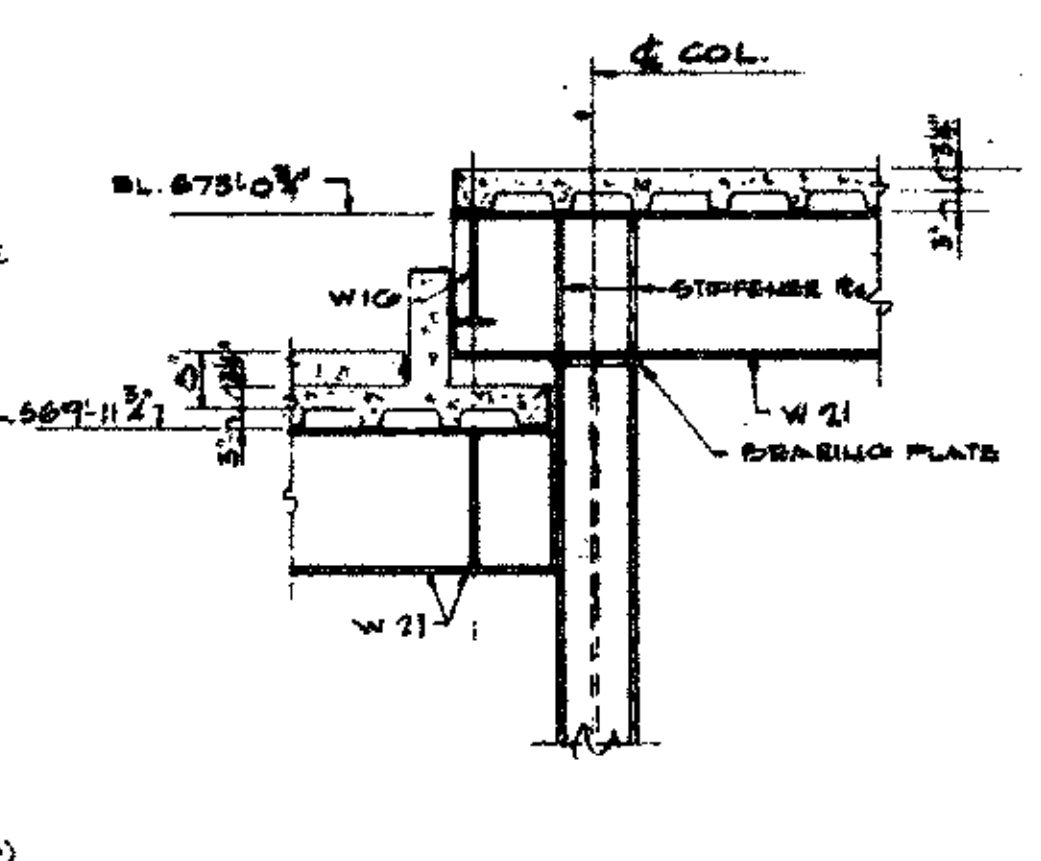


SECTION 4-4
SCALE: ½"=1'-0"

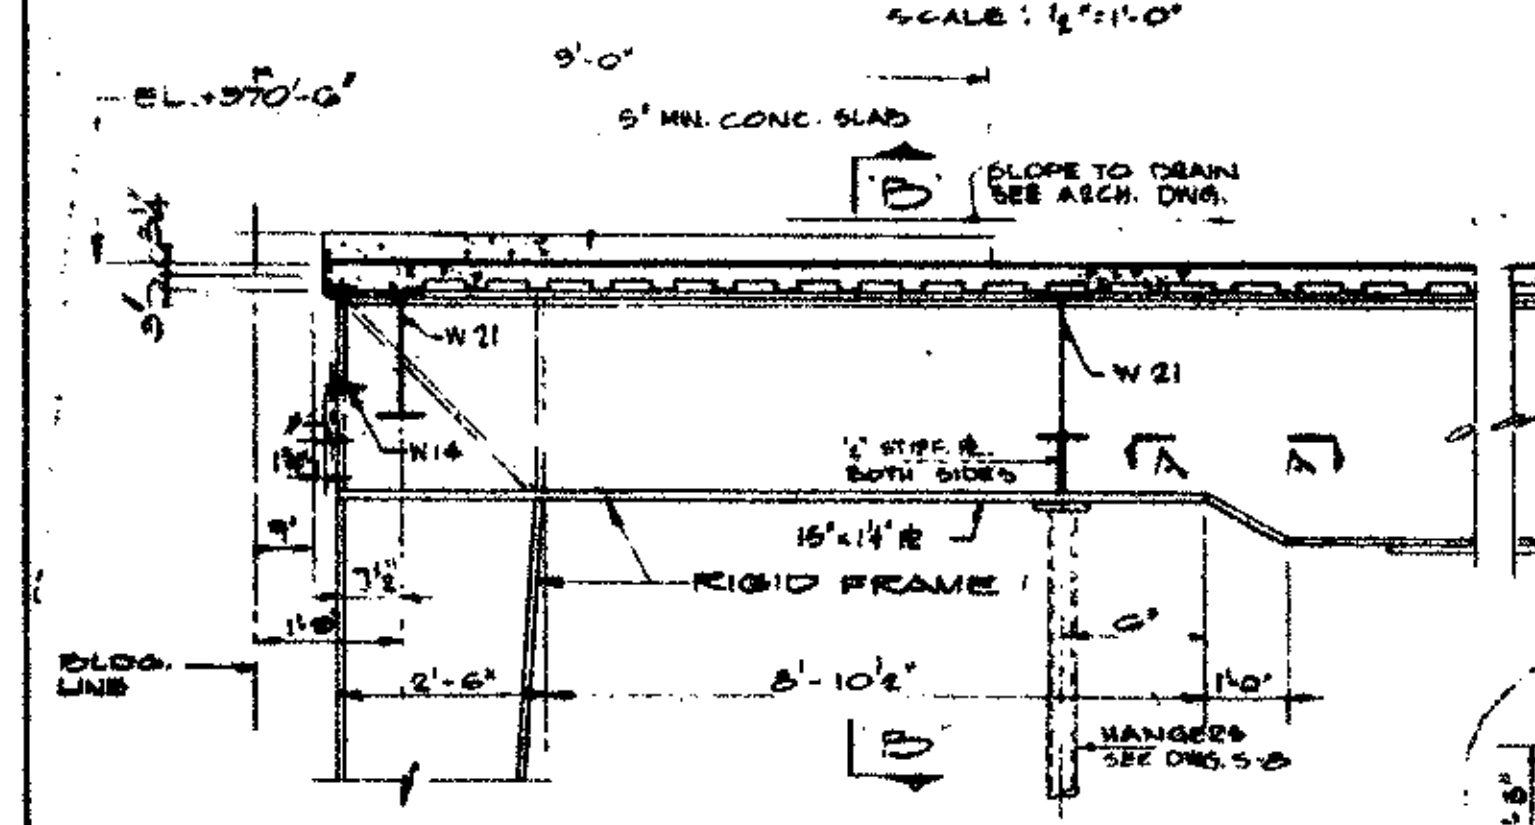


SECTION 2-2
SCALE: ½"=1'-0"

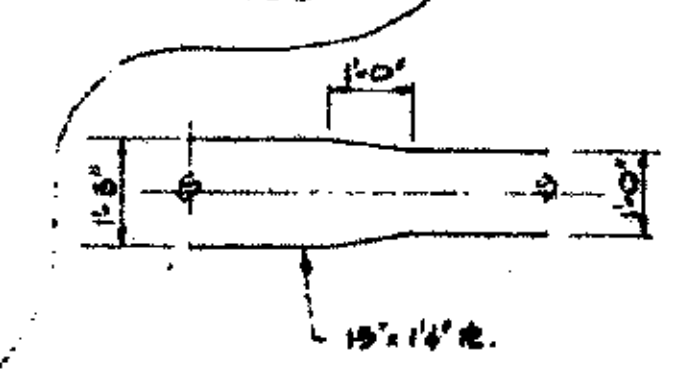


SECTION A-A
SCALE: ½"=1'-0"

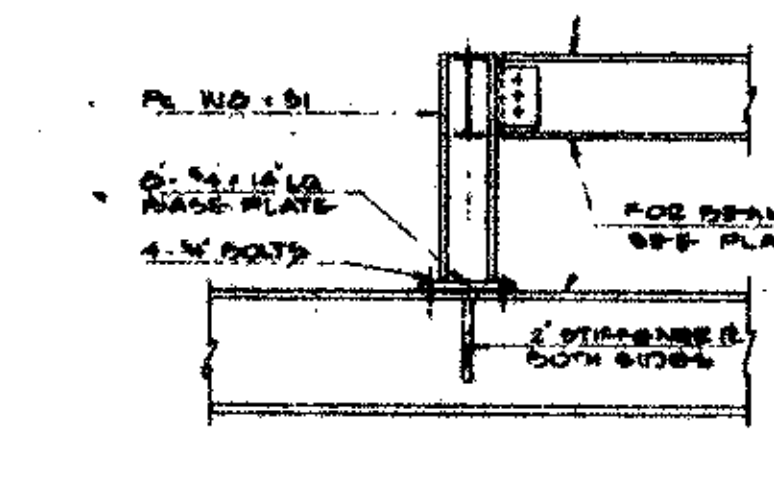

TYPICAL DETAIL AT PERIMETER OF BULKHEAD
SCALE: ½" = 1'-0"

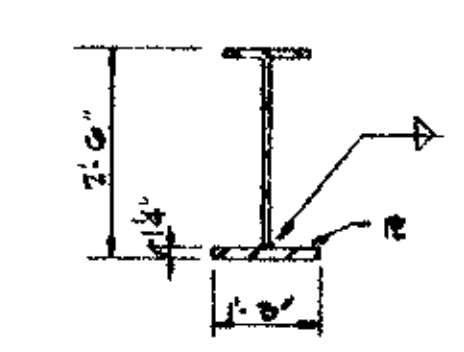


SECTION B-B
SCALE: ½"=1'-0"

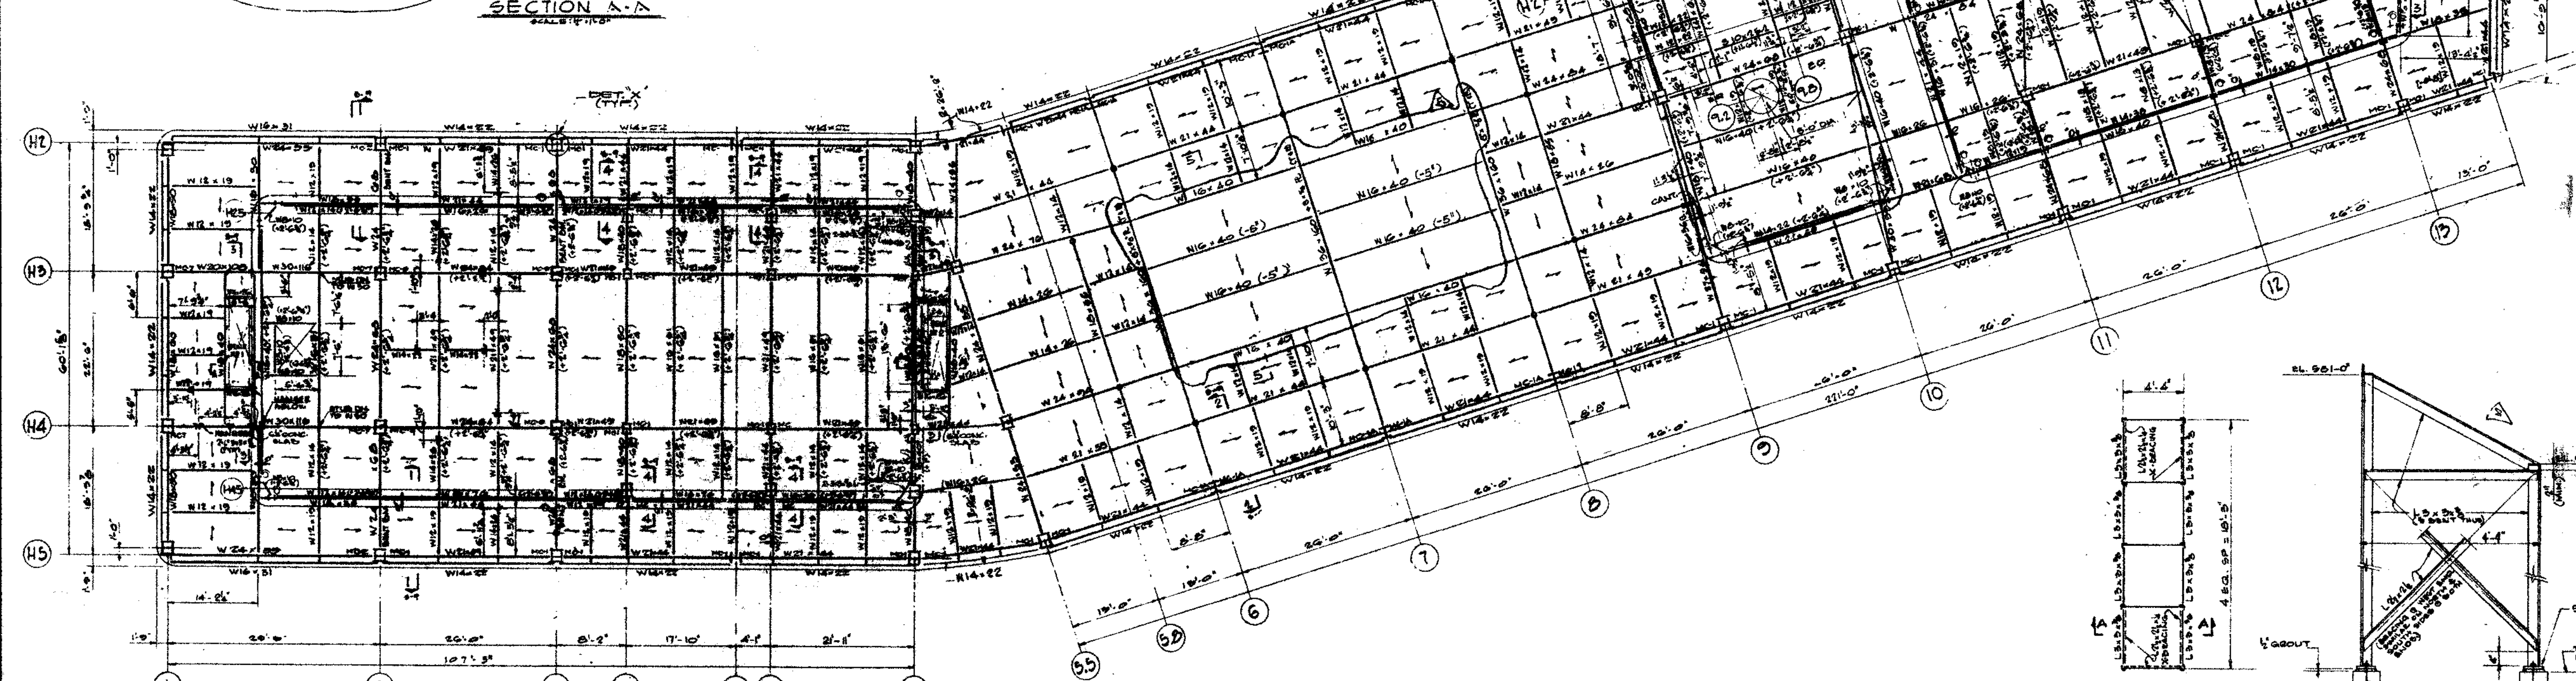

ROOF FRAMING PLAN
SCALE: ⅛"=1'-0"

1. ROOF DATUM ELEVATION 570'-6".
2. TOP OF SLAB ELEVATIONS ARE SHOWN ON ARCHITECTURAL DWG. A-10
3. TOP OF STEEL ELEVATION (-6½) FROM FINISHED DATUM ELEVATION UNLESS NOTED THUS ( ).
4. CONTRACTOR SHALL NOTIFY ARCHITECT OF ANY DISCREPANCIES BEFORE STARTING WORK.
5. N.F.P. INDICATES NO FIRE PROOFING.
6. ⟶ INDICATES DIRECTION OF METAL DECK.
7. METAL DECK SHALL BE U.S. DECK INC. "LOK-FLOOR", 20 GA., 3" DEEP, WITH WELDED WIRE FABRIC 6-6-1010
8. R = 3'-0" @ ALL CORNERS EXCEPT AS NOTED ON PLAN

LOADING SCHEDULE								
ITEM	AREAS: GENERAL	WINDOW WASHING						REMARKS
FLOOR SYSTEM	47	47						
ROOF & INSUL.	9	9						
FILL (AVE)	36	100*						*6" STONE CONC.
CEILING	10	10						
MECH. ELEC.	20	20						
TOTAL D.L.	122	186						*WINDOW WASHING RACK CONCENTRATIONS 3260 LBS AT 5'-0" O.C. OVER 6" SLAB.
LIVE LOAD	30	30*						
TOTAL L.	152	216						

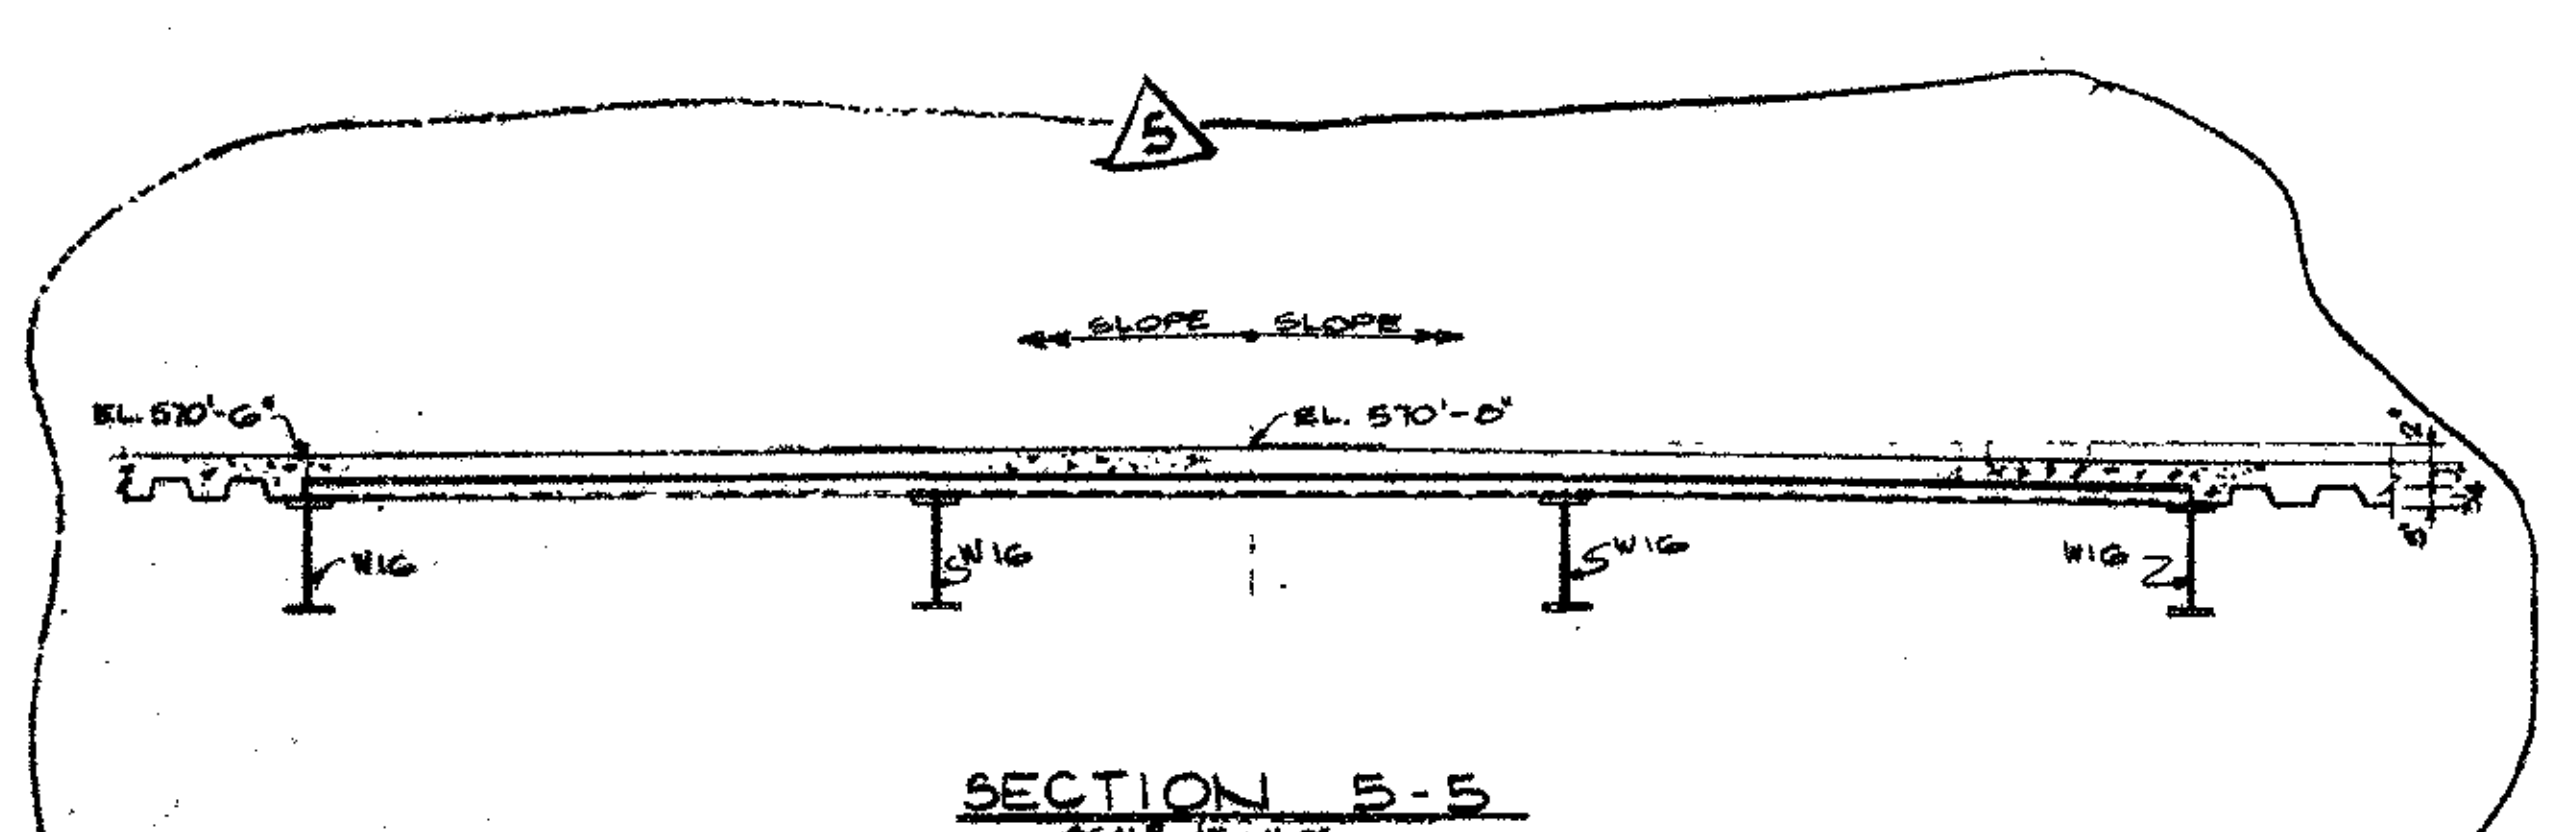

SECTION 5-5
SCALE ½"=1'-0"

ROOF PLAN
(STAIR BULKHEAD)
(STAIR #1, #2 AND #5)
(FOR ADD'L INFORMATION SEE ARCH. DWG.)
SCALE: ¼"=1'-0"

SECTION A-A
SCALE: ¾"=1'-0"

RECEIVED
FEB 8 1991
LESLIE E. ROBERTSON ASSOCIATES
211 EAST 46th ST., N.Y.C. 10017

A. 3/27/79 - See S-14

AS-BUILT DWGS

WORLD TRADE CENTER HOTEL
THE WORLD TRADE CENTER
NEW YORK NEW YORK

SKIDMORE, OWINGS & MERRILL
ARCHITECTS
400 PARK AVENUE, NEW YORK

WEISKOPF & PICKWORTH
STRUCTURAL ENGINEERS
200 PARK AVENUE, NEW YORK

JAROS, BAUM & BOLLES
MECHANICAL ENGINEERS
345 PARK AVENUE, NEW YORK

NO.	DATE	REVISIONS
8	7-17-79	SEE BULLETIN #39
7	6-27-79	SEE BULLETIN #32
6	5-30-79	SEE BULLETIN #19
	1-15-79	ISSUED FOR PORT AUTHORITY REVIEW.
5	1-15-79	BULLETIN #15
	1-3-79	ISSUED TO PORT AUTHORITY
1	12-28-78	SEE BULLETIN #14
	11-16-78	ISSUED TO PORT AUTHORITY
	10-5-78	GENERAL REVISION
	9-27-78	
	9-14-78	
	8-22-78	ISSUED FOR STRUCTURAL STEEL ONLY
	7-31-78	ISSUED FOR INFORMATION ONLY.

ROOF FRAMING PLAN

DATE: JUNE 1, 1978
SCALE:
DRAWING NO. S-9