WORLD TRADE CENTER HOTEL


THE WORLD TRADE CENTER
NEW YORK NEW YORK

SKIDMORE, OWINGS & MERRILL
ARCHITECTS
400 PARK AVENUE, NEW YORK


WEISKOPF & PICKWORTH
STRUCTURAL ENGINEERS -
300 PARK AVENUE, NEW YORK


JAROS, BAUM & BOLLES
MECHANICAL ENGINEERS
345 PARK AVENUE, NEW YORK


NOTE: FOR GLAZING AND ALUMINUM SEE SPECS SP 2 & SP 13D

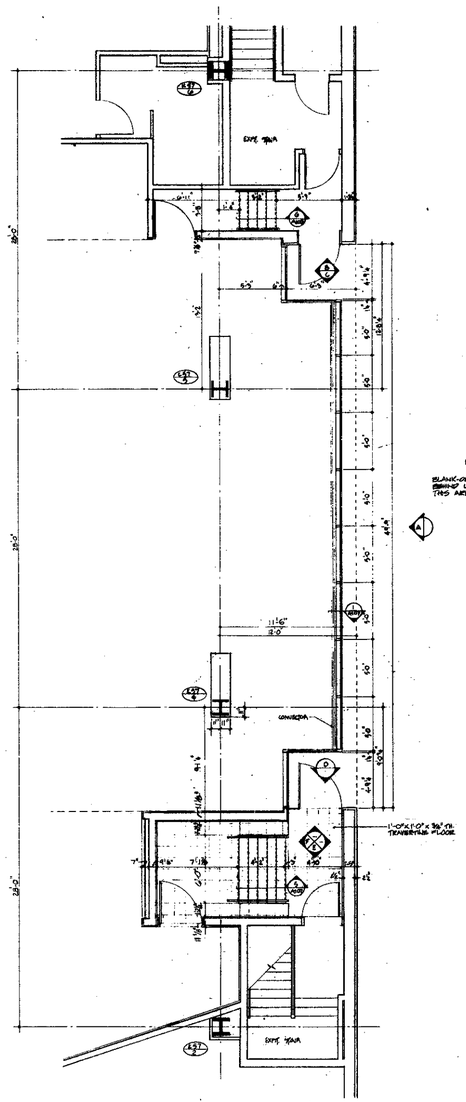


2 BAR PLAN
¼"=1'-0"

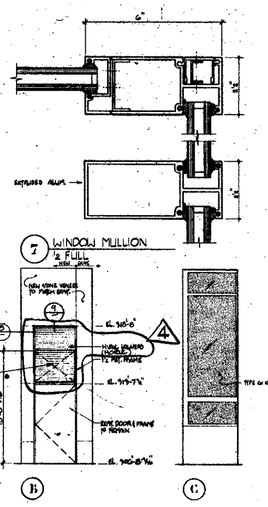


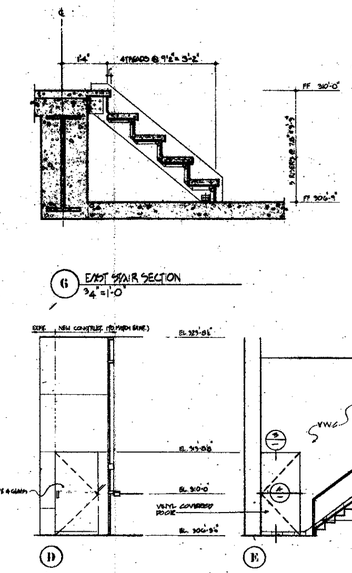

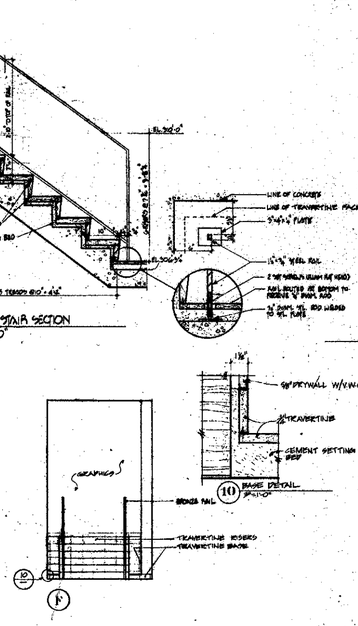

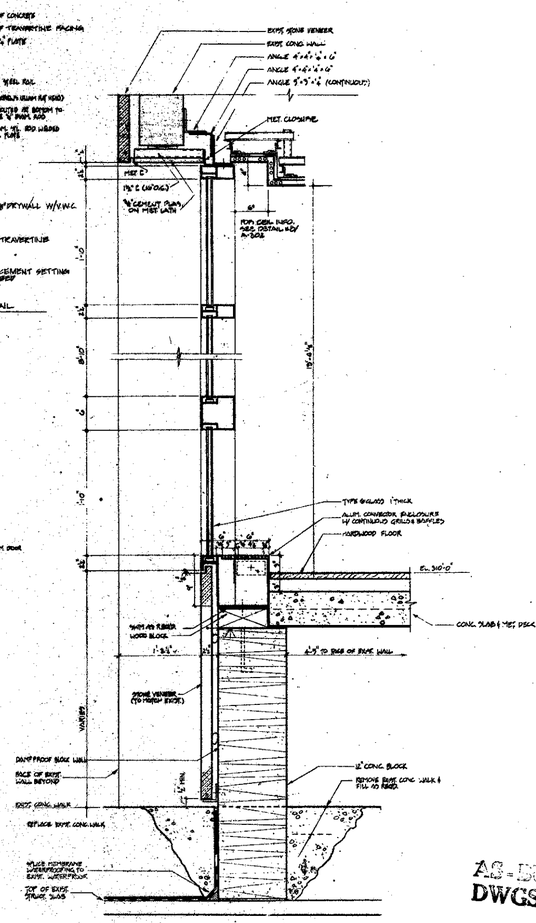

9 SECTION THRU LOUVER

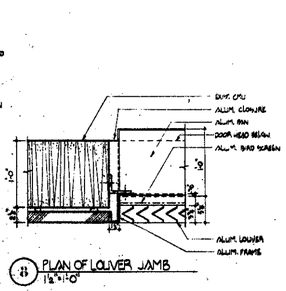

8 PLAN OF LOUVER JAMB
1½"=1'-0"

NO.	DATE	REVISIONS
4	9-9-80	BULLETIN #91
3	5-2880	BULLETIN #81
2	4-15-77	BULLETIN #79
1	5-1979	ISSUED FOR CONSTRUCTION

AS-BUILT DWGS

BAR EXTERIOR DETAILS

DATE 5-12-77
SCALE
DRAWING NO. A-107
PROJECT NO. 5482

RECEIVED
NOV 19 1992
LESLIE E. ROBERTSON ASSOCIATES
211 E. 46th ST., N.Y., N.Y.C. 10017