

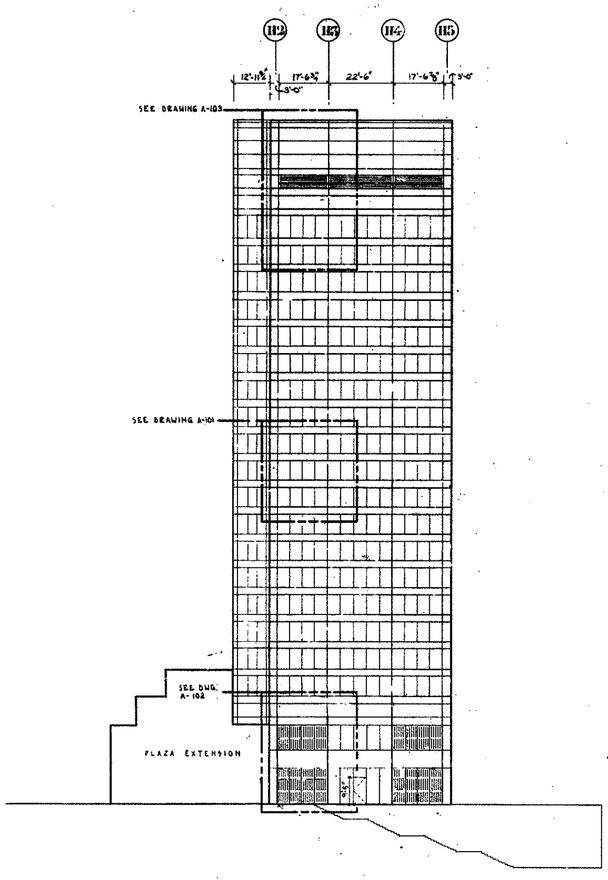


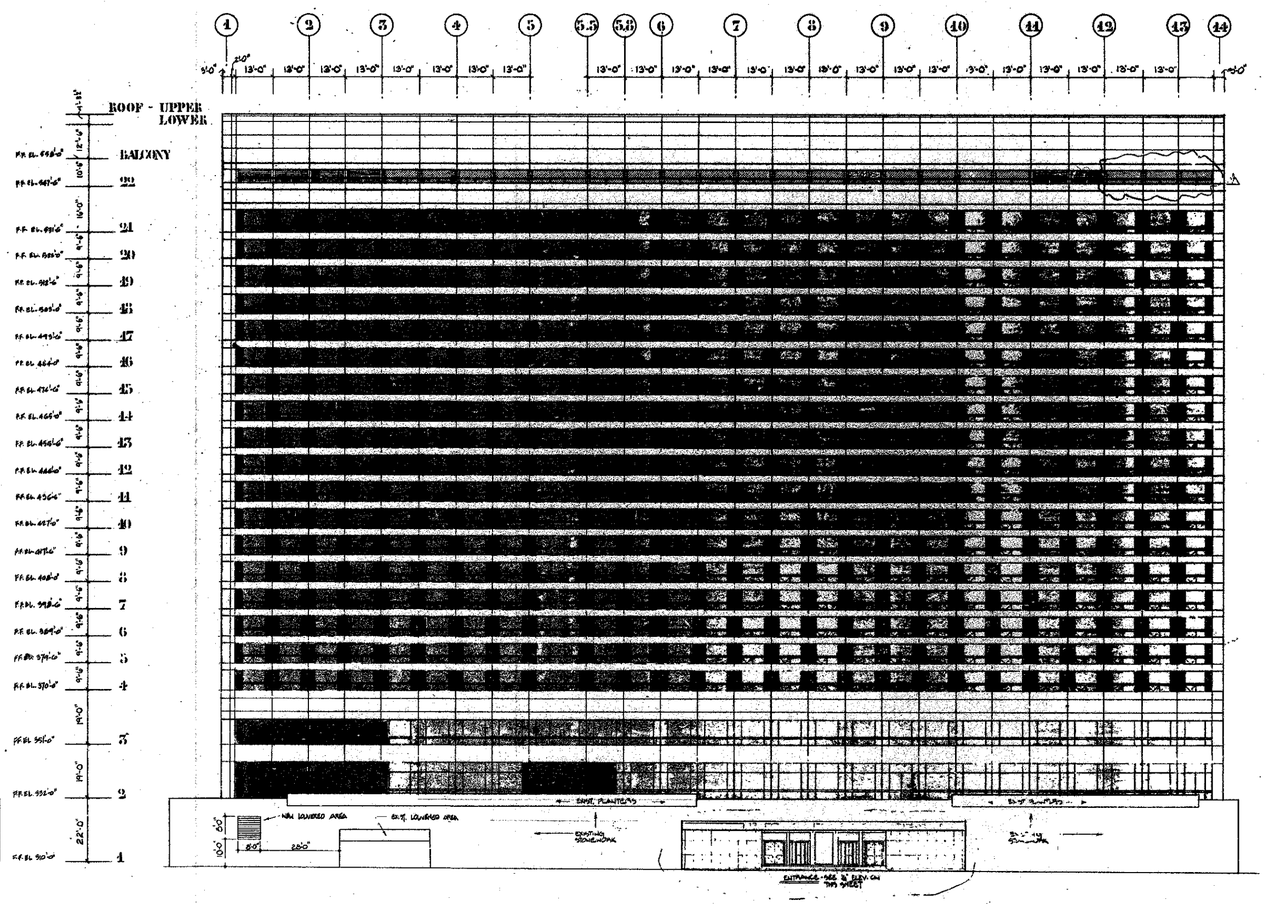


NORTH ELEVATION (DEVELOPED)

WEST ELEVATION (DEVELOPED)

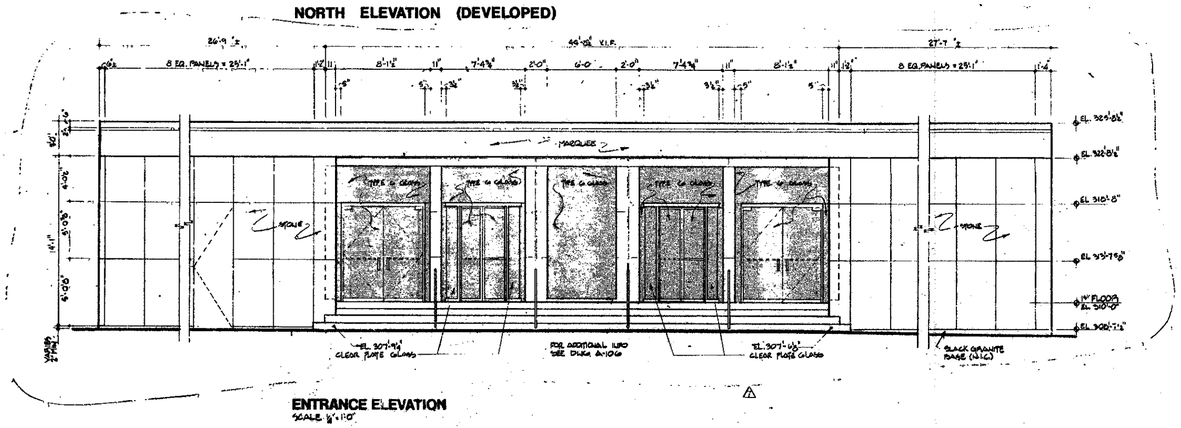

ENTRANCE ELEVATION
SCALE 1/8"=1'-0"

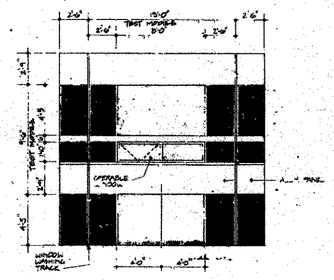

EXTENT OF MOCK-UP
SCALE 1/4"=1'-0"

LEGEND

- TYPE 1 GLASS
- TYPE 2 GLASS
- TYPE 6 GLASS
- TYPE 7 GLASS
- TYPE 8 GLASS
- ALUM. PANEL CUT-OUT
- LOUVERS

NO.	DATE	REVISIONS
1	9-2-76	ISSUED FOR PORT AUTHORITY REVIEW
2	9-27-76	ISSUED FOR CONSTRUCTION
3	2-6-78	ADDENDUM #5 (WINDOW WALL)
4	1-15-79	ISSUED FOR PORT AUTHORITY REVIEW
5	11-23-78	MOCK-UP ADDENDUM 1
6	11-7-78	WINDOW WALL SECTION ISSUED FOR WINDOW WALL SHOP DWG ONLY
	6-25-79	

AS-BUILT DWGS

NORTH & WEST ELEVATIONS

DATE 6-23-78
SCALE 1/8"=1'-0"
DRAWING NO. A-11
PROJECT NO. 1402

RECEIVED
NOV 19 1992
LESLIE E. ROBERTSON ASSOCIATES

1-41 x 1-41