


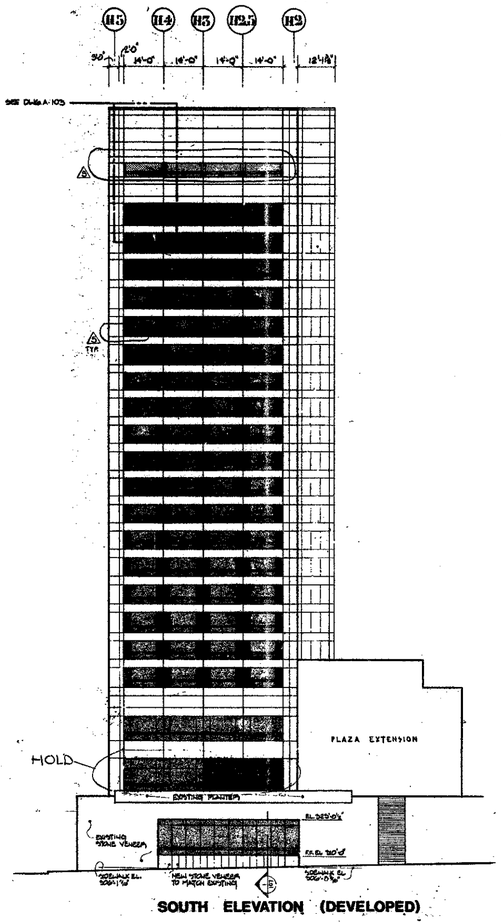


SOUTH ELEVATION (DEVELOPED)

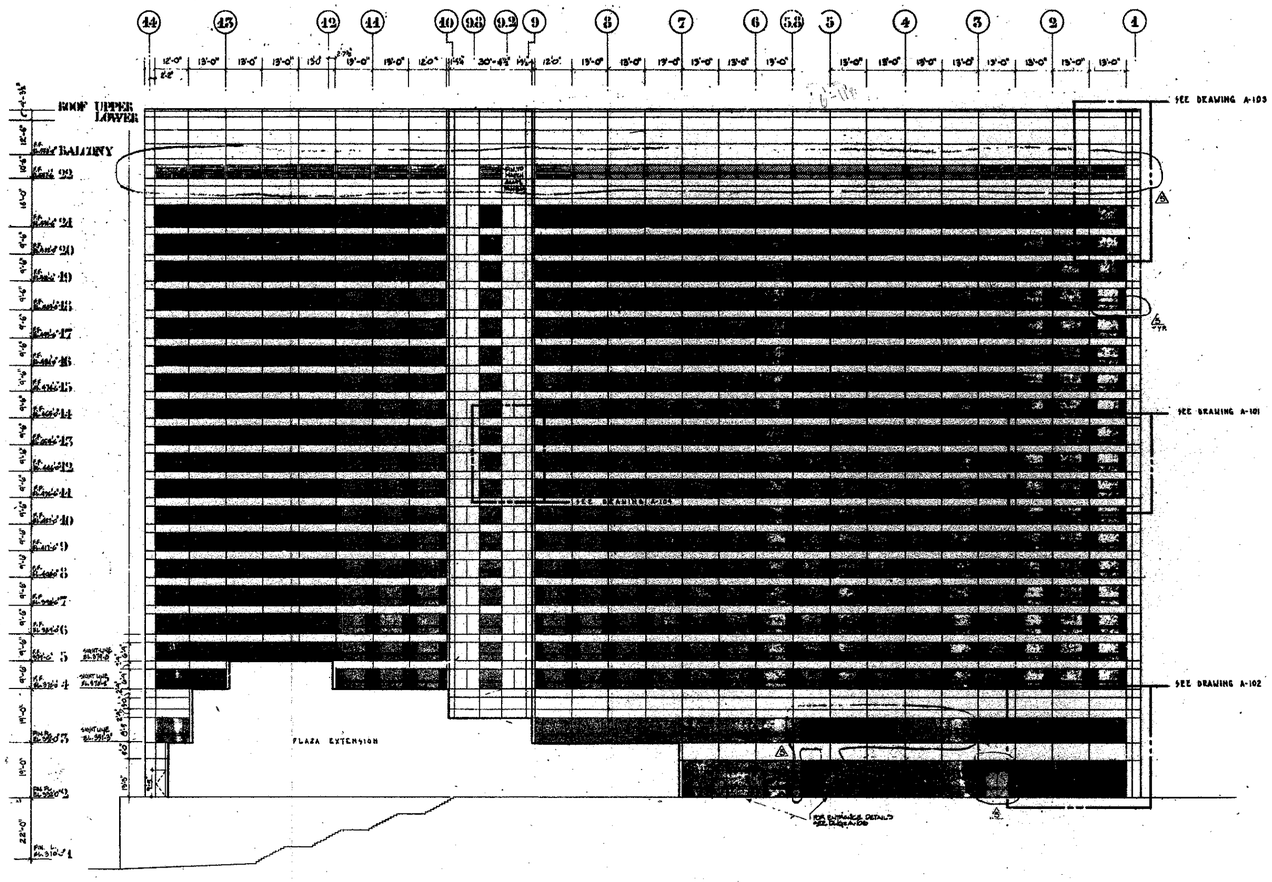

EAST ELEVATION (DEVELOPED)

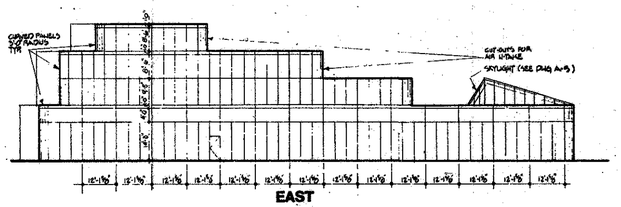

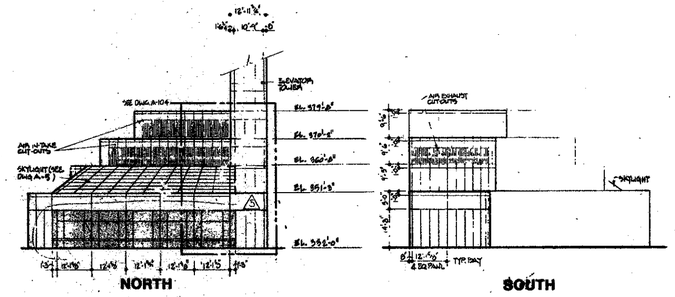

PLAZA EXTENSION ELEVATIONS

AS-BUILT DWGS

WORLD TRADE CENTER HOTEL

THE WORLD TRADE CENTER
NEW YORK NEW YORK

SKIDMORE, OWINGS & MERRILL
ARCHITECTS
400 PARK AVENUE, NEW YORK

WEIDLINGER ASSOCIATES
STRUCTURAL ENGINEERS
333 PARK AVENUE, NEW YORK

JAROS, BAUM & BOLLES
MECHANICAL ENGINEERS
345 PARK AVENUE, NEW YORK

LEGEND

- TYPE 1 GLASS
- TYPE 2 GLASS
- TYPE 6 GLASS
- TYPE 7 GLASS
- TYPE 8 GLASS
- ALUM. PANEL CUT-OUT
- LOUVERS

NO.	DATE	REVISIONS
1	5-2-79	BULLETIN #25
2	5-18-79	ISSUED FOR CONSTRUCTION
3	8-6-79	ADDENDUM #5 (WINDOW WALL)
4	1-15-79	ISSUED FOR PORT AUTHORITY PERMIT
5	11-17-80	WINDOW WALL ADDENDUM 1 GENERAL REVISIONS
	6-23-82	ISSUED FOR WINDOW WALL SHOPDWG ONLY

SOUTH, EAST, & PLAZA EXTENSION ELEVATIONS

DATE 6-23-82
SCALE 1/16"-1'-0"
DRAWING NO. A-12

RECEIVED
NOV 19 1992

LESLIE E. ROBERTSON ASSOCIATES
211 E. 46th ST., N.Y., N.Y.C. 10017