
WORLD TRADE CENTER HOTEL

THE WORLD TRADE CENTER
NEW YORK, NEW YORK

SKIDMORE, OWINGS & MERRILL
ARCHITECTS
400 PARK AVENUE, NEW YORK

WEIDLINGER ASSOCIATES
STRUCTURAL ENGINEERS
333 PARK AVENUE, NEW YORK

JAROS, BAUM & BOLLES
MECHANICAL ENGINEERS
245 PARK AVENUE, NEW YORK

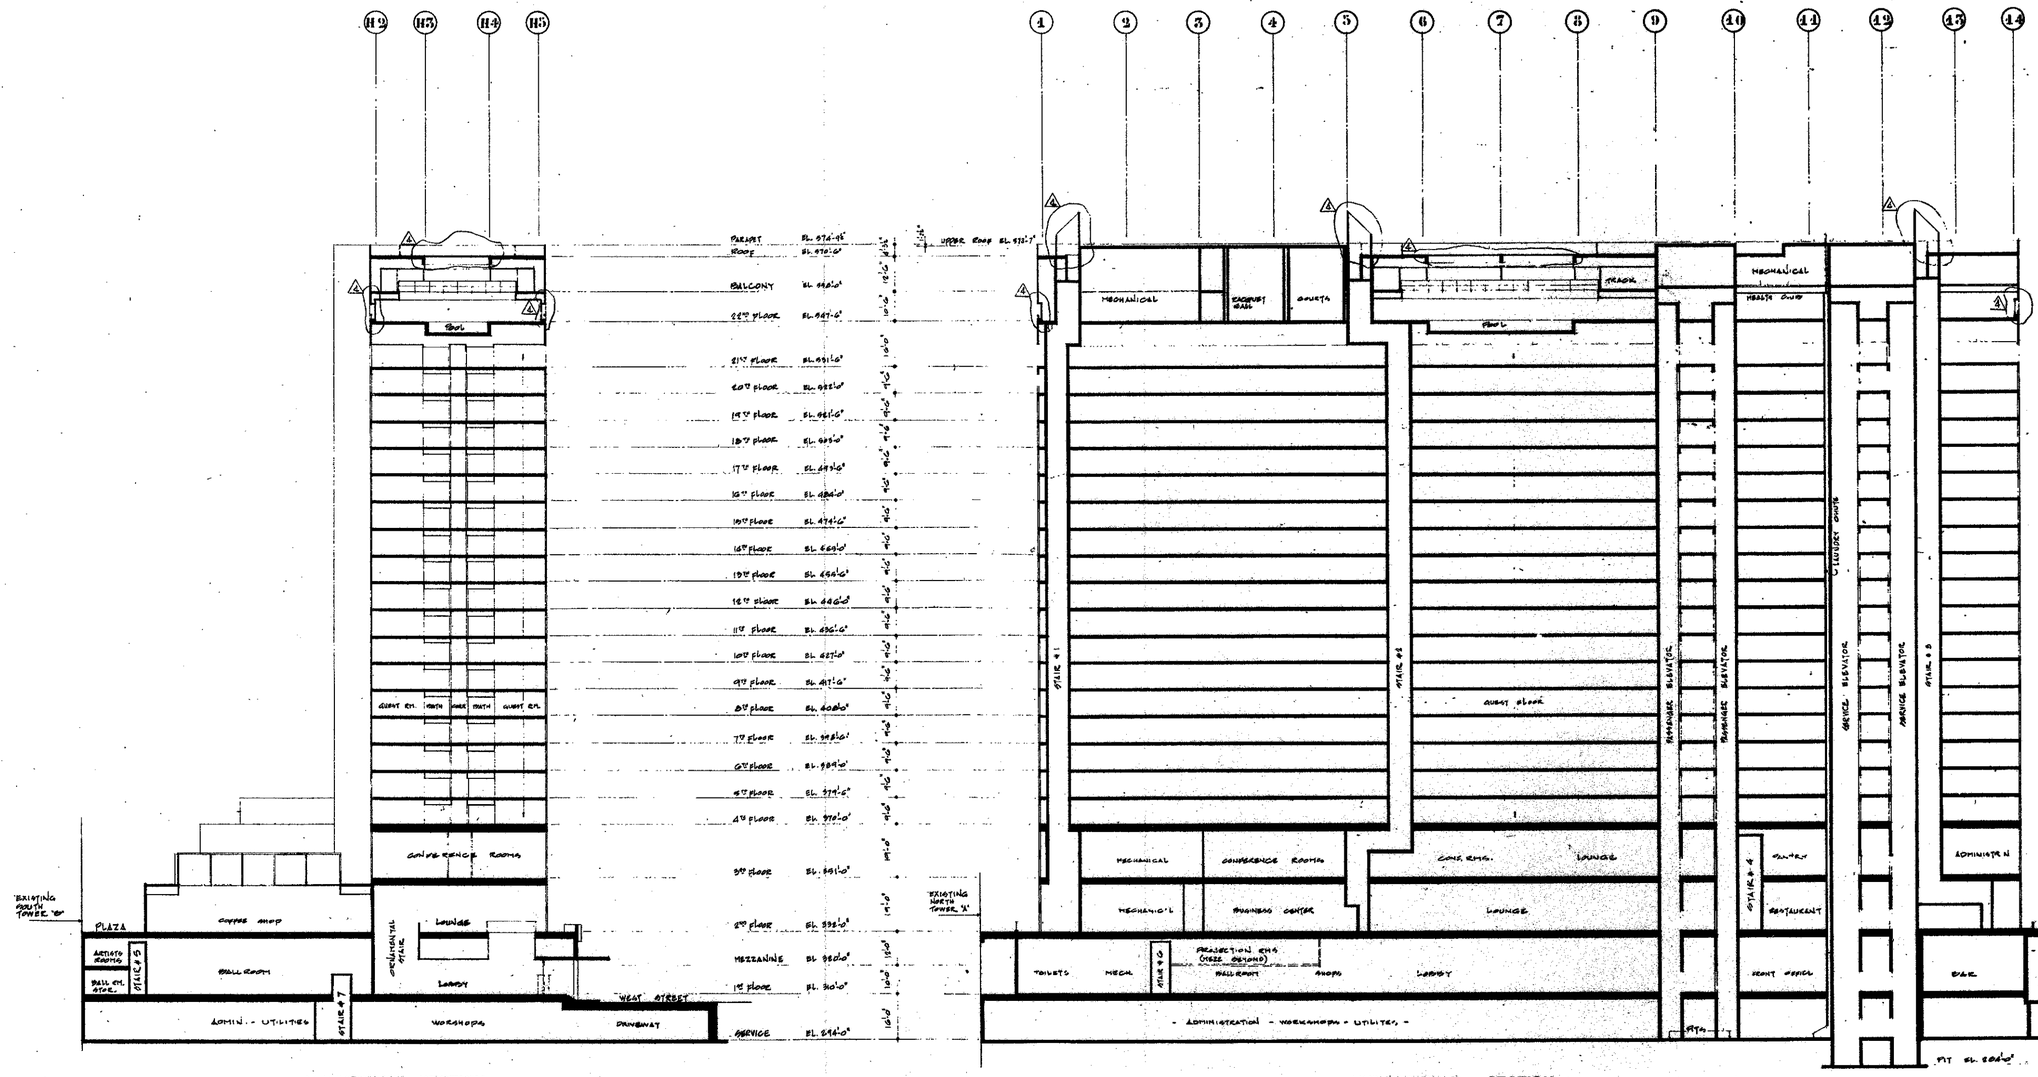

TRANSVERSE SECTION

LONGITUDINAL SECTION

AS-BUILT DWGS

NO.	DATE	REVISIONS
5	3-27-79	GENERAL REVISION ISSUED FOR CONSTRUCTION
2	1-15-79	ISSUED FOR PRELIMINARY BIDDING
1	8-21-78	ISSUED FOR PASSENGER BIDDING ONLY
		ISSUED FOR STEEL FAN STAIR DIPPING ONLY

LONGITUDINAL & TRANSVERSE SECTIONS

DATE 7-26-78
SCALE 1/16"-1'-0"
DRAWING NO. A-13

RECEIVED
NOV 19 1992

LESLIE E. ROBERTSON
ASSOCIATES
211 E. 46th ST., N.Y., N.Y.C. 10017