

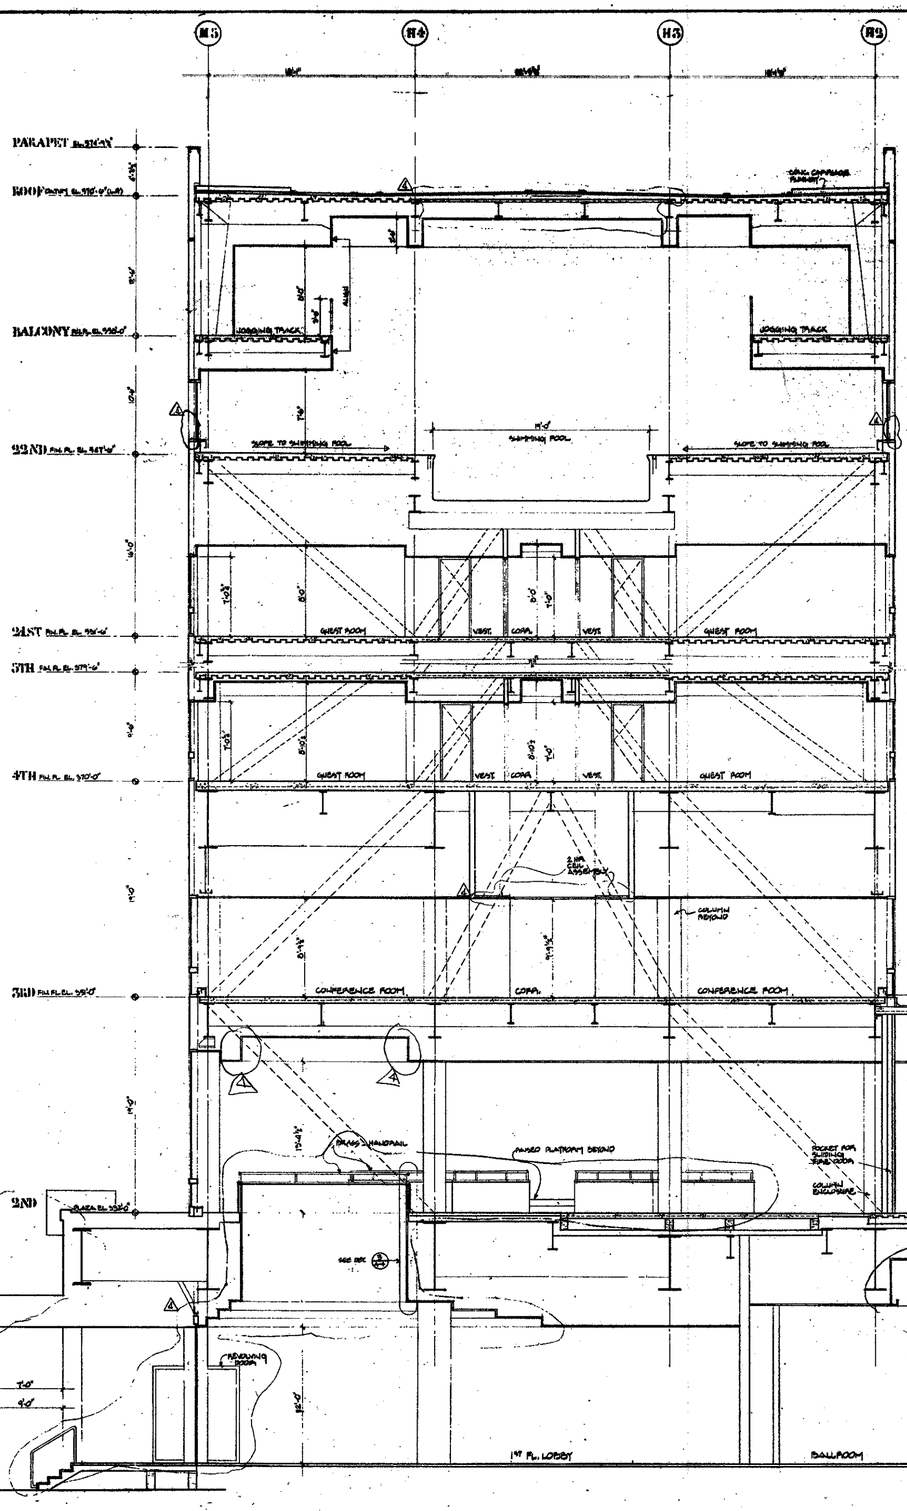


1 TRANSVERSE BUILDING SECTION
3/32" = 1'-0"

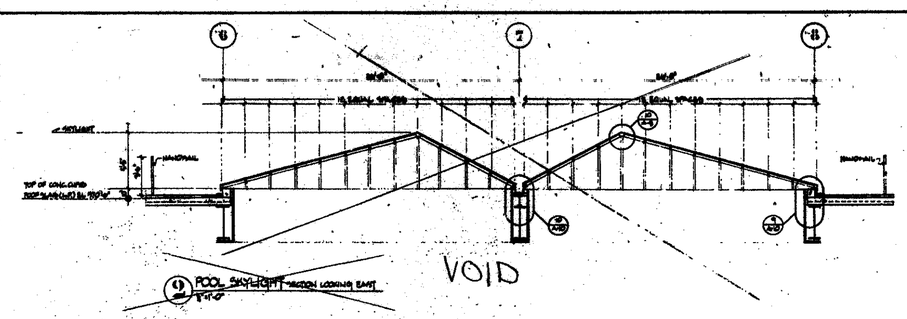

2 POOL SKYLIGHT SECTION LOOKING EAST
3/16" = 1'-0"

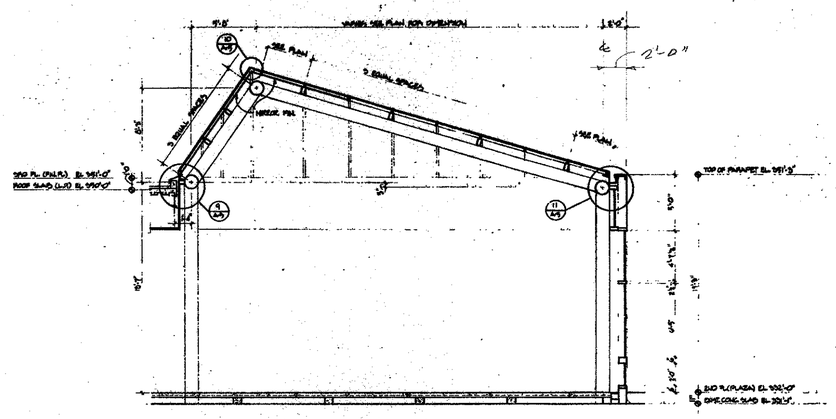

3 COFFEE SHOP SKYLIGHT SECTION LOOKING WEST
3/16" = 1'-0"

WORLD TRADE CENTER HOTEL

THE WORLD TRADE CENTER
NEW YORK, N.Y.




NO.	DATE	REMARKS

ENLARGED TRANSVERSE SECTION & SKYLIGHT SECTIONS

DATE 12-15-78
DRAWING NO A-14
SCALE 1/16" = 1'-0"
PROJECT NO. 7908

AS-BUILT DWGS

A-14

RECEIVED
NOV 19 1992
LESLIE E. ROBERTSON
ASSOCIATES
211 E. 46th ST., N.Y., N.Y.C. 10017