
# WORLD TRADE CENTER HOTEL


THE WORLD TRADE CENTER
NEW YORK, NEW YORK

SKIDMORE, OWINGS & MERRILL
ARCHITECTS
220 PARK AVENUE, NEW YORK

WEIDLINGER ASSOCIATES
STRUCTURAL ENGINEERS
220 PARK AVENUE, NEW YORK

JAROS, BAUM & BOLLES
MECHANICAL ENGINEERS
220 PARK AVENUE, NEW YORK

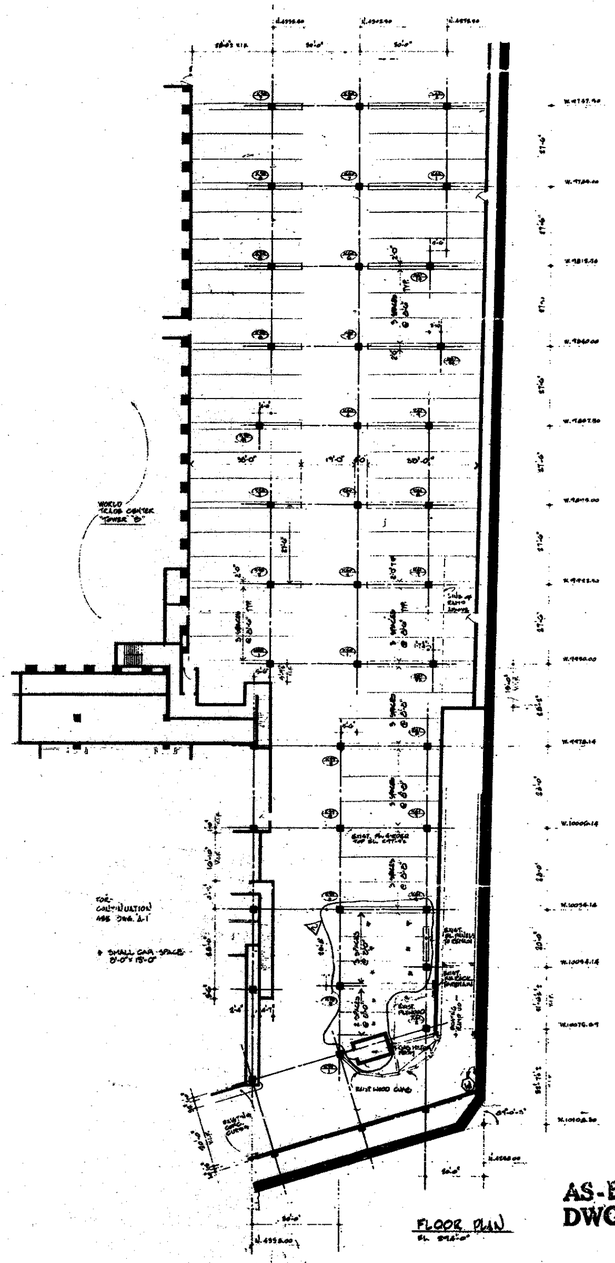

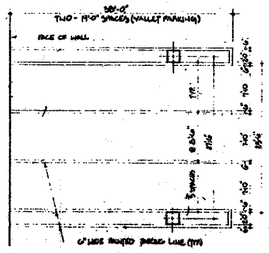
TYPICAL PARKING SPACE LAYOUT
3/8" = 1'-0"

AS-BUILT DWGS

| NO. | DATE | REVISIONS |
|---|---|---|
| 2 | 4-23-91 | |
| 1 | 1-16-91 | LIMITED PILES KEY SYSTEMS |

PARKING GARAGE
AT SERVICE LEVEL

APRIL 29, 1991
1/16" = 1'-0"
A-1A

RECEIVED
NOV 19 1992
LESLIE E. ROBERTSON
ASSOCIATES
211 E. 46th ST., N.Y., N.Y.C. 10017