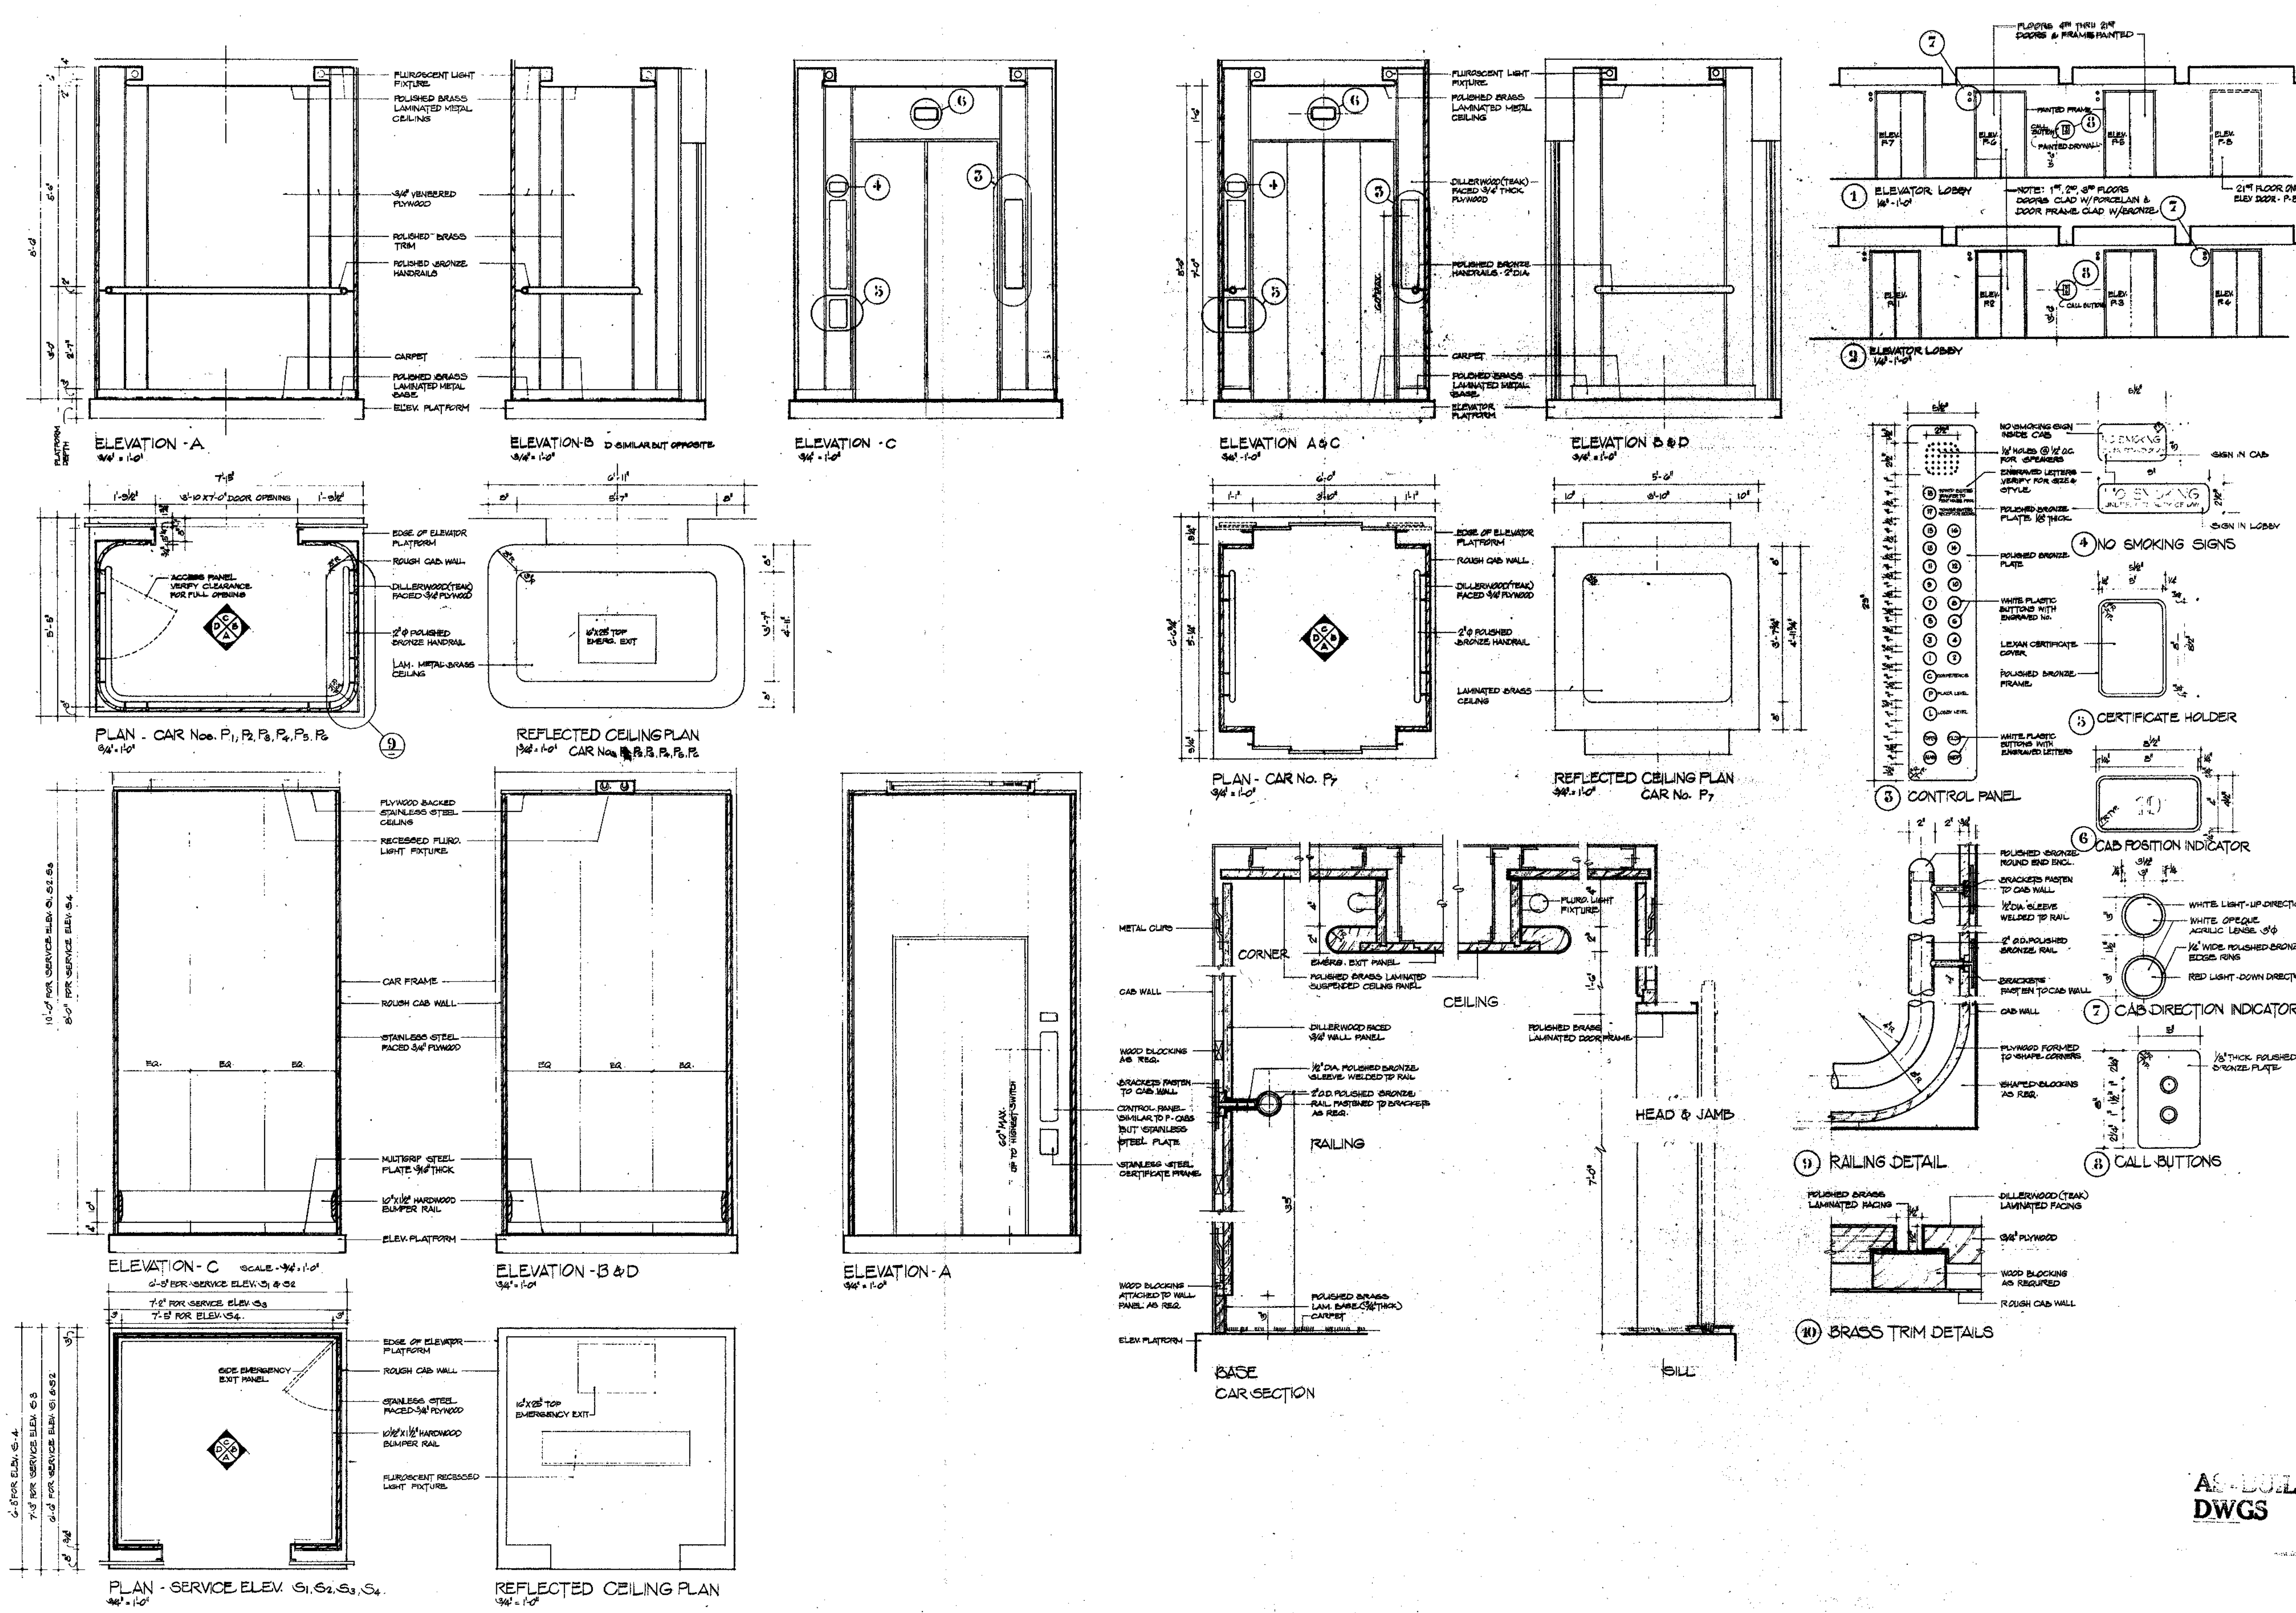


WORLD TRADE CENTER HOTEL

THE WORLD TRADE CENTER
NEW YORK NEW YORK

SKIDMORE, OWINGS & MERRILL
ARCHITECTS
400 PARK AVENUE, NEW YORK

WEISKOPF & PICKWORTH
STRUCTURAL ENGINEERS
200 PARK AVENUE, NEW YORK

JAROS, BAUM & BOLLES
MECHANICAL ENGINEERS
345 PARK AVENUE, NEW YORK

NO.	DATE	REVISIONS
		BULLETIN No. 34

AS-BUILT DWGS

TITLE: ELEVATOR CAB DETAILS

DATE	DRAWN BY	DRAWING NO.
6/29/73		A-204B
SCALE: AS SHOWN	CHECKED BY	PROJECT NO. 1407-030

RECEIVED
NOV 19 1992
LESLIE E. ROBERTSON
ASSOCIATES
211 E. 46th ST., N.Y., N.Y.C. 10017