


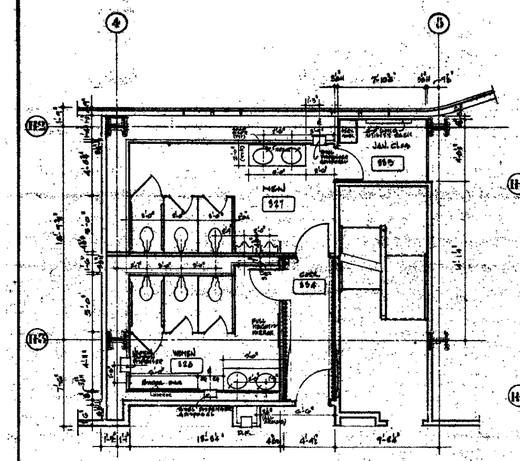


PART PLAN 5TH FLR. SEE DWG. A-9
SPACES 557 - 558 - 556 - 559

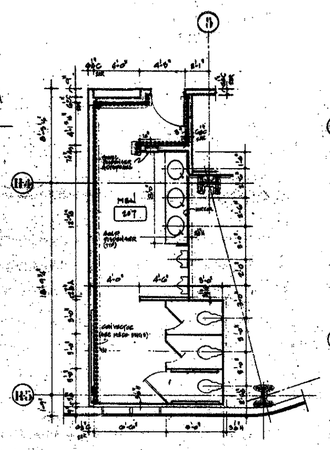



PART PLANS 4TH FLR. SEE DWG. A-8
SPACES 457 - 459

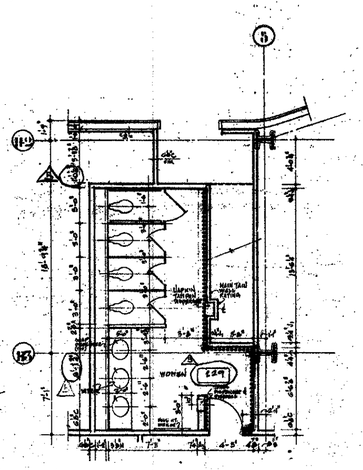

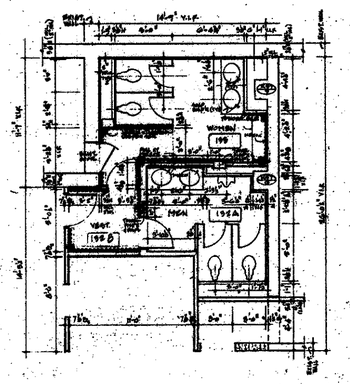


PART PLANS 1ST FLR. SEE DWG. A-6
SPACES 111A - 113 - 114 - 114A & 154 - 155A - 155

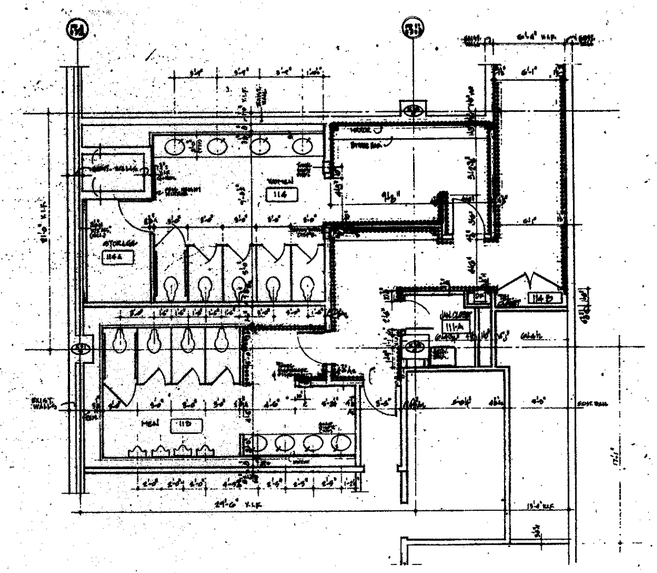


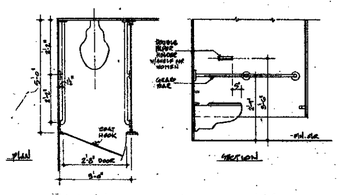


TOILET ENCLOSURE FOR HANDICAPPED 1/4"=1'-0"

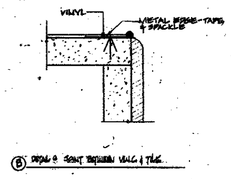


Ⓑ DETAIL @ SEAT BETWEEN WALL & TILE

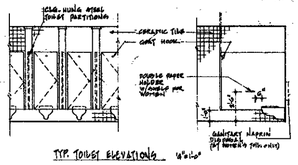


TYP. TOILET ELEVATIONS 1/4"=1'-0"

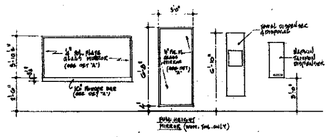


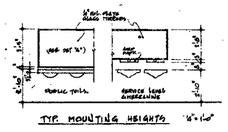


TYP. MOUNTING HEIGHTS 1/4"=1'-0"

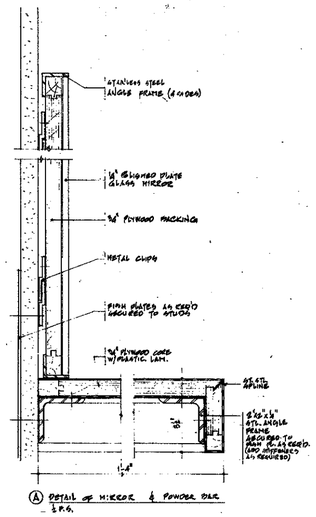


Ⓐ DETAIL OF MIRROR & POWDER RIB
1 1/2"=1'-0"

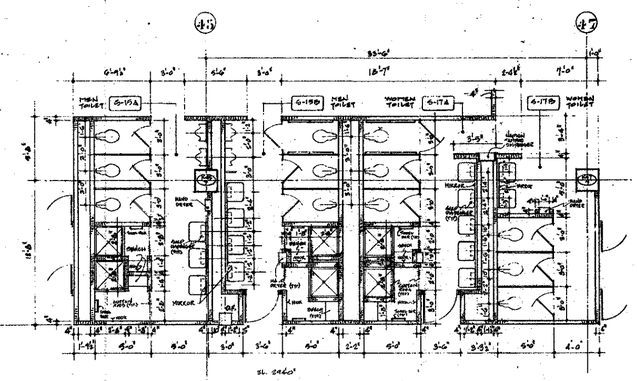

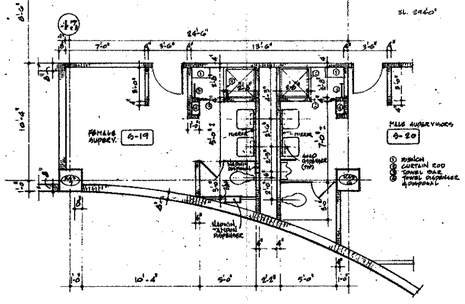

PART PLANS SERVICE LEVEL SEE DWG. A-1
SPACES # S-19A, S-19B, S-17A, S-17B, S-17, S-20

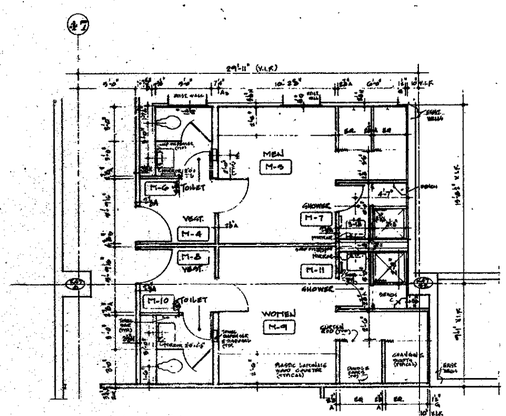

PART PLAN MEZZANINE SEE DWG. A-5
SPACES M-4 - M-11

WORLD TRADE CENTER HOTEL

THE WORLD TRADE CENTER
NEW YORK NEW YORK

SKIDMORE, OWINGS & MERRILL
ARCHITECTS
400 PARK AVENUE, NEW YORK

WEIDLINGER & PICKWORTH
STRUCTURAL ENGINEERS
205 PARK AVENUE, NEW YORK

JAROS, BAUM & BOLLES
MECHANICAL ENGINEERS
245 PARK AVENUE, NEW YORK

LEGEND
NEW WALL CONSTRUCTION

NO.	DATE	REVISIONS
5	4-18-80	BULLETIN #179
4	12-17-79	BULLETIN #150
3	10-3-79	BULLETIN # 68
2	9-2-79	BULLETIN NO 25
1	5-15-79	ISSUED FOR CONSTRUCTION
	4-13-79	ISSUED FOR PORT AUTHORITY REVIEW

AS-BUILT DWGS
ENLARGED TOILET PLANS

DATE L-15-79
SCALE 1/8"=1'-0"
DRAWING NO. A-213
PROJECT NO. 7901

9-213

RECEIVED
NOV 19 1992

LESLIE E. ROBERTSON
ASSOCIATES
211 E. 46th ST., N.Y., N.Y.C. 10017