




5 RACQUETBALL COURT - DOOR ELEVATION
1" = 1'-0"

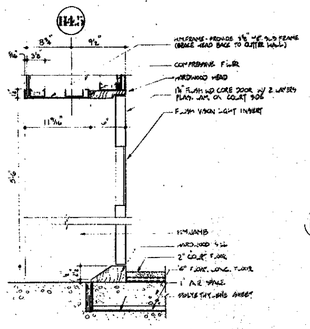


4 RACQUETBALL COURT - DOOR SECTION
1½" = 1'-0"

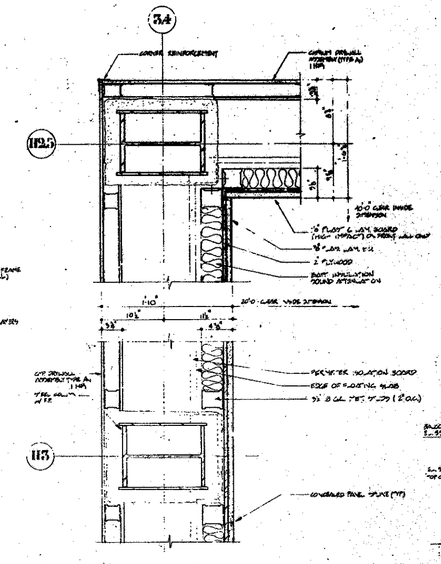

2 RACQUETBALL COURT - PLAN DETAILS
1½" = 1'-0"

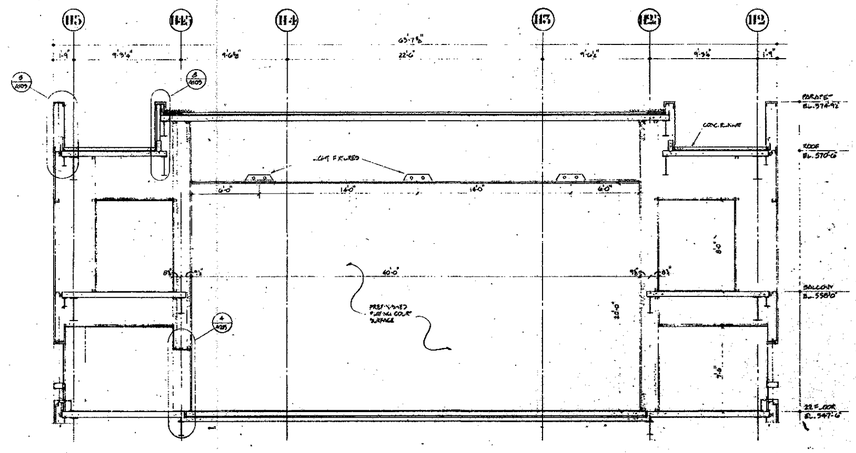

3 RACQUETBALL COURT LONGITUDINAL SECTION
1/4" = 1'-0"

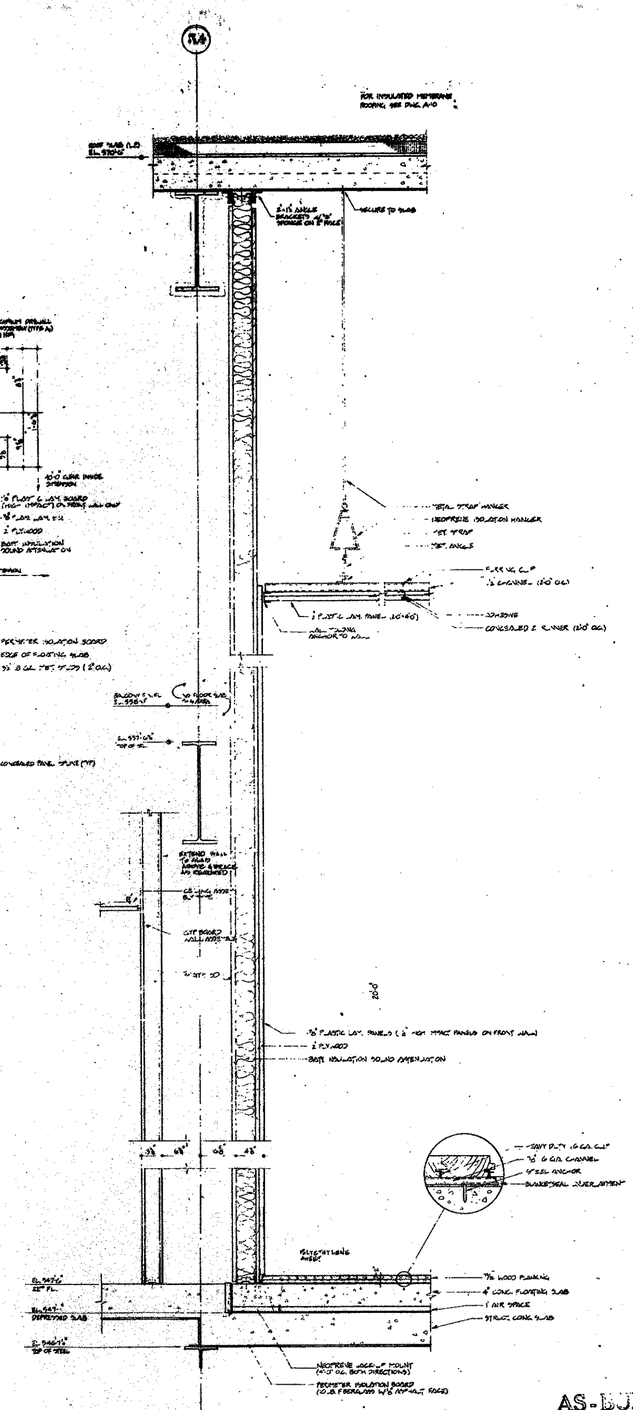

1 RACQUETBALL COURT WALL SECTION
1½" = 1'-0"

AS-BUILT DWGS

WORLD TRADE CENTER HOTEL

THE WORLD TRADE CENTER
NEW YORK NEW YORK

SKIDMORE, OWINGS & MERRILL
ARCHITECTS
400 PARK AVENUE, NEW YORK

WEIDLINGER & PICKWORTH
STRUCTURAL ENGINEERS
200 PARK AVENUE, NEW YORK

JAROS, BAUM & BOLLES
MECHANICAL ENGINEERS
245 PARK AVENUE, NEW YORK

NO.	DATE	REVISIONS
9	12-17-80	HEALTH CLUB, HOME BULLETIN # 100
8	9-2-79	ISSUED AS NOTED #25
7	9-12-79	ISSUED FOR CONSTRUCTION
6	8-3-79	ISSUED FOR PERMIT AUTHORITY REVISION

RACQUETBALL COURT
DETAILS

DATE 11-15-79
SCALE AS NOTED
DRAWING NO. A-215
PROJECT NO. 1008

RECEIVED
NOV 19 1992
LESLIE E. ROBERTSON ASSOCIATES
211 E. 46th ST., N.Y., N.Y.C. 10017