

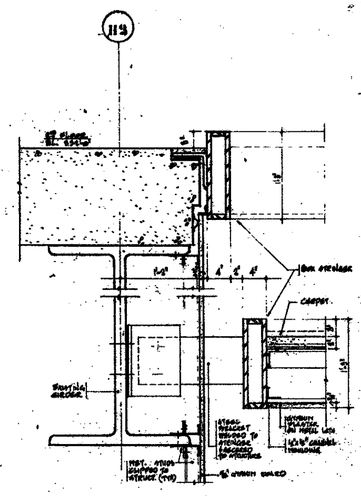



DETAIL "3"

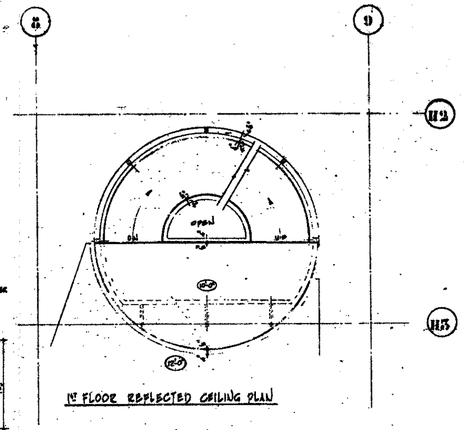


1st FLOOR REFLECTED CEILING PLAN

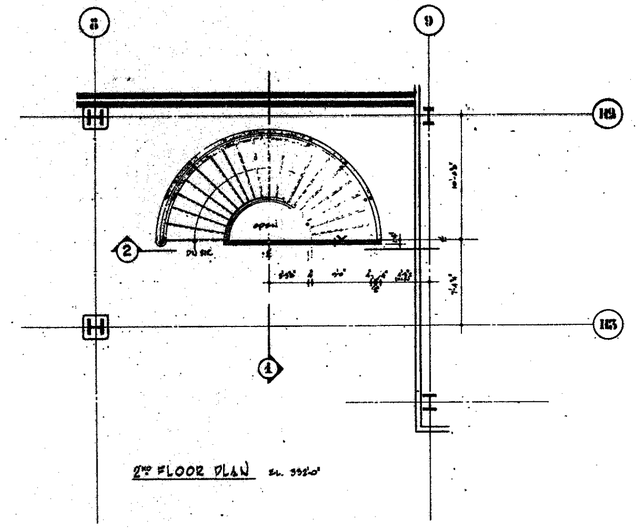


2nd FLOOR PLAN

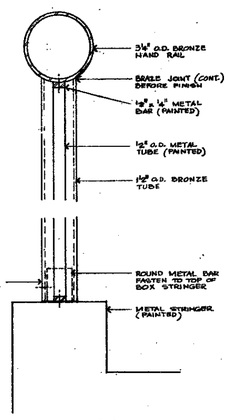


SECTION "7"

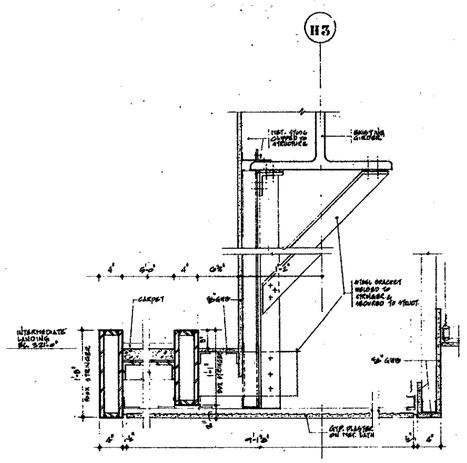


DETAIL "4"

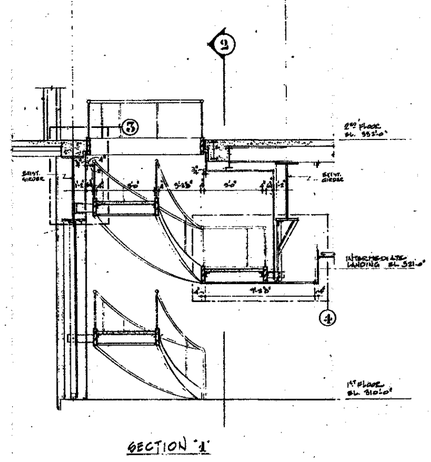


SECTION "1"

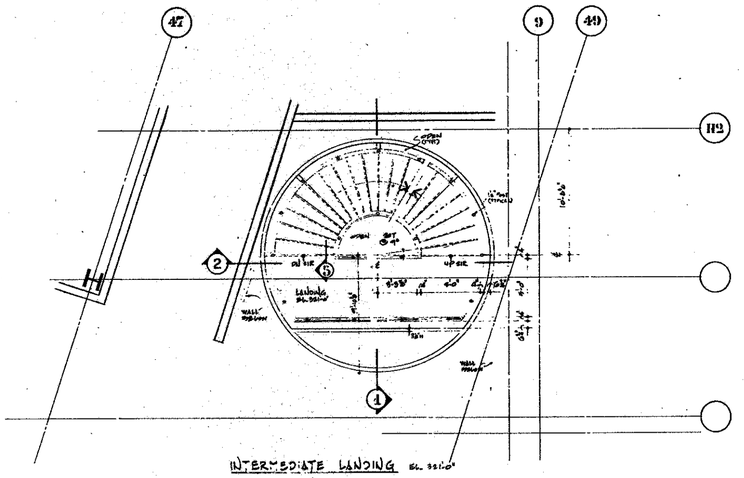


INTERMEDIATE LANDING

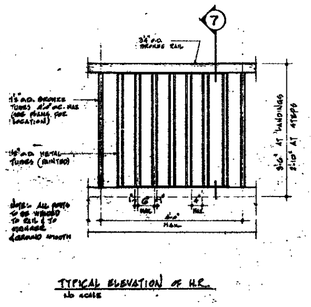


TYPICAL ELEVATION OF H.R.

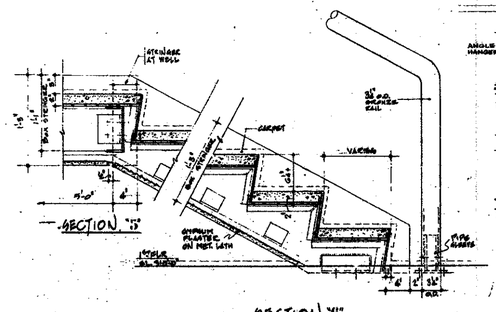

SECTION "5"

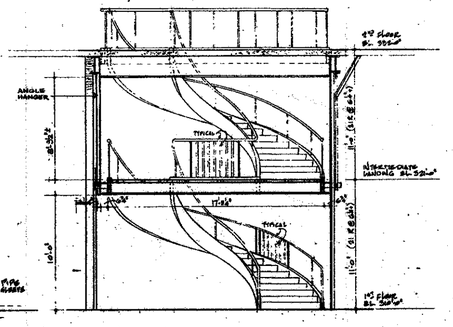

SECTION "2"

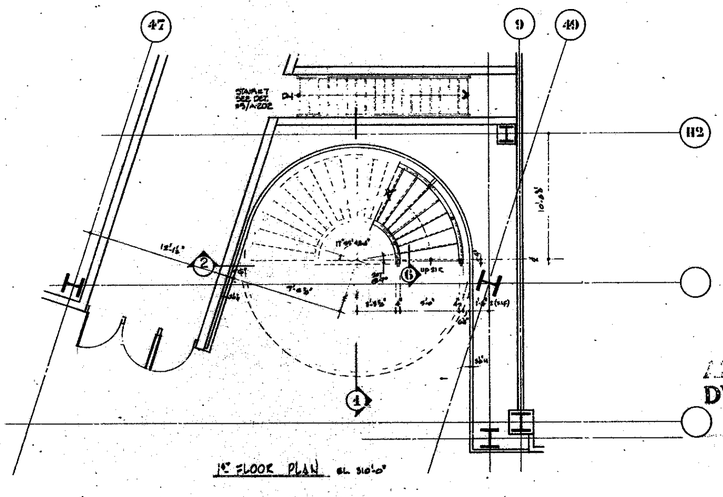

1st FLOOR PLAN

WORLD TRADE CENTER HOTEL

THE WORLD TRADE CENTER
NEW YORK, NEW YORK

SKIDMORE, OWINGS & MERRILL
ARCHITECTS
400 PARK AVENUE, NEW YORK

WEIDLINGER & FICKWORTH
STRUCTURAL ENGINEERS
500 PARK AVENUE, NEW YORK

JAROS, BAUM & BOLLES
MECHANICAL ENGINEERS
245 PARK AVENUE, NEW YORK

1	6-28-79	BUILT AS
2	5-12-79	ISSUED FOR CONSTRUCTION
NO.	DATE	REVISIONS

AS-BUILT DWGS

ORNAMENTAL STAIR

DATE 5-12-79
DRAWING NO. A-216
SCALE 1/4"=1'-0" & 1/8"=1'-0"
PROJECT NO. 1067

RECEIVED
NOV 19 1932
LESLIE E. ROBERTSON
ASSOCIATES
211 E. 46th ST., N.Y., N.Y. 10017