
WORLD TRADE CENTER HOTEL

THE WORLD TRADE CENTER
NEW YORK, NEW YORK


SKIDMORE, OWINGS & MERRILL
ARCHITECTS
400 PARK AVENUE, NEW YORK

WEIDLINGER & PICKWORTH
STRUCTURAL ENGINEERS
300 PARK AVENUE, NEW YORK


JAROS, BAUM & BOLLES
MECHANICAL ENGINEERS
245 PARK AVENUE, NEW YORK

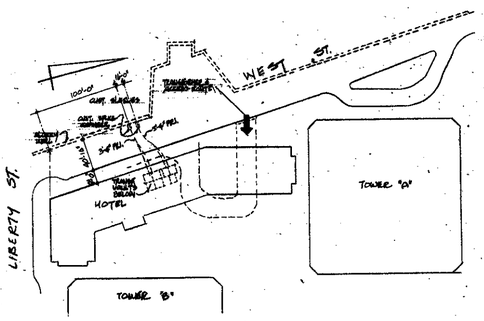


PLOT PLAN (1"=50')

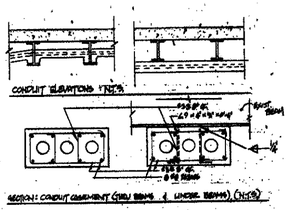



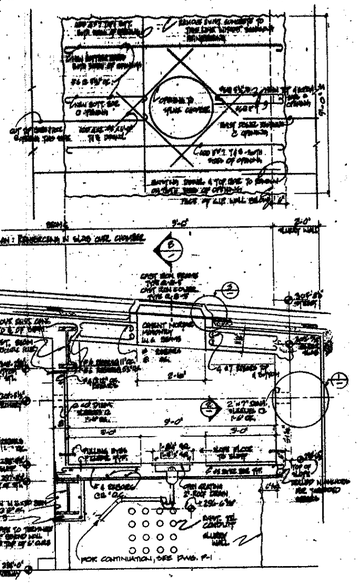

PLAN: REINFORCING IN SLAB AND CHAMBER

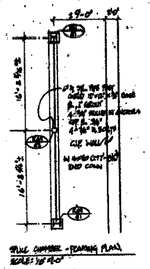


SCALE: 1/8"=1'0"

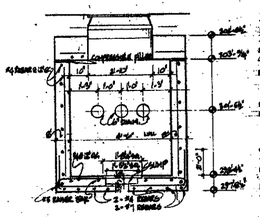



SPLICE CHAMBER SECTION 'BB'

SPLICE CHAMBER: SECTION 'AA' 1/4"=1'0"

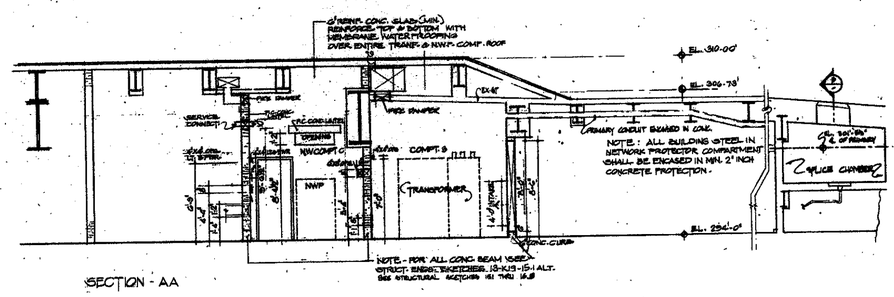


SECTION - AA

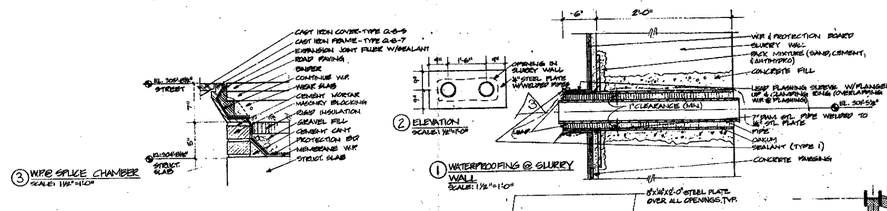


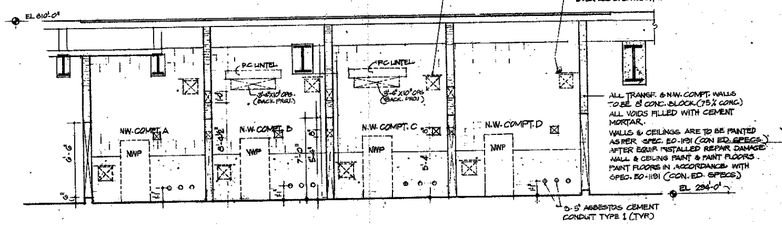

SECTION B-B

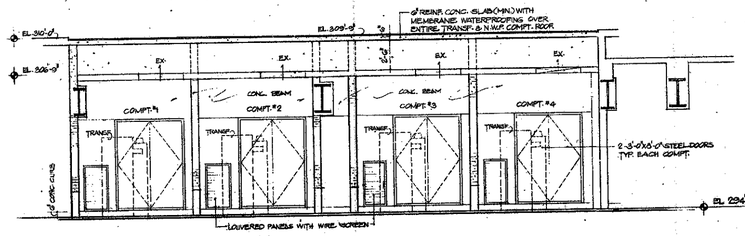

SECTION - CC

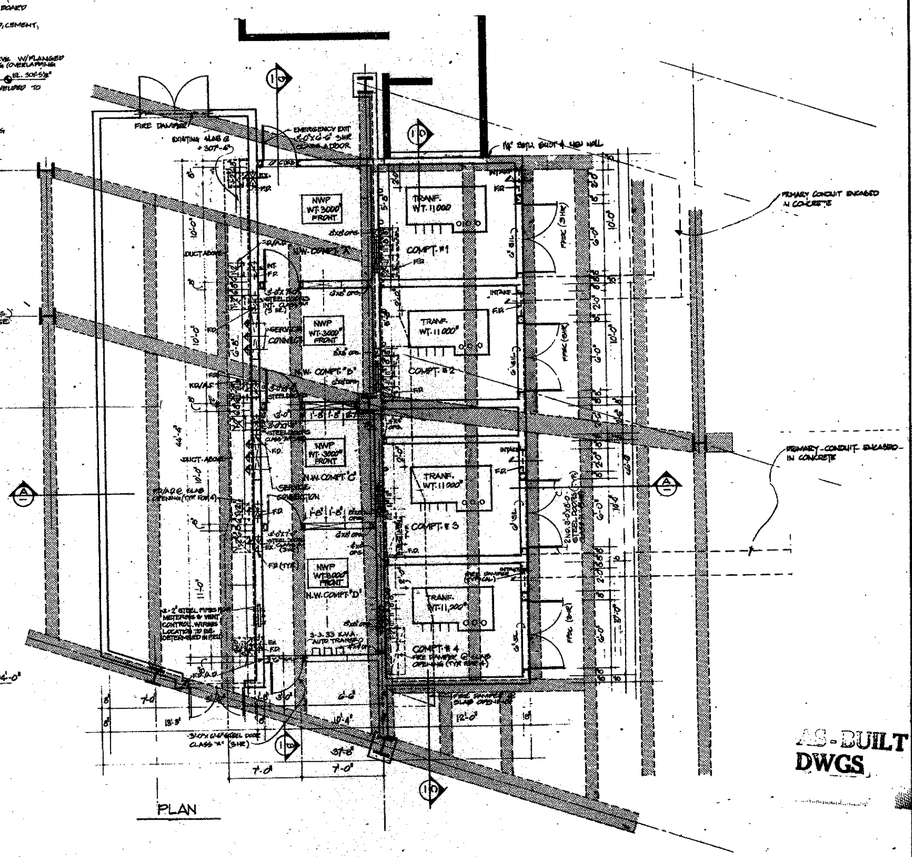

PLAN

AS-BUILT DWGS

NO.	DATE	REVISIONS
3	7/30/80	BULLETIN #264
2	5/1/80	BULLETIN #181
1	10-5-79	TO CONFORM TO CON ED LAYOUT

TITLE: TRANSFORMER VAULT

DATE: JULY 11, 78 | DRAWN BY | CHECKED BY | DRAWING NO. A-217

SCALE: 1/8" = 1'-0" | PROJECT NO. 9069-0000

RECEIVED
NOV 19 1982
LESLIE E. ROBERTSON ASSOCIATES
211 E. 46th ST., N.Y., N.Y.C. 10017