
WORLD TRADE CENTER HOTEL

THE WORLD TRADE CENTER
NEW YORK, NEW YORK


SKIDMORE, OWINGS & MERRILL
ARCHITECTS
400 PARK AVENUE, NEW YORK

WEIDLINGER & PECKWORTH
STRUCTURAL ENGINEERS
200 PARK AVENUE, NEW YORK


JAROS, BAUM & BOLLES
MECHANICAL ENGINEERS
245 PARK AVENUE, NEW YORK

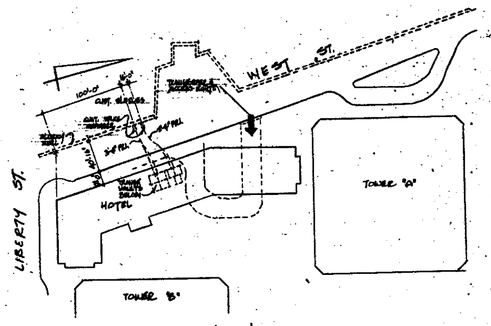


PLOT PLAN 0'-1"=1'-0"

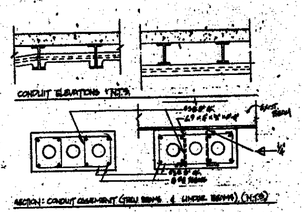


SECTION: CONDUIT ELEVATION (TYP.)

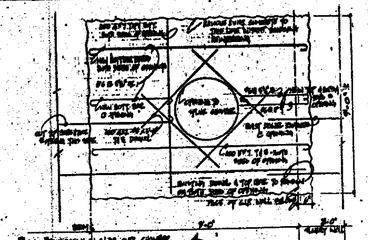

PLAN: PROTECTION @ SLAB OVER CHAMBER

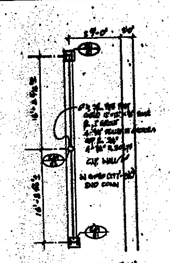


VAULT CHAMBER - FRAMING PLAN
SCALE: 1/8"=1'-0"

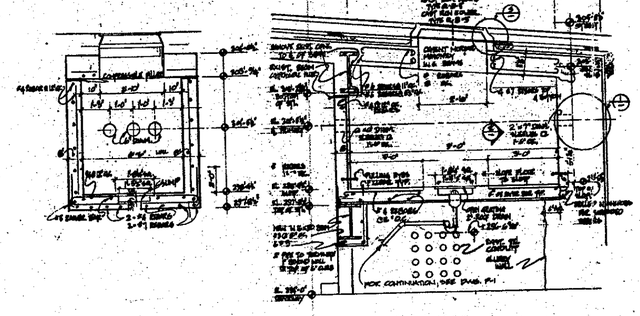


SPLICE CHAMBER SECTION 'BB'

SPLICE CHAMBER : SECTION 'AA' 1/4"=1'-0"

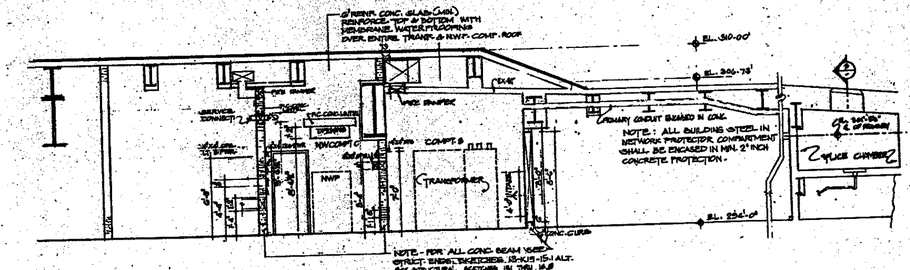


SECTION - AA

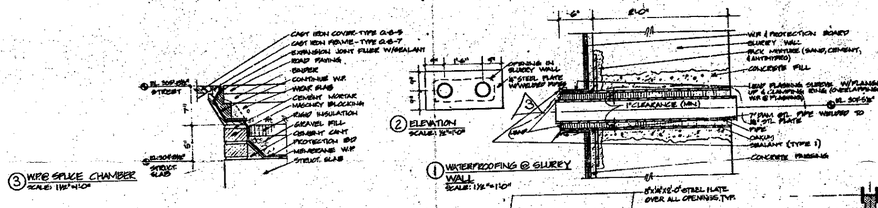



② ELEVATION SCALE: 1/2"=1'-0"


① WATERPROOFING @ SURREY WALL SCALE: 1 1/2"=1'-0"

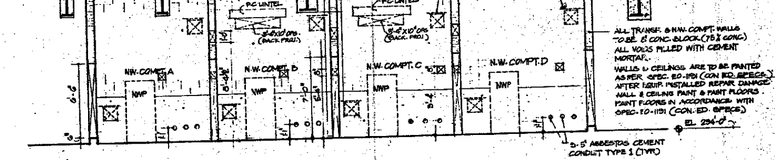

SECTION B-B

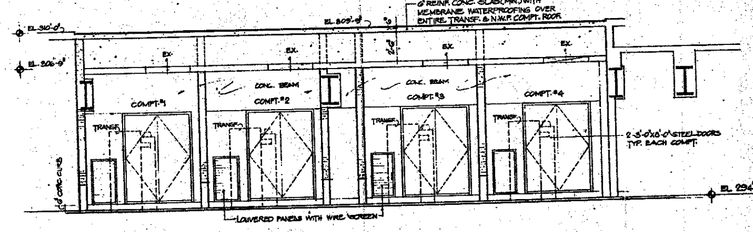

SECTION - CC

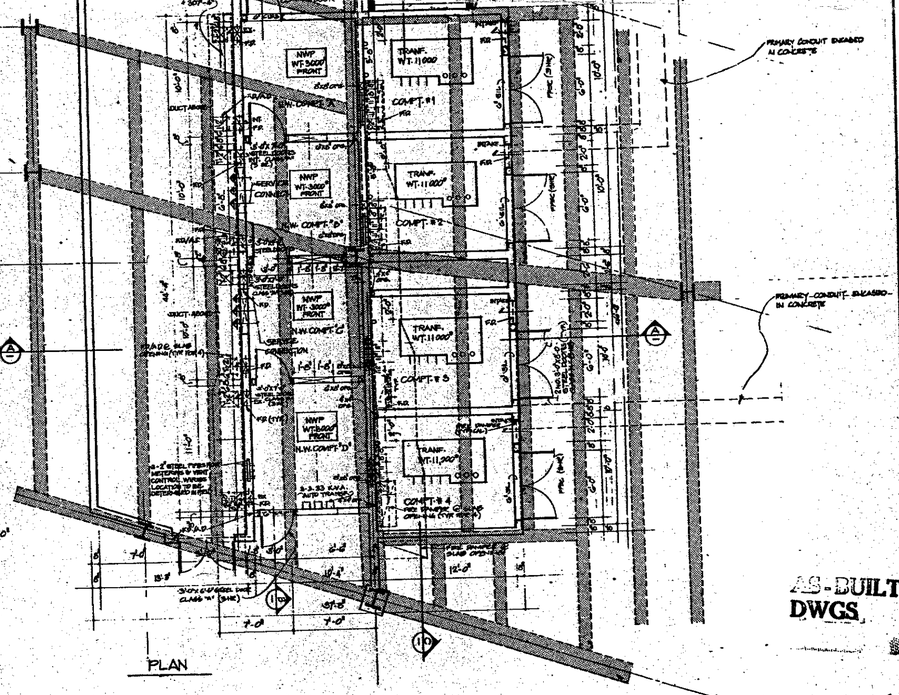

PLAN

AS-BUILT DWGS

5	7-30-80	BULLETIN #68	
2	2-1-80	BULLETIN #68	
1	10-3-79	TO CONFORM TO CON ED MARKUP	
DWG.	DATE	REVISIONS	

TITLE: TRANSFORMER VAULT

DATE: JULY 11, 78	DRAWN BY:	A-217
SCALE: 1/4"=1'-0"	CHECKED BY:	

PROJECT NO. 7908-0000

RECEIVED
NOV 19 1992
LESLIE E. ROBERTSON ASSOCIATES
211 E. 46th ST., N.Y., N.Y.C. 10017