
WORLD TRADE CENTER HOTEL

THE WORLD TRADE CENTER
NEW YORK, NEW YORK

SKIDMORE, OWINGS & MERRILL
ARCHITECTS
400 PARK AVENUE, NEW YORK

WEIDLINGER & PECKWORTH
STRUCTURAL ENGINEERS
200 PARK AVENUE, NEW YORK

JAROS, BAUM & BOLLES
MECHANICAL ENGINEERS
345 PARK AVENUE, NEW YORK

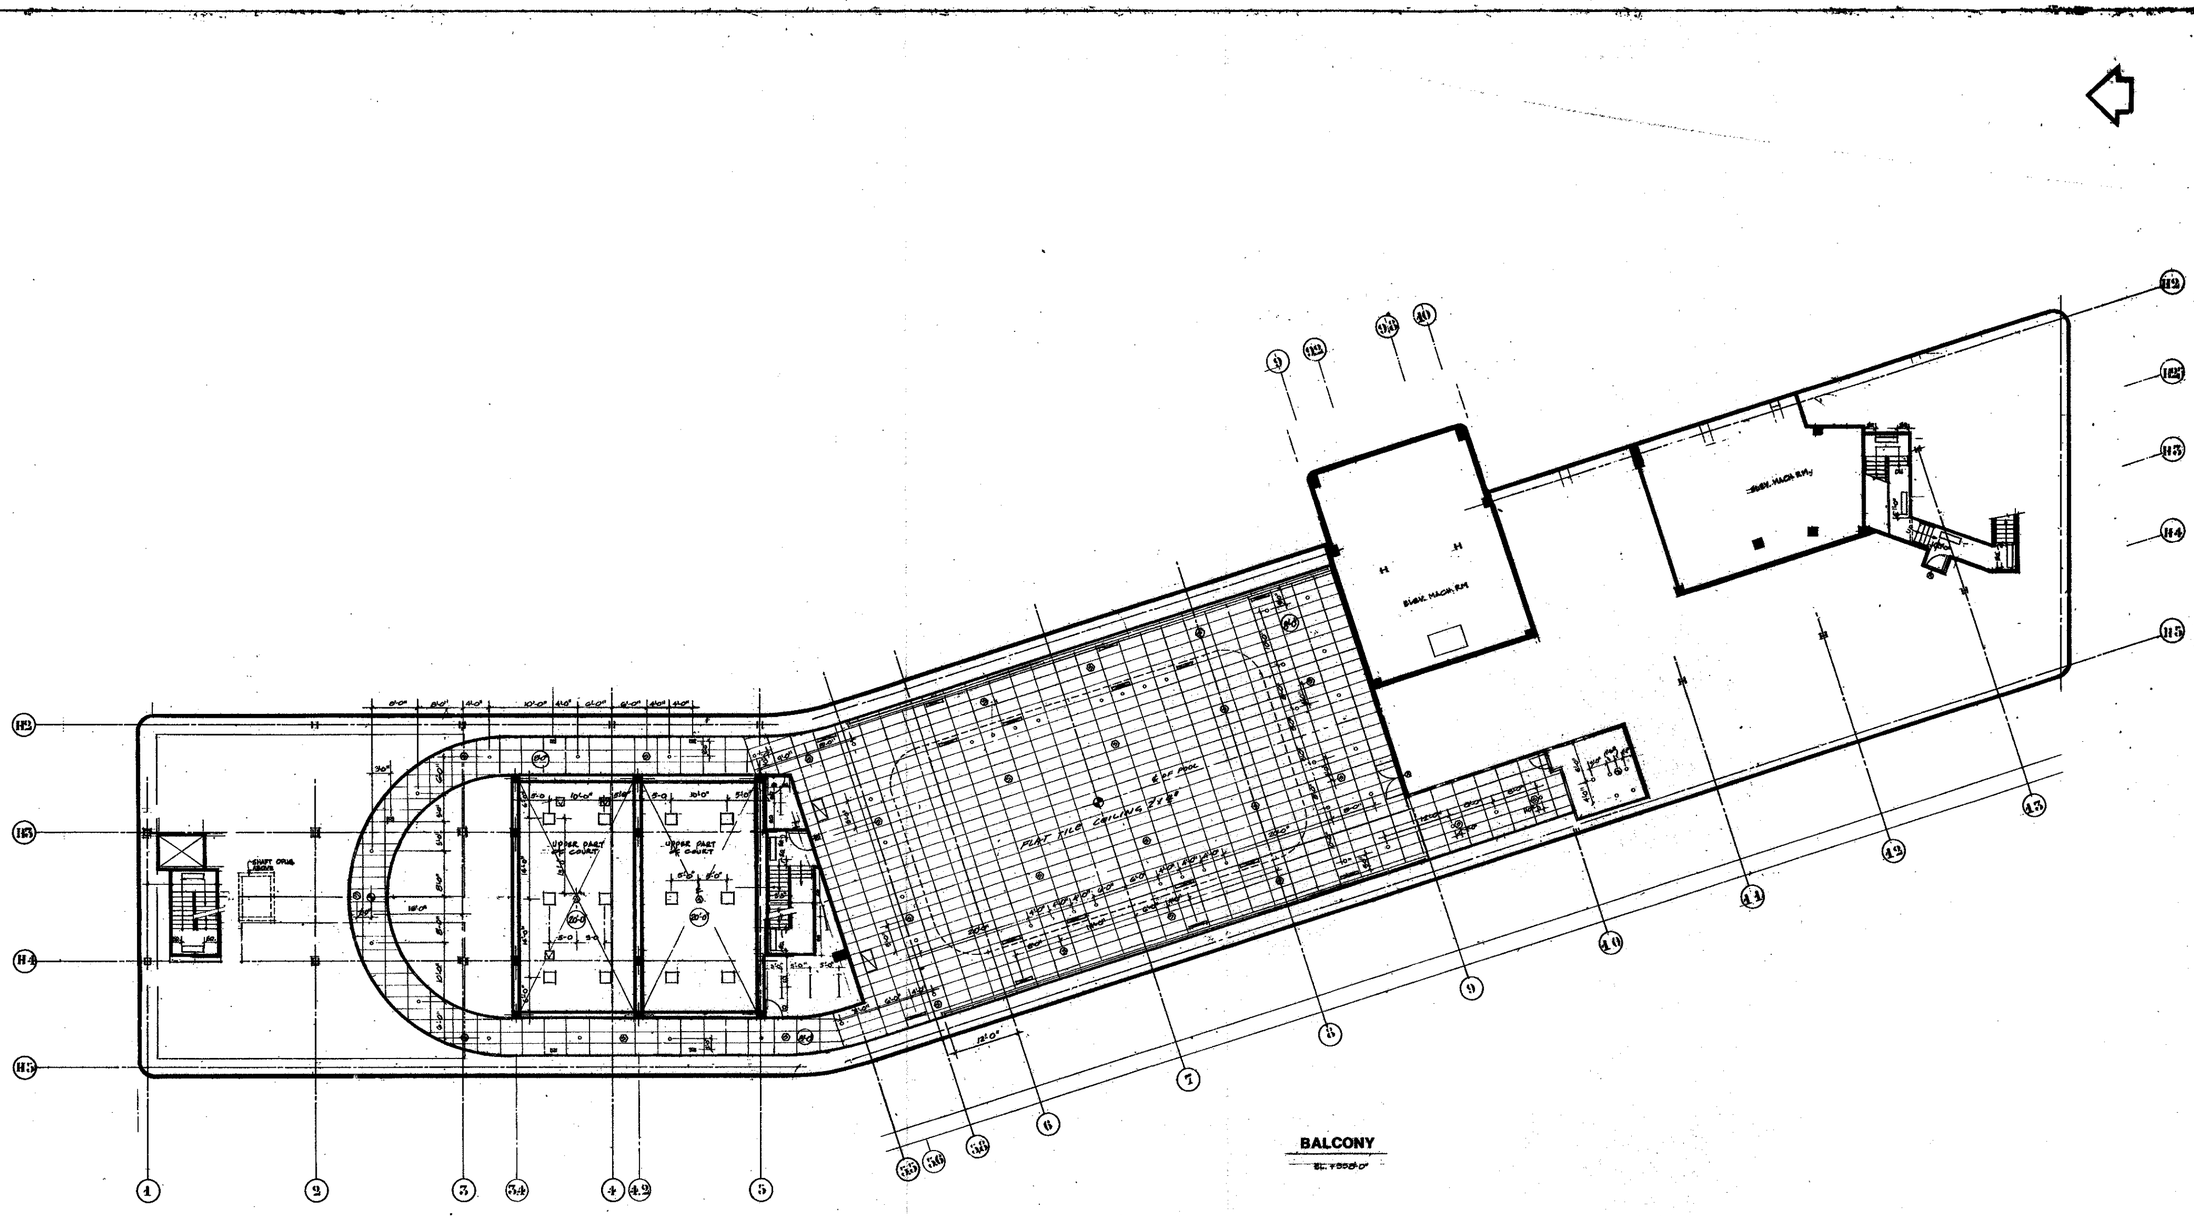

LEGEND

- 2'-0"x4'-0" FLUORESCENT FIXT.
- 1'-0"x4'-0" FLUORESCENT FIXT.
- FLUORESCENT SURF. MTD. STRIP LUMINAIRE
- INCANDESCENT FIXT.
- CEILING DIFFUSER
- AIR SUPPLY REGISTER
- RETURN AIR REGISTER
- SPRINKLER HEAD
- EXIT LIGHT
- ACOUSTIC TILE CEILING (2'-0"x4'-0")
- SPEAKER
- DRAFT ACCESS DOOR
- 2 HR. RATED PARTITION TO UNDERSIDE OF ASSEMBLY - UNLESS OTHERWISE NOTED.
- SEE WALL TYPES SCH. DWG. A-2
- GYP. FIRE RATED CEILING

NO.	DATE	REVISIONS
12	12-17-80	REVISE GLASS WIND. GUARDS & RAIL

AS-BUILT DWGS

BALCONY REFLECTED CEILING PLAN

DATE 12/26/79	DRAWING NO. A306
SCALE 1/8"-1'-0"	PROJECT NO. 1400

RECEIVED
NOV 19 1982
LESLIE E. ROBERTSON
ASSOCIATES
211 E. 46th ST., N.Y., N.Y.C. 10017