
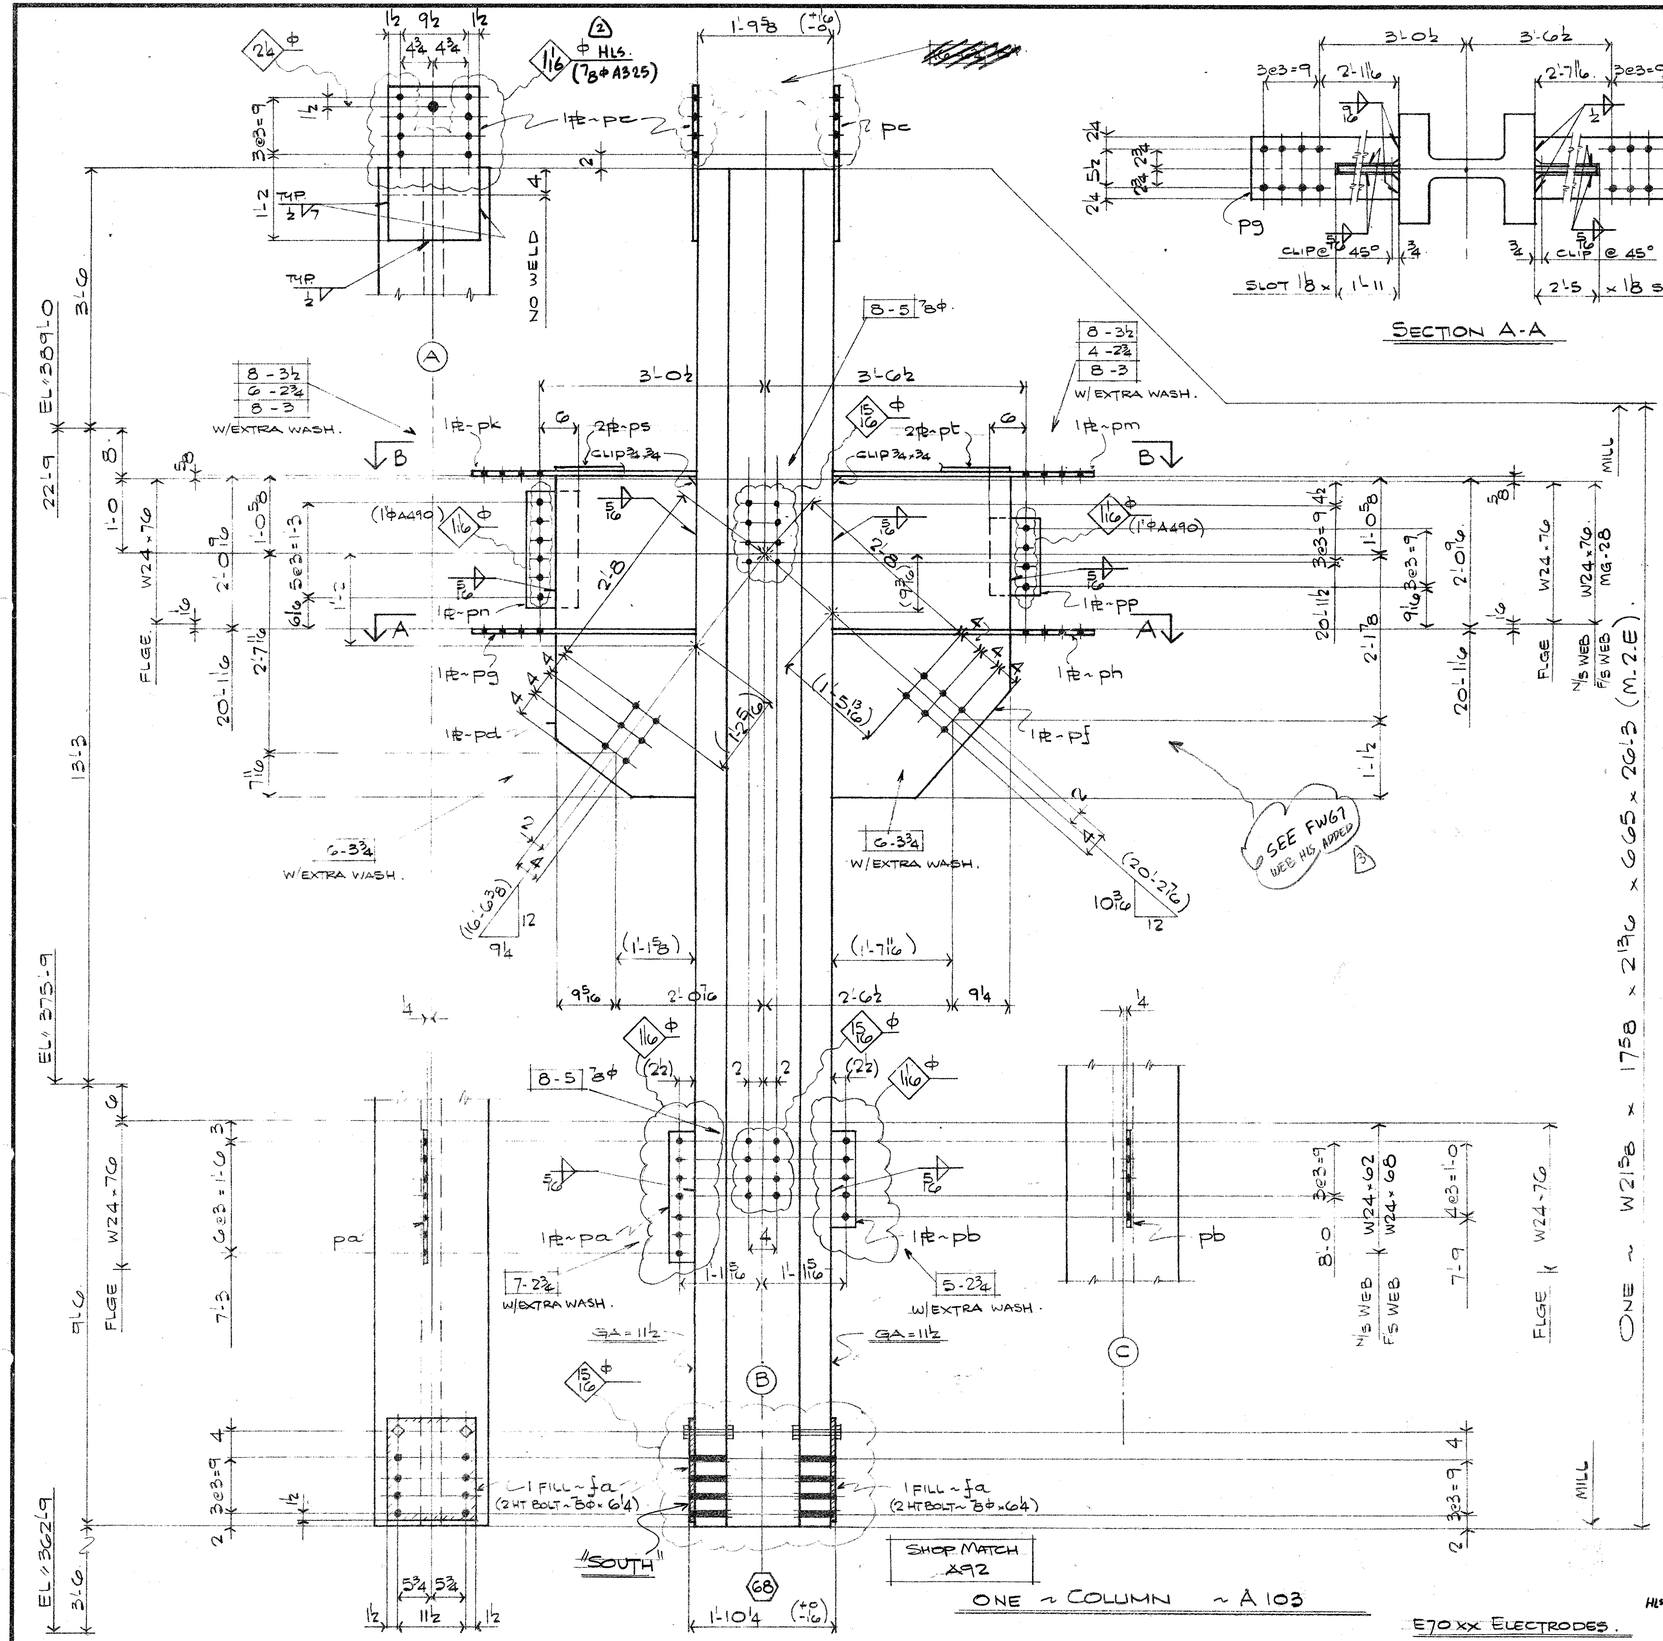


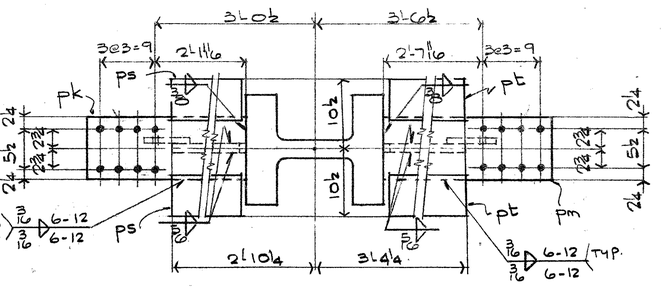

FIELD BOLT SUMMARY.

16 - 7/8φ A325 x 5

~~16~~ ——"—— x ~~5~~

12 - 1"φ A490 x 3¾

22 - 1"φ A490 x 2¾

16 - ——"—— x 3

16 - ——"—— x 3½

66 - EXTRA WASH.~(1"φ A490).

BILL OF MATERIAL

LINE	CCOSDTE	COMM'X SHIP DIVN.	PIECE MARKS MAIN MAT'L.	PIECE MARKS DETAIL MAT'L.	NO. OF PIECES	MATERIAL DESCRIPTION PL	WIDTH Inch	WIDTH 16th	X PLATE ONLY	THK. In.	THK. 16th	GRADE CODE	DESIGNOR	FINISHED LENGTH Feet	FINISHED LENGTH In.	FINISHED LENGTH 16th	PAGE	LINE	REMARKS
01				F001															
02				PA	1	PL	4	4	x			44W		1	9	4			
03				PB	1		4	4	x					1	3	4			
04				PC	2		12	8	x					2	1	0			
05				PD	1		22	5	x					4	4	0			
06				PE	1		28	5	x					4	4	0			
07				PG	1		10	0	x					1	3	12			
08				PH	1		10	0	x					1	3	12			
09				PK	1		10	0	x					1	3	12			
10				PM	1		10	0	x					1	3	12			
11				PZ	1		7	12	x					1	2	0			
12				PP	1		7	12	x					1	2	0			
13				PS	2	PL	6	4	x					1	1	8			
14				FA	2	PL	14	8	x			44W		1	4	0			
15				PT	2	PL	6	4	x					2	4	0			
16					4		HT		BOLT 3/4 x 6 1/4			A325							
17																			
18					1		IF			5/16				52	0	0			
19					1		IF			3/16				15	0	0			
20					1		IF			1/2				5	8	0			
21					1		IF			9/16				1	9	0			
22					1		IF			3/8				3	4	0			
23	0711	A103			1		W	14 x 665				A36		26	3	0	7	26	M2E COL
24																			
25																			
26				TOTAL	29								TOTAL	127			1	OF 1.	

01																			
02																			
26				TOTAL									TOTAL						

FOR 1"φ A490 BOLTS.

Apr 4/85 R
Mar 28/85 R
Mar 11/85

REV.	DATE	BY	SPEC.	A36 - U/N
1	28-3-85	ES	HOLES	13/16 φ U/N
2	APR 4/85	BF	FINISH	—
3	MAY 13/85	S.F.		

FRANKEL STEEL LIMITED
220 ATTWELL DRIVE, UNIT 1, REXDALE, ONTARIO M9W 5B2

MADE	DATE	SQUAD	PROJECT	CONTRACT	DWG No.
27 JS	JAN '85	FR	7 WORLD TRADE CENTRES	84-15	103
CHK'D. 28 AS.	DATE MAR 85		DETAIL: COL (68) ~ (47TH LIFT).		