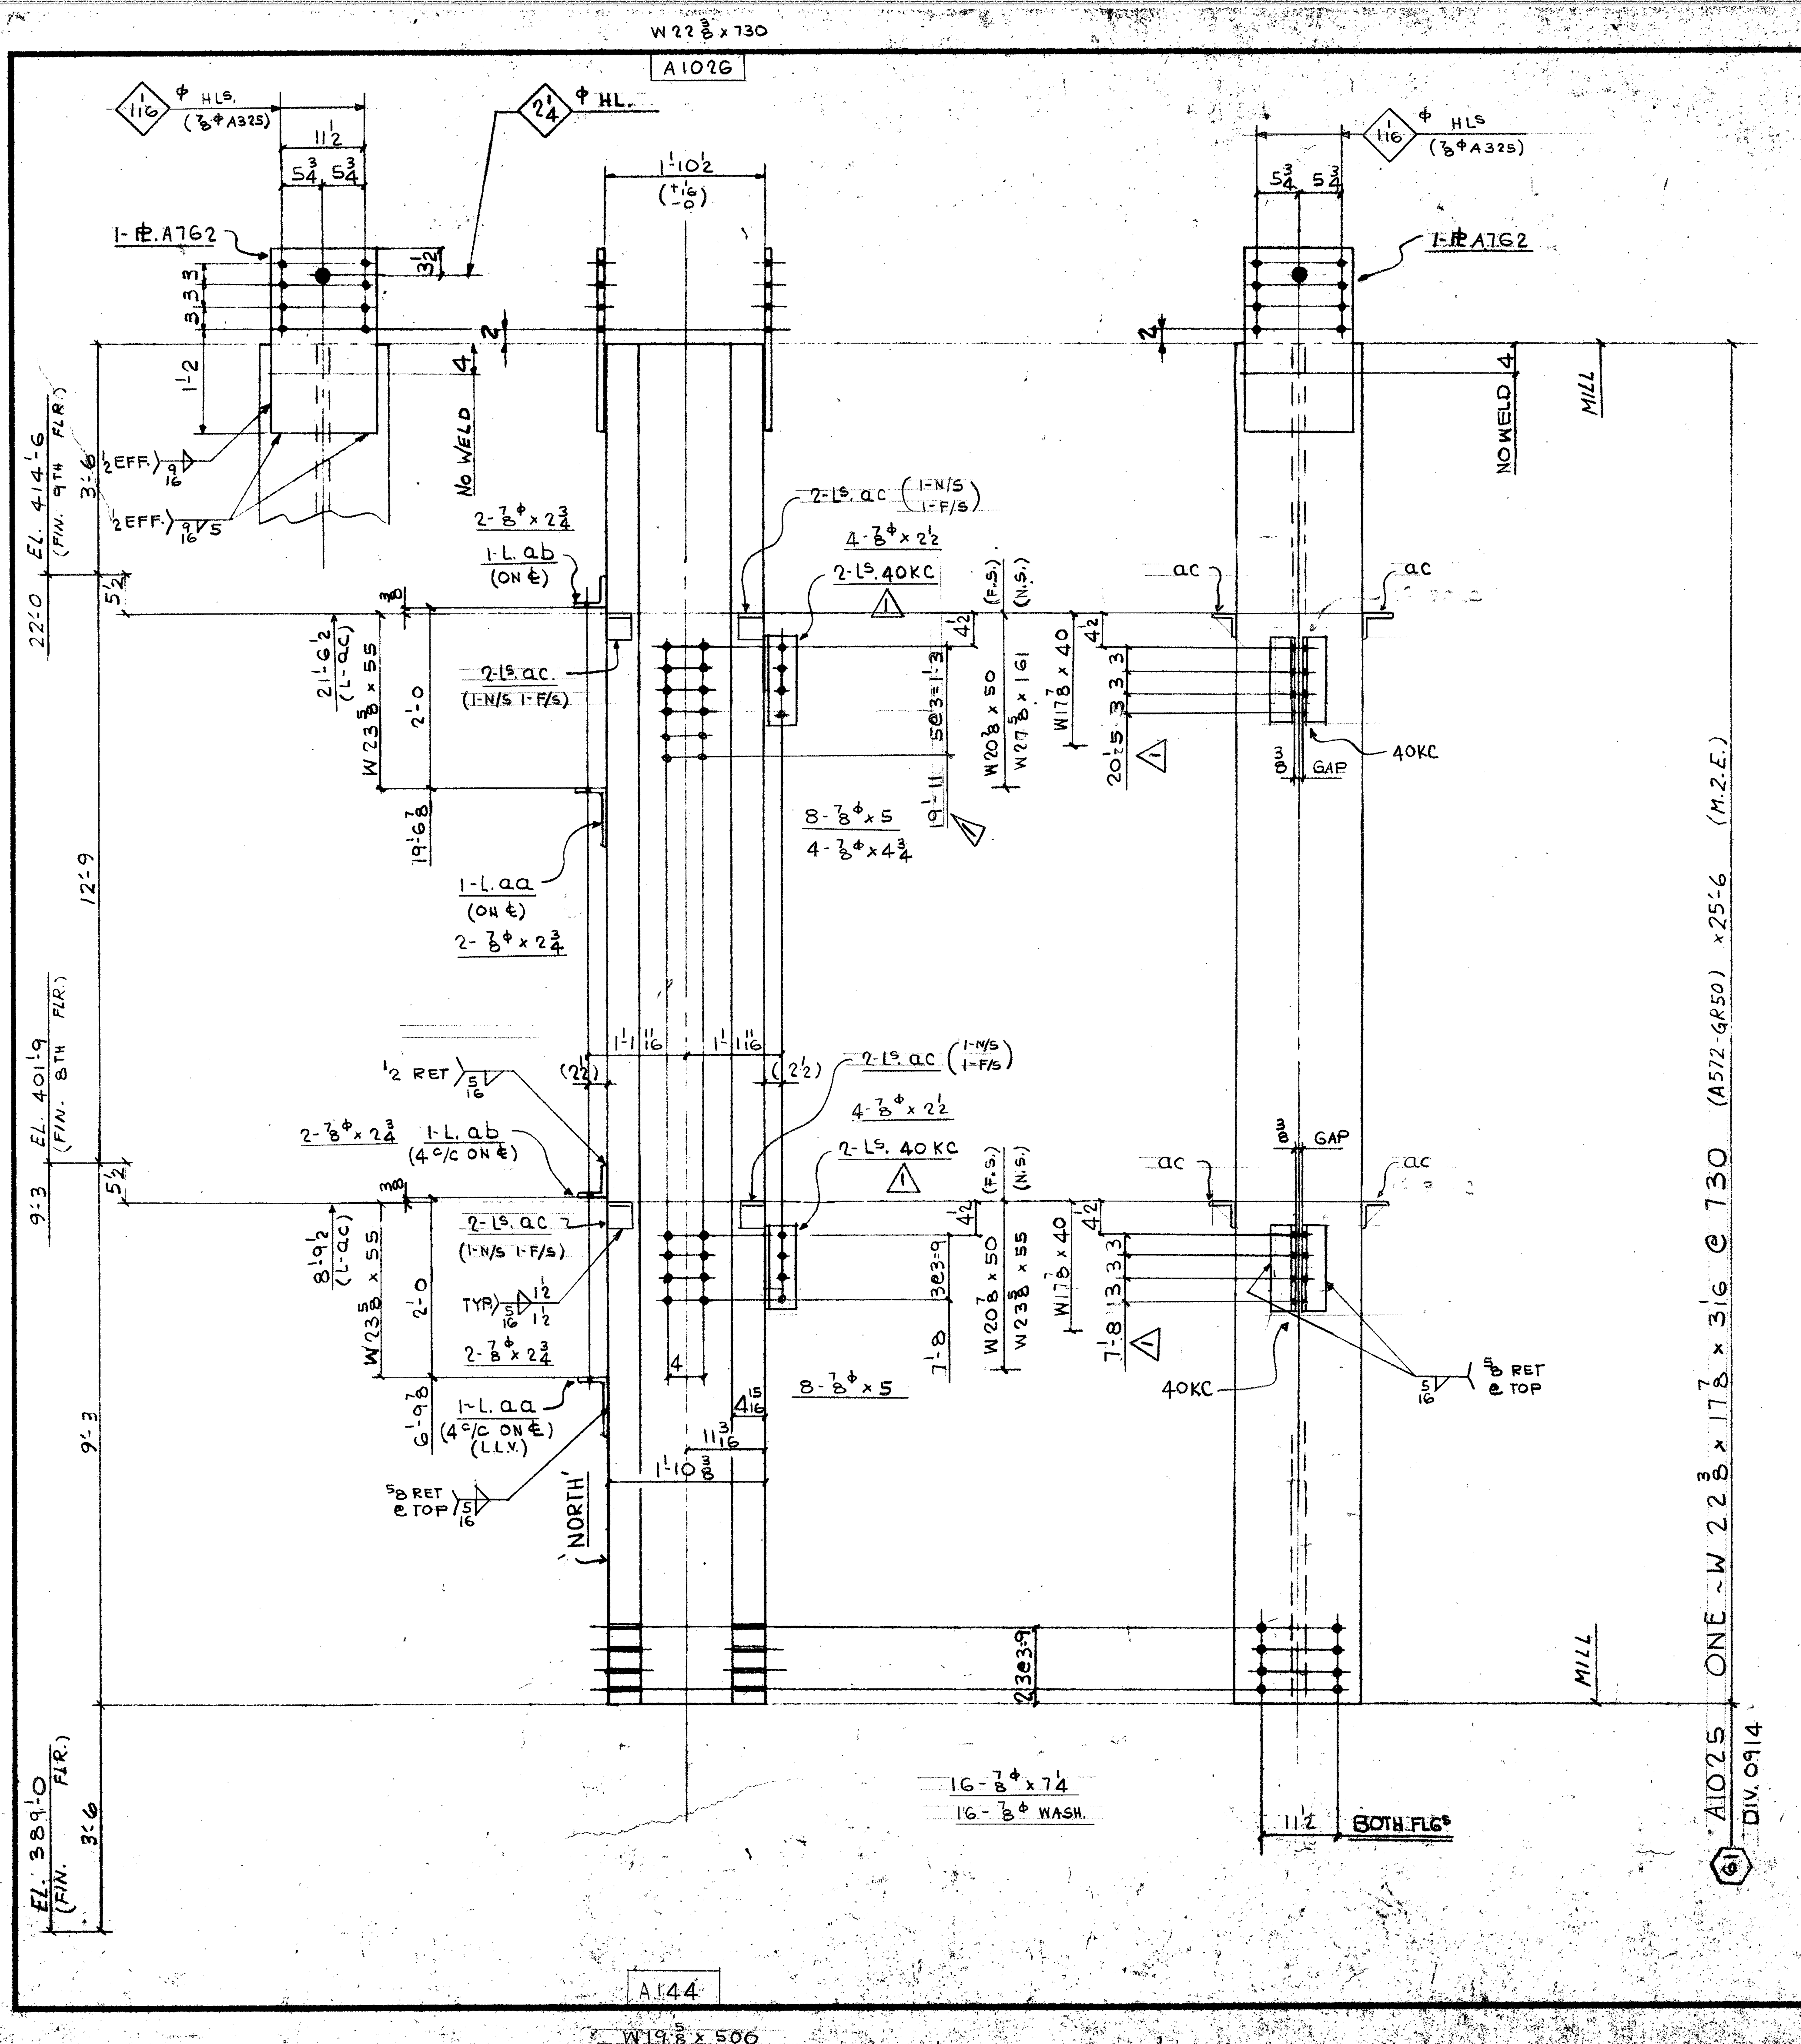


FIELD BOLTS:

8 - 7/8φ (A325F) x 2 1/2
8 - " x 2 3/4
16 - " x 5
16 - " x 7 1/4
16 - 7/8φ (A325) WASHER
4 - 7/8φ (A325) x 4 3/4

DIM'S SHOWN IN BRACKETS ARE BASED ON ACCURATE COL SIZES.

SHOP SCRIBE VISIBLE C/L ON BOTH FLGS & B/S WEB TOP & BOTT.

MAT'L G40·21-44W U/N
E70 SERIES ELECTRODES
REF. DWG. E 8/9, E117, E117A
901, 9114

BILL OF MATERIAL

LINE	CC COST CODE	COMMX SHIP DIVN	PIECE MARKS MAIN MAT'L	PIECE MARKS DETAIL MAT'L	NO. OF PIECES	MATERIAL DESCRIPTION	GRADE CODE	DSOR	FINISHED LENGTH Feet	In.	16th	PAGE	LINE	REMARKS
01					F001									
02				40KC					0	11	8			
03				~~30KC~~	4	L 4 x 3 x 3/8	44W		~~0~~	~~6~~	~~8~~			
04				AA	2	L 8 x 4 x 3/4	"		0	8	0			
05				AB	2	L 4 x 4 x 3/8	"		0	7	0			
06				A762	2 PL	14 8 X 0 10	44W		2	1	0			
07				AC	8	L 3 x 3 x 3/8	"		0	3	0			PLAIN
08														
09					1	IF 5/16			9	0	0			
10					1	IF 9/16			4	0	0			
11														
12														
13														
14		0914	A1025		1	W14 x 730	A572GR50		25	6	0	16	3	M.Z.E
15														
16														
26				TOTAL	22	TOTAL			40					1-OF-1
01														
02														
25														MAY 10/85 R
26				TOTAL		TOTAL								Apr 27/85

30KC CHANGE TO 40KC
HLS. IN WEB ADDED

REV.			
1	DATE MAY 7/85	BY EC	SPEC. AS NOTED
2	DATE	BY	HOLES 15/16 φ U/N
3	DATE	BY	FINISH NONE

FRANKEL STEEL LIMITED
220 ATTWELL DRIVE, UNIT 1, REXDALE, ONTARIO M9W 5B2

MADE 27 EC	DATE MARCH /85	SQUAD FR	PROJECT: 7 WORLD TRADE CENTER	CONTRACT 84-152	DWG. No. 1025
CHK'D 28 BF	DATE APR 10/85		DETAIL: COLUMN (61) (5TH TIER)		