
W22 3/8 x 730-A
W21 5/8 x 665-B

B1064-A
A1065-B

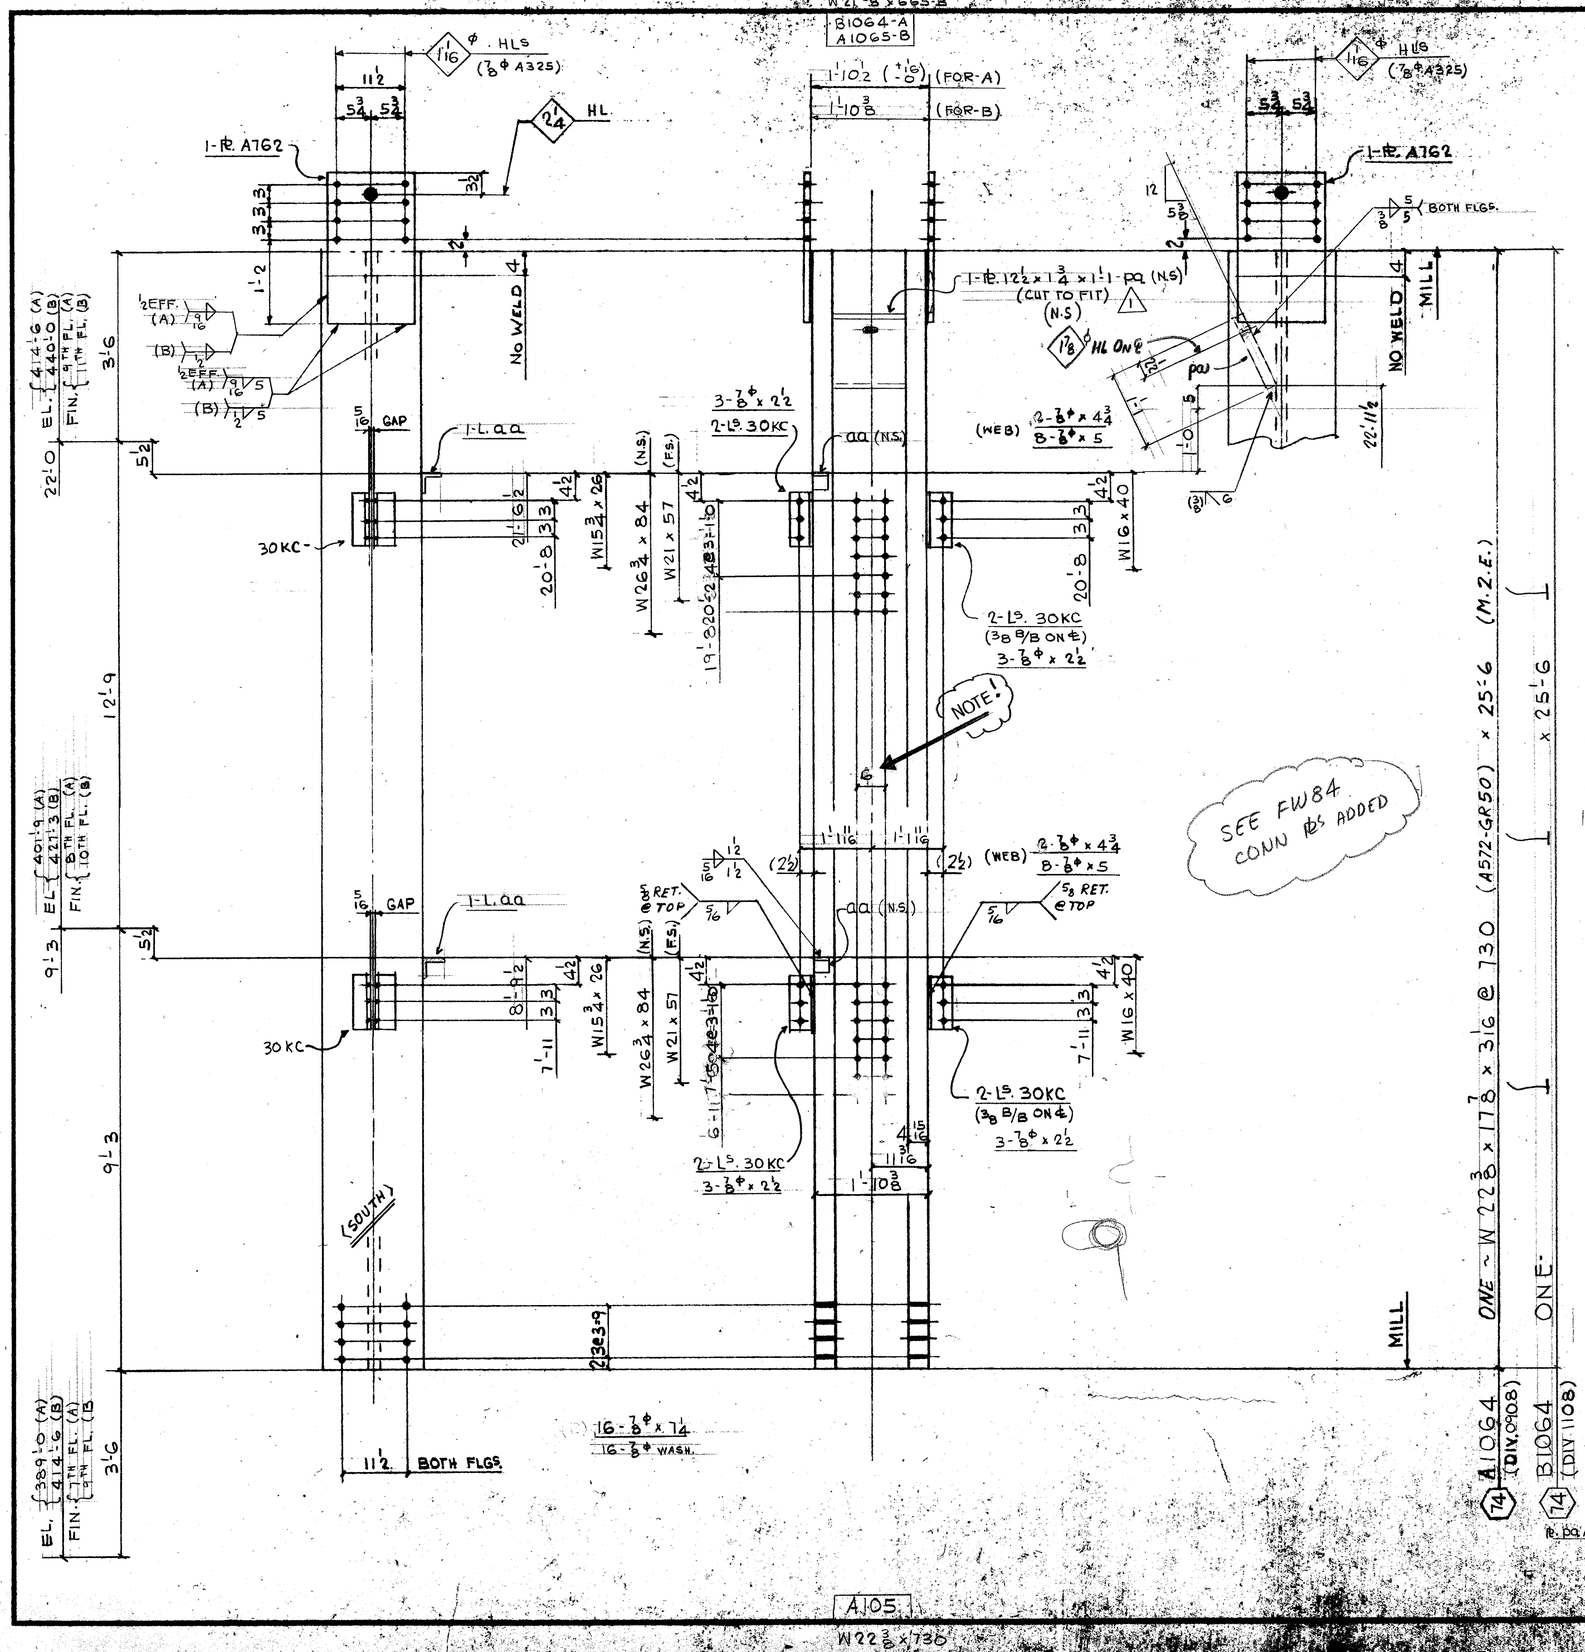

FIELD BOLTS:

24 - 7/8φ (A325F) x 2 1/2
8 - x 4 3/4
32 - x 5
32 - x 7 1/4
32 - 7/8φ (A325) WASHER

DIM'S SHOWN IN BRACKETS ARE BASED ON ACCURATE COL SIZES.

SHOP SCRIBE VISIBLE C/L ON BOTH FLGS & B/S WEB TOP & BOTT.

MAT'L G40.21-44W U/N
E70 SERIES ELECTRODES
REF. DWG.S E8 TO E11
E117, E117A, 901

BILL OF MATERIAL

LINE	COST CODE	COMMX SHIP DIVN	PIECE MARKS MAIN MAT'L	PIECE MARKS DETAIL MAT'L	NO OF PIECES	MATERIAL DESCRIPTION PL	WIDTH Inch	WIDTH 16th	X PLATE ONLY	THK In.	THK 16th	GRADE CODE	DOOR	FINISHED LENGTH Feet	FINISHED LENGTH In.	FINISHED LENGTH 16th	PAGE	LINE	REMARKS
01				F002															
02																			
03				30KC	16	L	4	x 3 x	3/8			44W		2	8	8			
04				AA	4	L	3	x 3 x	3/8			⊥		0	3	0			PLAIN
05				A762	4	PL	14	8 x		0	10	44W		2	1	0			
06				PA	2	PL	12	8 x		1	12	⊥		1	1	0			
07																			
08																			
09																			
10					1	LF	5/16							12	0	0			
11					1	LF	1/2							4	0	0			
12					1	LF	9/16							4	0	0			
13																			
14																			
15	0908	A1064			1				W14 x 730			A572GR50		25	6	0	12	B	M.2.E.
16	1108	B1064			1				⊥			⊥		25	6	0	1	1	⊥
17																			
18																			
19																			
20																			
21																			
22																			
23																			
24																			
25																			
26			TOTAL		~~31~~ 33				TOTAL					~~72~~ 73					1-OF-1
01																			
02																			
26			TOTAL						TOTAL										

MAY 10/85 K
Gal 27 RS

1	DATE MAY 7/85	BY EC	SPEC. AS NOTED	FRANKEL STEEL LIMITED	
2	DATE	BY	HOLES 15/16φ U/N	220 ATTWELL DRIVE, UNIT 1, REXDALE, ONTARIO M9W 5B2	
3	DATE	BY	FINISH NONE		
MADE 27	EC	DATE MARCH 12/85	SQUAD FR	PROJECT: 7 WORLD TRADE CENTER	CONTRACT 84-152
CHK'D 28	BF	DATE APR 12/85		DETAIL: COLUMNS 14 (5TH & 6TH TIER)	DWG. No. 1064