
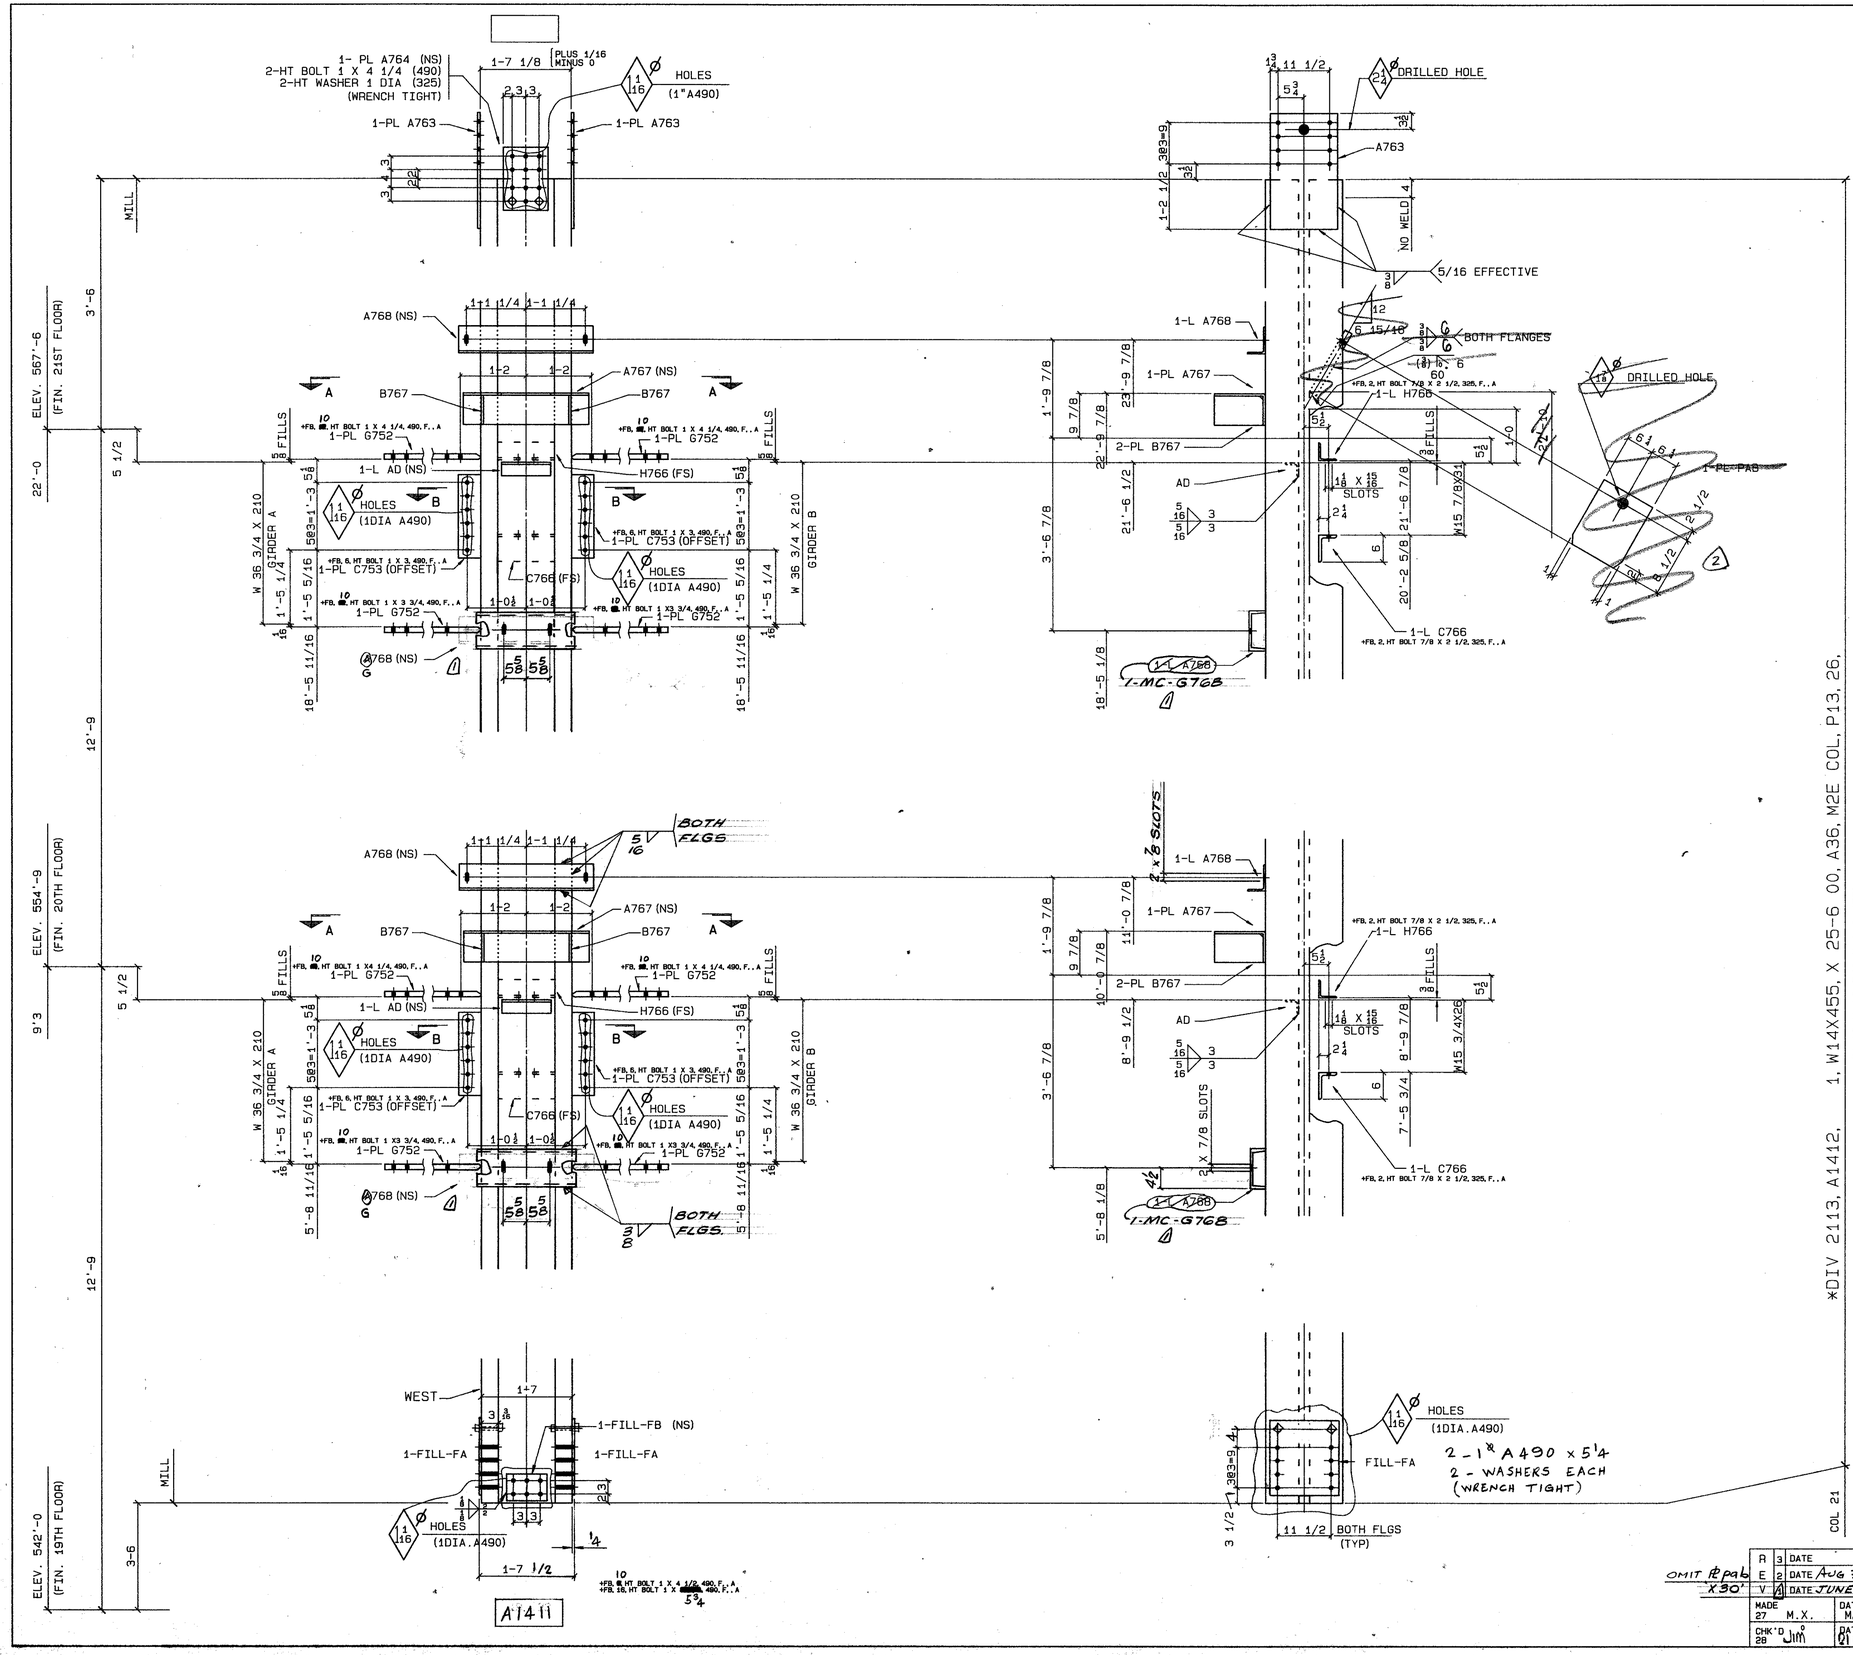



MATERIAL

:	8, PI 012 00	X00 5/8, X 1-6 1/2, G752, 44W, ...	A
:	4, PI 005 00	X00 1/2, X 1-6 1/2, C753, 44W, ...	A
:	2, PI 017 7/8	X00 1/2, X 2-4 00, A767, 44W, BENT. . . .	A
:	4, PI 006 1/2	X00 3/8, X 0-10 3/4, B767, 44W, ...	A
:	2, PI 015 00	X00 5/8, X 2-1 1/2, A763, 44W, ...	A
:	1, PI 010 00	X00 5/8, X 1-2 00, A764, 44W, ...	A
:	2, PI 015 00	X00 1/4 X 1-5 00, FA, 44W, ...	A
:	1, PI 006 1/2	X00 1/8, X 0-9 1/2, FB, 44W, ...	A
~~2~~	~~1, PI 011 00~~	~~X01 3/4, X 1-0 1/2, PAB, 44W, ...~~	~~A~~
1 : 2	4	L 6 X 4 X 5/16, X 2-6 00, A768, 44W, ...	A
:	2, L 4 X 4 X 3/8, X 1-0 1/2, H766, 44W, ...		A
:	2, L 6 X 4 X 3/4, X 1-0 1/2, C766, 44W, ...		A
:	2, L 3 X 3 X 3/8, X 0-8 00, AD, 44W, ...		A
:	2, HT BOLT 1 X 4 1/4, . . 490, ...		A
:	6, HT WASHER 1 . . . 325, ...		A
:	4, HT BOLT 1 x 5 1/4, A490		
+FB, 130	HT WASHER 1, 325, . .		A
:	1, 1F 3/16, X 12-0 00, .		A
:	1, 1F 5/16, X 33-0 00, .		A
:	1, 1F 3/8, X 6-0 00, .		A
:	1, 1F 1/2, X 4-0 00, .		A
:	1, 1G 1/2, X 8-0 00, .		A
:	1, 1G 1 3/4, X 2-0 00, .		A

1 2 : 9MC x 25.4 x 1'-10 - G76B (A36) (P217/2)

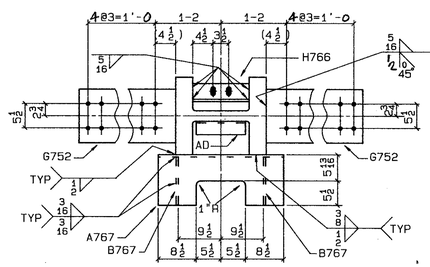

SECTION A-A

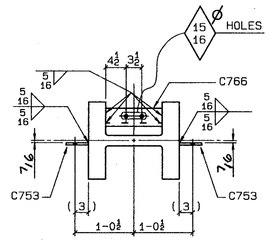

SECTION B-B

*DIV 2113, A1412, 1, W14X455, X 25-6 00, A36, M2E COL, P13, 26, (W 19 X 16 7/8 X 2 @ 455)

COL 21

SHOP NOTES
MATERIAL G40.21 44W U/N
E70 SERIES ELECTRODES
REF. D1AG'S E20/21, 9136, 9102, E118A, E117, CW-1

DIM'S SHOWN IN BRACKETS ARE BASED ON ACCURATE COL SIZES.

SHOP SCRIBE VISIBLE C/L ON aug 31/85R
BOTH FLGS & B/S WEB TOP & BOTT.
June 10/85R
may 24/85

FOR 1 DIA A490

OMIT PL pab x 30'

R	3	DATE	BY	SPEC	AS NOTED
E	2	DATE AUG 31/85	BY FR	HOLES	1 3/16 DIA U/N
V	1	DATE JUNE 6/85	BY GM	FINISH	NONE

FRANKEL STEEL LIMITED
220 ATTWELL DRIVE, UNIT 1, REXDALE, ONTARIO M9W 5B2

MADE	DATE	SQUAD	PROJECT: 7 WORLD TRADE CENTER	CONTRACT	DWG. NO.
27 M.X.	MAY 85	FR		84-152	1412
CHK'D 28 Jim	DATED 21 MAY		DETAIL: COLUMNS (11TH TIER) (ZONE 2)		