

HAND WRITTEN BILL REQUIRED

MATERIAL

:	4, PI 012 00	X00 7/8, X 2-0 1/2, H752, 44W, P1E, . . .	A
:	4, PI 005 00	X00 1/2, X 1-9 1/2, A753, 44W, ...	A
:	2, PI 017 7/8	X00 1/2, X 2-4 00, A767, 44W, BENT, . . .	A
:	4, PI 006 1/2	X00 3/8, X 0-10 3/4, B767, 44W, ...	A
:	2, PI 015 00	X00 5/8, X 2-1 1/2, A763, 44W, ...	A
:	1, PI 010 00	X00 5/8, X 1-2 00, A764, 44W, ...	A
~~:~~	~~1, PI 018 00~~	~~X01 00, X 2-00 00, PA, 44W, ...~~	
:	4, L 6 X 4 X 5/16, X 1-10 1/2, C768L, 44W, ...		A
:	2, L 4 X 4 X 3/8, X 1-0 1/2, G766, 44W, ...		A
:	2, L 8 X 4 X 3/4, X 1-0 1/2, B766, 44W, ...		A
:	2, L 3 X 3 X 3/8, X 0-8 00, AD, 44W, ...		A
:	2, HT BOLT 1 X 5, . . 490, ...		A
:	2, HT WASHER 1 . . . 325, ...		A
~~:~~	~~4, PL 12 x 1 x 2'-3 1/2 B752 (44W) (P.I.E.)~~		
~~:~~	~~FB, 144, HT WASHER 1, 325~~		
:	1, 1F 3/16, X 12-0 00, .		A
:	1, 1F 5/16, X 39-0 00, .		A
:	1, 1F 3/8, X 6-0 00, .		A
:	1, 1F 1/2, X 4-0 00, .		A
:	1, 1G 1/2, X 8-0 00, .		A

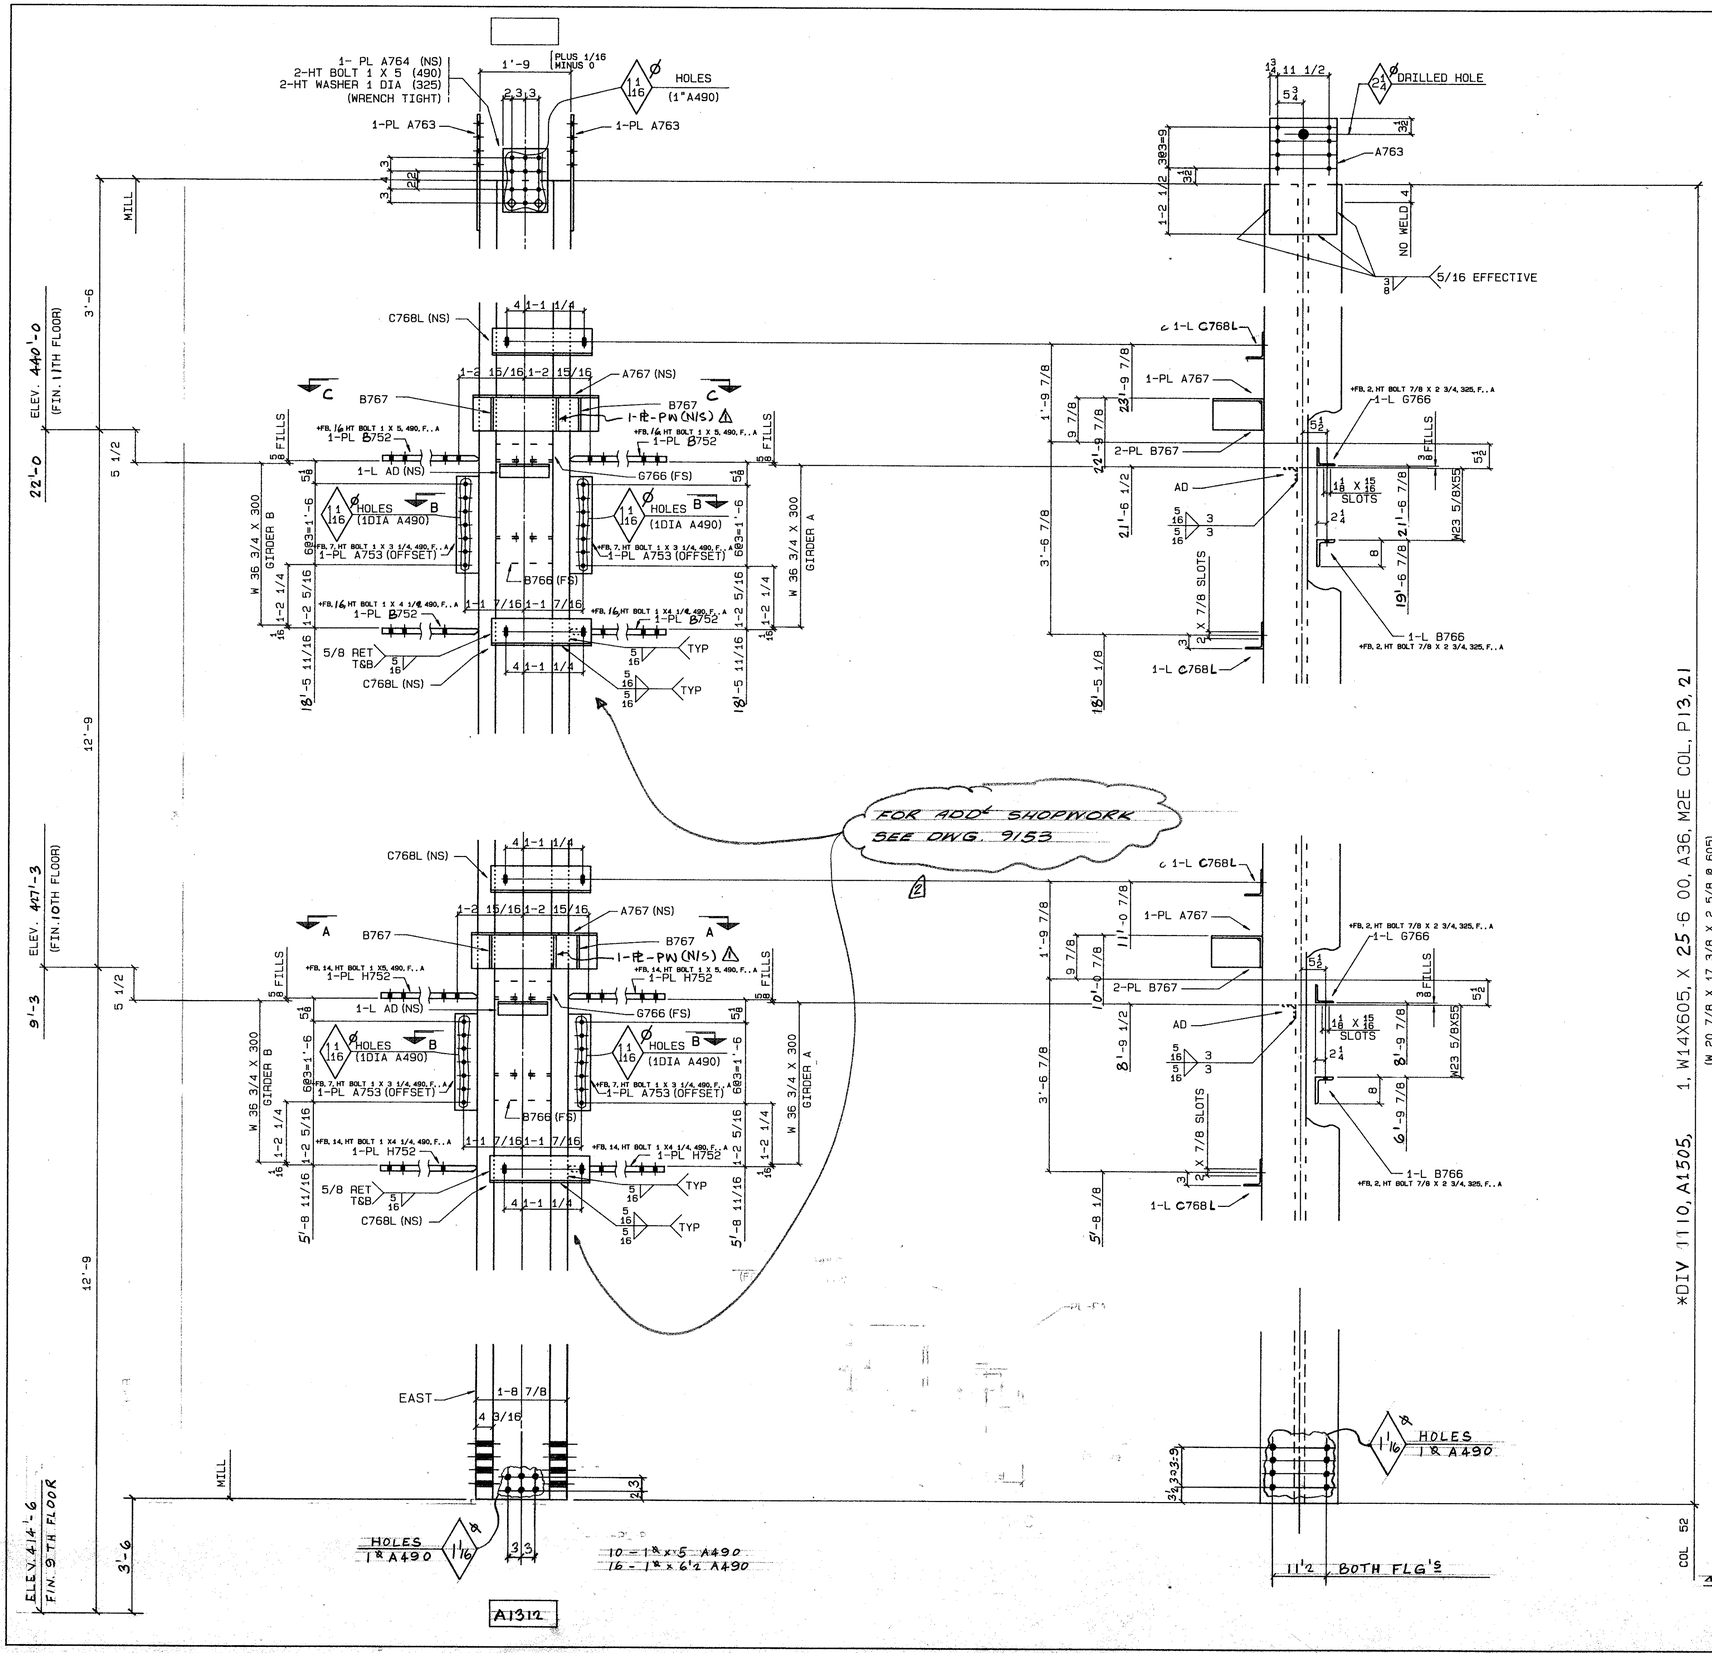

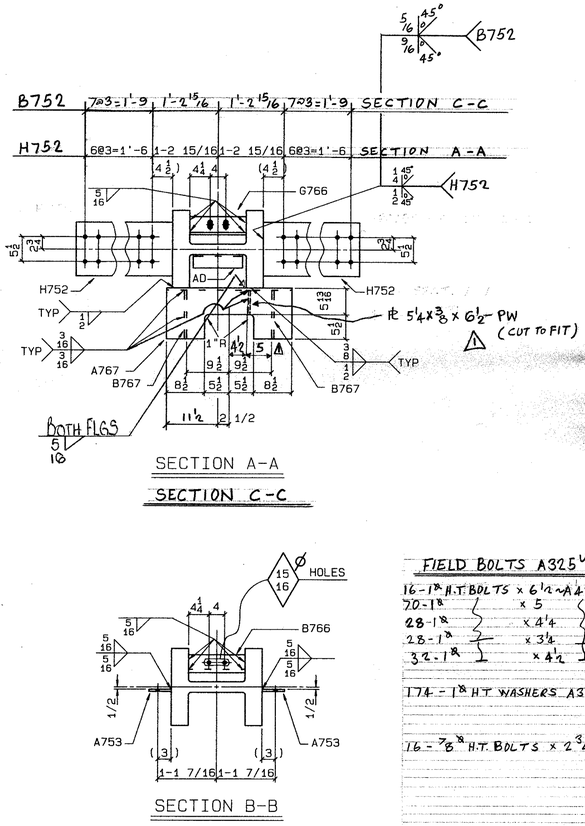

FIELD BOLTS A325 U/N

16 - 1" H.T. BOLTS	x 6 1/2 A490
70 - 1"	x 5
28 - 1"	x 4 1/4
28 - 1"	x 3 1/2
32 - 1"	x 4 1/2

174 - 1" HT WASHERS A325

16 - 7/8" H.T. BOLTS x 2 3/4

SHOP NOTES
MATERIAL G40.21 44W U/N
E70 SERIES ELECTRODES
REF. D1AG'S E10/11, 9105, 9102, E117, E118A, CW-1

DIM'S SHOWN IN BRACKETS ARE BASED ON ACCURATE COL SIZES.

SHOP SCRIBE VISIBLE C/L ON BOTH FLGS & B/S WEB TOP & BOTT.

June 14/85R
June 7/85

FOR 1 DIA A490

*DIV 1110, A1505, 1, W14X605, X 25'-6 00, A36, M2E COL, P13, 21 (W 20 7/8 X 17 3/8 X 2 5/8 @ 605)

COL 52

NOTE X33

R	3	DATE	BY	SPEC	AS NOTED
E	2	DATE JULY 6/85	BY G.M	HOLES	1 3/16 D1A U/N
V	1	DATE APR. 18 PW ADDED JUNE 12, 85	BY HSS	FINISH	NONE

FRANKEL STEEL LIMITED
220 ATTWELL DRIVE, UNIT 1, REXDALE, ONTARIO M9W 5B2

MADE 27 M.X.	DATE MAY 85	SQUAD FR	PROJECT: 7 WORLD TRADE CENTER		CONTRACT	DWG. NO.
CHK'D 28 JM	DATE MAY 85		DETAIL: COLUMNS (6TH TIER) (ZONE 2)		84-152	1505