

A1694

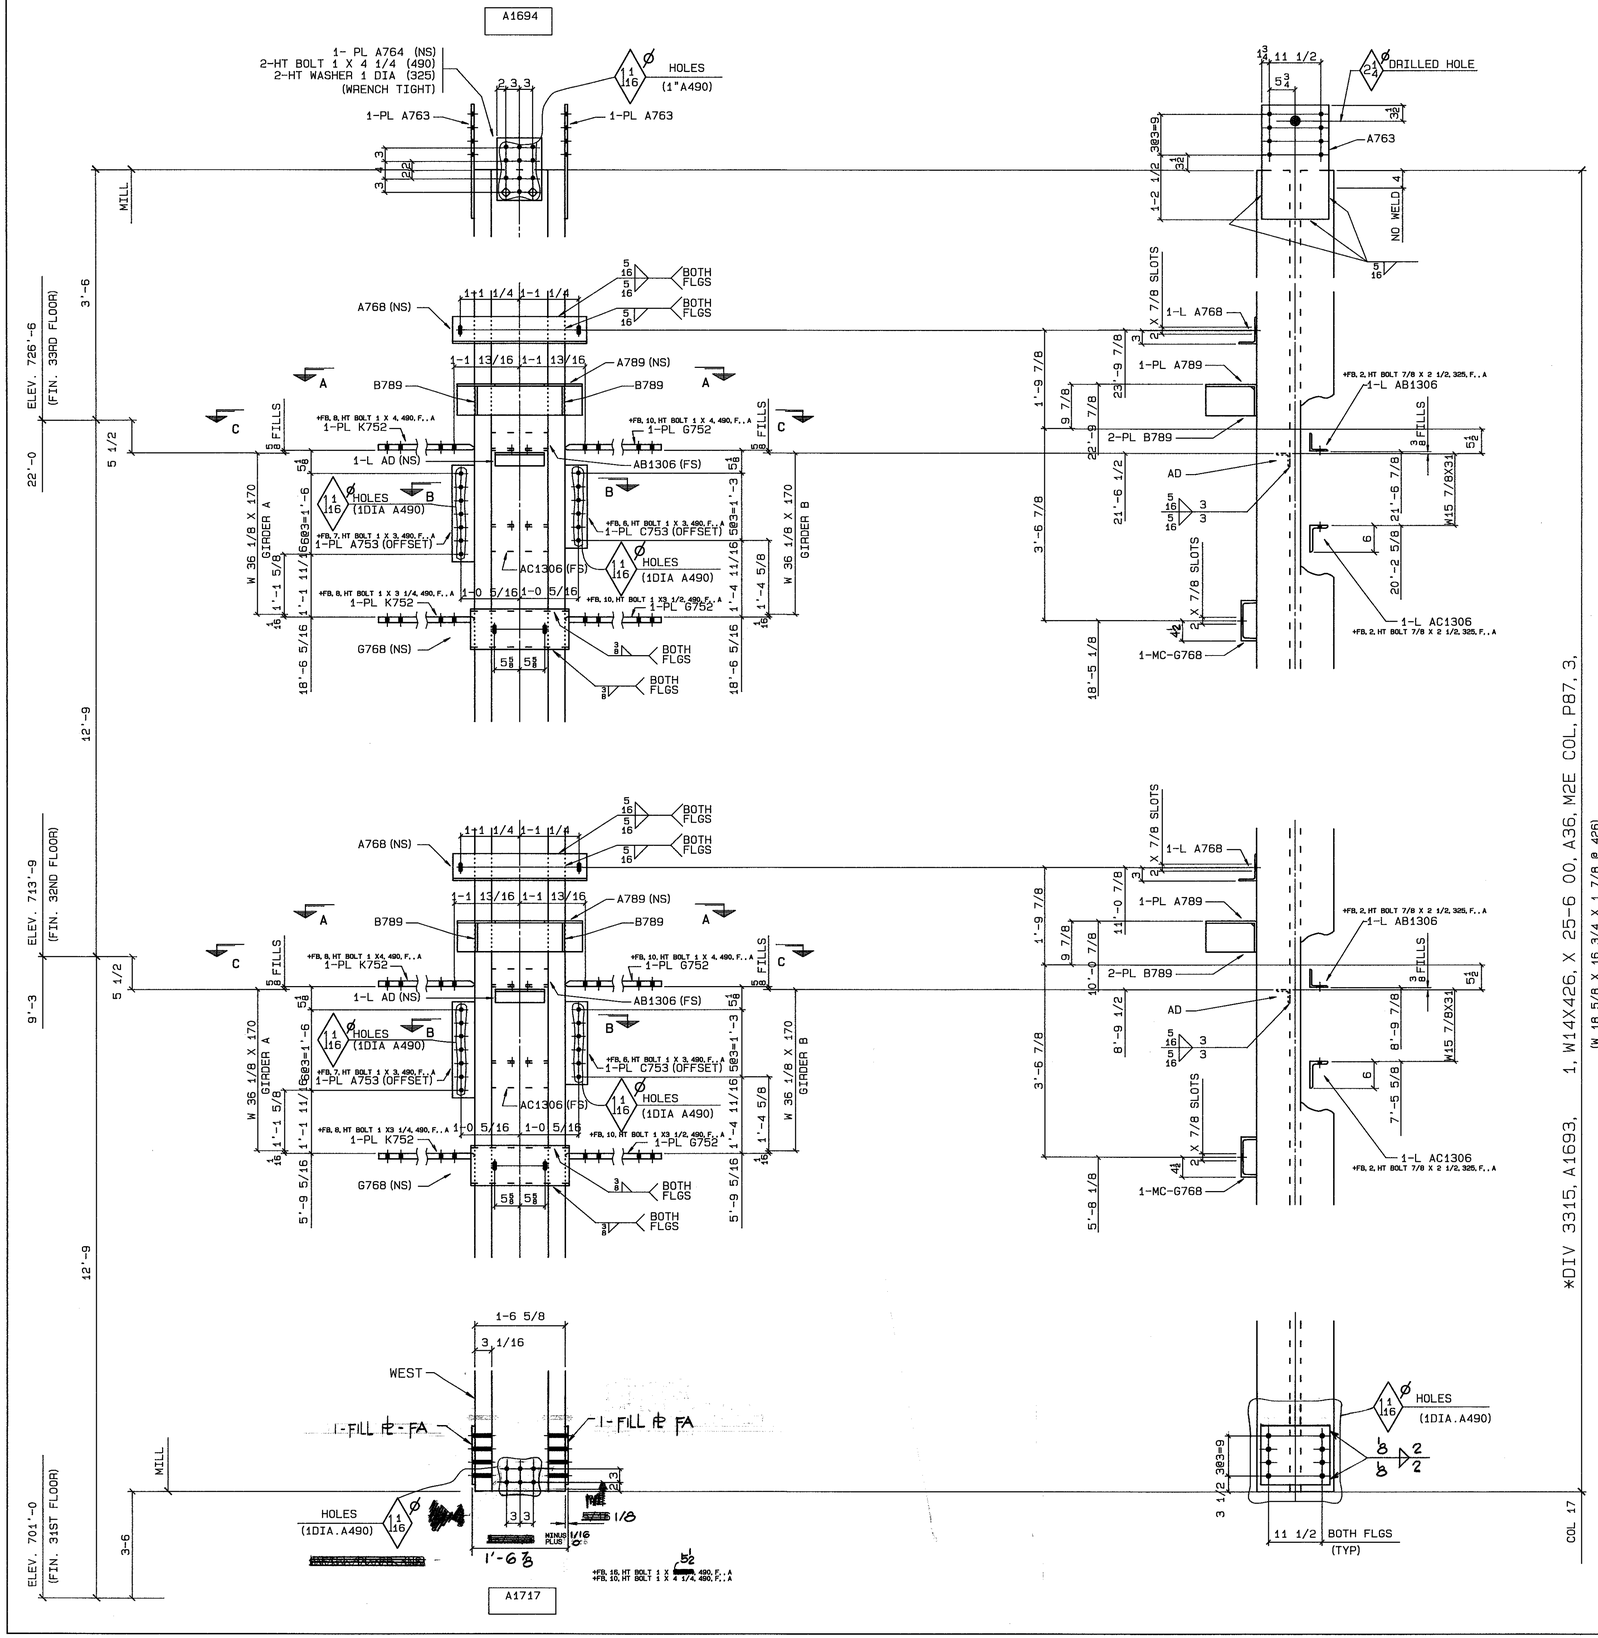


MATERIAL

: 2, PI 005 00 X00 1/2, X 1-9 1/2, A753, 44W, , , , A
: 4, PI 012 00 X00 5/8, X 1-6 1/2, G752, 44W, P1E, , , A
: 2, PI 005 00 X00 1/2, X 1-6 1/2, C753, 44W, , , , A
: 2, PI 018 1/4 X00 1/2, X 2-4 00, A789, 44W, BENT, , , A
: 4, PI 006 1/2 X00 3/8, X 0-11 1/4, B789, 44W, , , , A
: 2, PI 015 00 X00 5/8, X 2-1 1/2, A763, 44W, , , , A
: 1, PI 010 00 X00 5/8, X 1-2 00, A764, 44W, , , , A
: 4, PI 012 00 X00 1/2, X 1-3 1/2, K752, 44W, , , , A
: 2, PI **012 1/2** X00 1/8, X **1-3 00, FA**, 44W, , , , A
~~: X PI 015 00 X00 1/2, X 1-3 1/2, A763, 44W, , , , A~~
~~: X PI 005 00 X00 3/8, X 0-11 1/4, B789, 44W, , , , A~~
: 2, 9MC25.4, X1-10 00, G768, A36, , P217, 2, , A
: 2, L 6 X 4 X 5/16, X 2-6 00, A768, 44W, , , , A
: 2, L 4 X 4 X 3/8, X 1-0 1/2, AB1306, 44W, , , , A
: 2, L 6 X 4 X 3/4, X 1-0 1/2, AC1306, 44W, , , , A
: 2, L 3 X 3 X 3/8, X 0-8 00, AD, 44W, , , , A
: 2, HT BOLT 1 X 4 1/4, , 490, , , , A
~~: X HT BOLT 1 X 3, 490~~
: **2**, HT WASHER 1 , , , 325, , , , A

+FB, 124, HT WASHER 1, 325, , A
: 1, 1F 3/16, X 12-0 00, , A
: 1, 1F 5/16, X 47-0 00, , A
: 1, 1F 3/8, X 10-0 00, , A
: 1, 1F 1/2, X 4-0 00, , A
: 1, 6G 1/2, X 4-0 00, , A

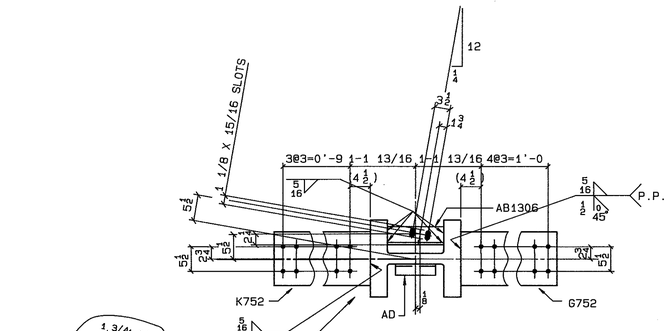


*DIV 3315, A1693, 1, W14X426, X 25-6 00, A36, M2E COL, P87, 3, (W 18 5/8 X 16 3/4 X 1 7/8 @ 426)

SHOP NOTES
MATERIAL G40.21 44W U/N
E70 SERIES ELECTRODES
REF. D1AG'S E32, E33, 9156, 9137, E118, E118A, CW-2

aug 31/85

DIM'S SHOWN IN BRACKETS ARE BASED ON ACCURATE COL SIZES.

SHOP SCRIBE VISIBLE C/L ON BOTH FLGS & B/S WEB TOP & BOTT.

FOR 1 DIA A490

| | | | | | |
|---|---|---|---|---|---|
| R 3 DATE | BY | SPEC AS NOTED | FRANKEL STEEL LIMITED | | |
| E 2 DATE | BY | HOLES 1 3/16 DIA U/N | 220 ATTWELL DRIVE, UNIT 1, REXDALE, ONTARIO M9W 5B2 | | |
| V 1 DATE | BY | FINISH NONE | | | |
| MADE 27 MIKIM | DATE 03JUL85 | SQUAD FR | PROJECT: 7 WORLD TRADE CENTER | CONTRACT 84-152 | DWG. NO. 1693 |
| CHK'D 28 GM | DATE'D AUG 17/85 | | DETAIL: COLUMN (17TH TIER) (ZONE 3) | | |