

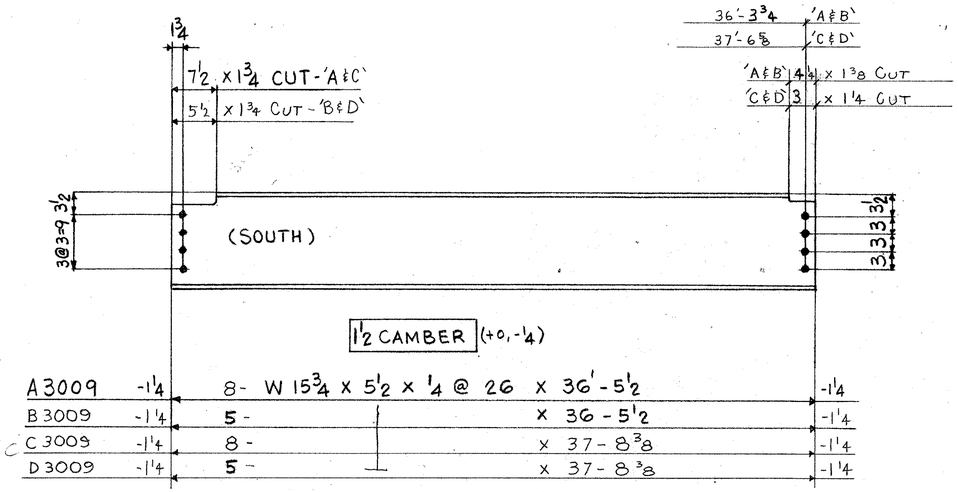


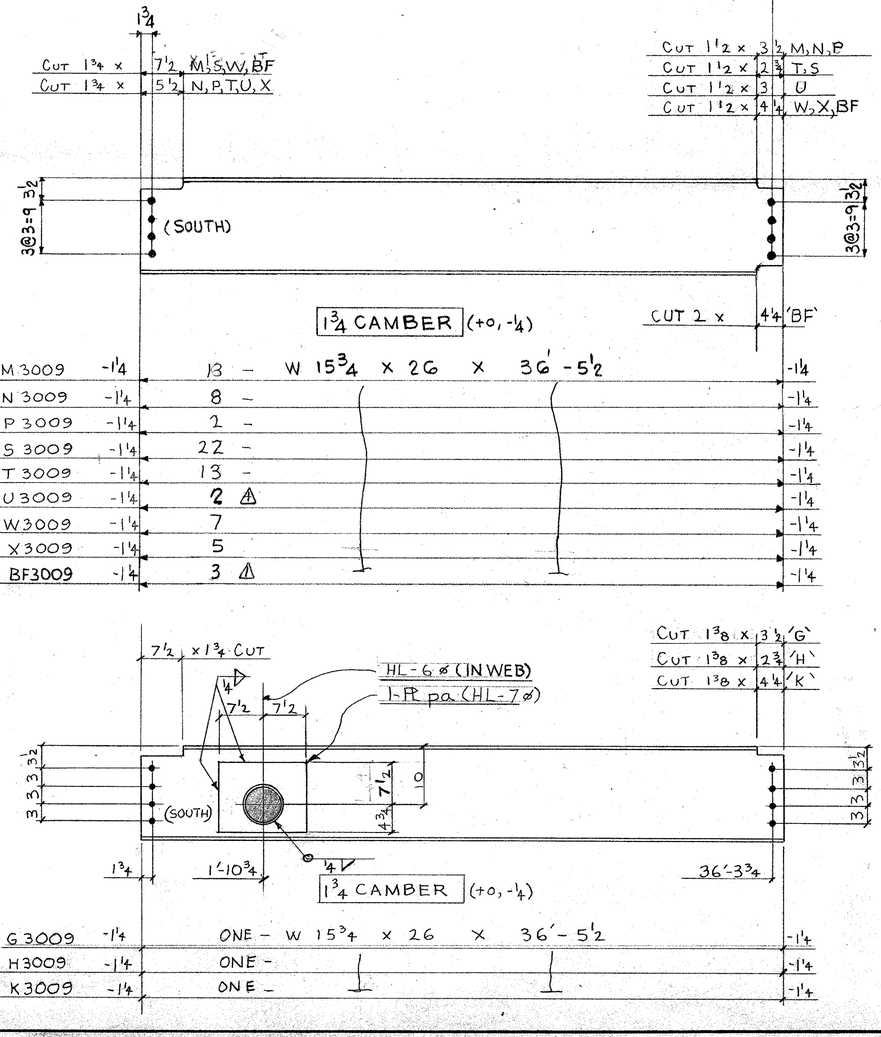

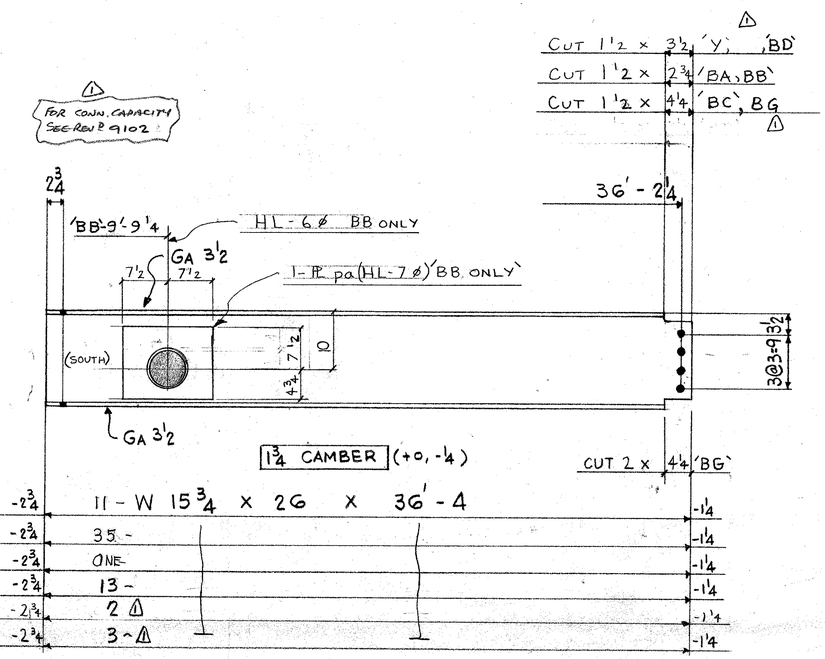

MARK \ DIV.	0901	1101	1301	1501	1701	1901	2101	0916	1116	1316	1516	1716	1916	2116	0913	1113	1313	1513	1713	1913	2113	1712
A3009	2	2	2	2																		
B3009					2	2	1															
C3009								2	2	2	2											
D3009												2	2	1								
G3009															1							
H3009															1							
K3009	1																					
M3009															1	2	2	1				
N3009																			1	2	1	
P3009																			1			
S3009															5	6	6	5				
T3009																			4	6	3	
U3009																	⚠1		2			
W3009	1	2	2	2																		
X3009					2	2	1															
BA3009															5	6	6	4	5	6	3	
BB3009															1							
BC3009	2	2	2	2	2	2	1															
BD3009																			1			1

MARK \ DIV.	0912	1112	1312	1512	1712	1912	2112	1513
Y3009	2	2	2	1	1	2	1	
M3009	2	2	2	1				
⚠1 BF3009				1				2
N3009					1	2	1	
P3009					1			
⚠1 BG3009				1				2

COMP. QUAN.	WEIGHT	NO. PCS.	ASSEM. MK.	SHAPE	LENGTH	REMARKS	SHOP OPER.	ORDERED
		8	A3009	W 16 x 26	36 5 1/2	A572 GR50		5/19
		5	B3009		36 5 1/2			5/19
		8	C3009		37 8 3/8			2/33
		5	D3009		37 8 3/8			2/33
		ONE	G3009		36 5 1/2			5/12
⚠2		ONE	pa	PL 12 1/4 x 1/2	1 3	~~A36~~ A572 GR50		
		ONE	H3009	W 16 x 26	36 5 1/2	A572 GR50		5/12
⚠2		ONE	pa	PL		~~A36~~ A572 GR50		
		ONE	K3009	W 16 x 26	36 5 1/2	A572 GR50		5/12
⚠2		ONE	pa	PL		~~A36~~ A572 GR50		
		13	M3009	W 16 x 26	36 5 1/2	A572 GR50		5/12
		8	N3009		36 5 1/2			5/12
		2	P3009		36 5 1/2			5/12
		22	S3009		36 5 1/2			5/12
		13	T3009		36 5 1/2			5/12
⚠1		2	U3009		36 5 1/2			5/12
		7	W3009		36 5 1/2			5/12
		5	X3009		36 5 1/2			5/12
		11	Y3009		36 4			5/11
		35	BA3009		36 4			5/11
		ONE	BB3009		36 4			5/11
⚠2		ONE	pa	PL		~~A36~~ A572 GR50		
		13	BC3009	W 16 x 26	36 4	A572 GR50		5/11
⚠1		2	BD3009		36 4			5/11
⚠1		3	BF3009		36 5 1/2			5/12
⚠1		3	BG3009		36 4			5/11

May 30/85 R
⚠2 CALLED 55C MAY 30
May 16/85

SHOP NOTES

MAT'L AS NOTED

USE E70 SERIES ELECTRODES

REF. DWG. E8 to E21, S24, 901

AISC MEMBER OF STEEL CONSTRUCTION PROVIDED HERE

REVISIONS	
⚠2	MAY 30/85 - PL pa REV'D TO A572 GR50 (2ND APPR.)
⚠1	MAY 16/85 TO APPROVAL AND X22 REV. TO 14W. PL BETWEEN COL. 6 & 7

STEEL STRUCTURES CORP.

□ MAIN OFFICE
120 PLEASANT AVE.
P.O. BOX 98
UPPER SADDLE RIVER, N.J. 07458

□ SUBSIDIARY
BETHLEHEM IRON WORKS, INC.
1700 RIVERSIDE DRIVE
BETHLEHEM, PA. 18015

BEAMS
7 WORLD TRADE CENTRE
NEW YORK

BOLTS HOLES 15/16 ø
PAINT SSPC SP2 NO PAINT
DRAWN BY T.M.T.
CHECK BY W.M.
IN CHARGE OF F.R.
CONT. NO. C1275
SH. NO. 3009