


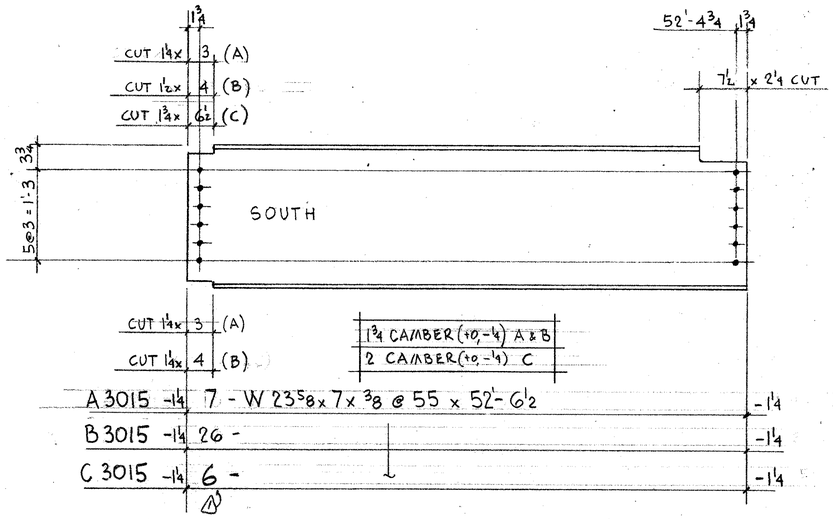


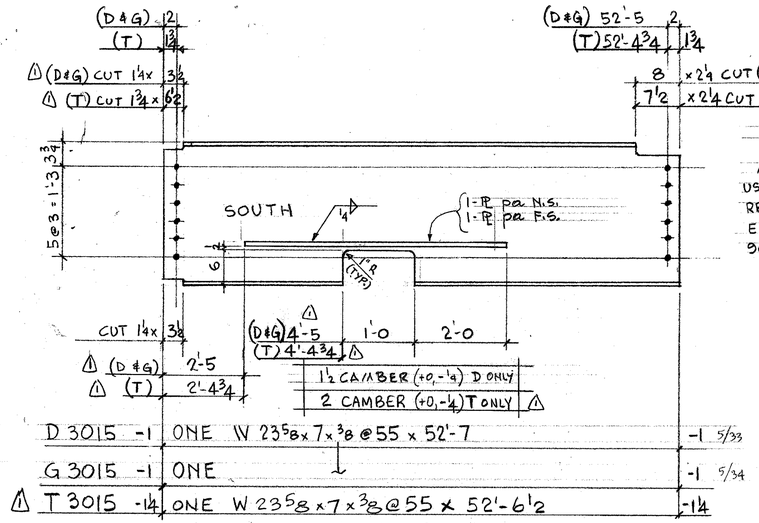


SHOP NOTE

MATERIAL AS NOTED
USE E70 SERIES ELECTRODES
REF. DWG'S: E 8/9, E 10/11, E 12/13
E 14/15, E 16/17, E 18/19, E 20, E 21
901, 9100, S 24

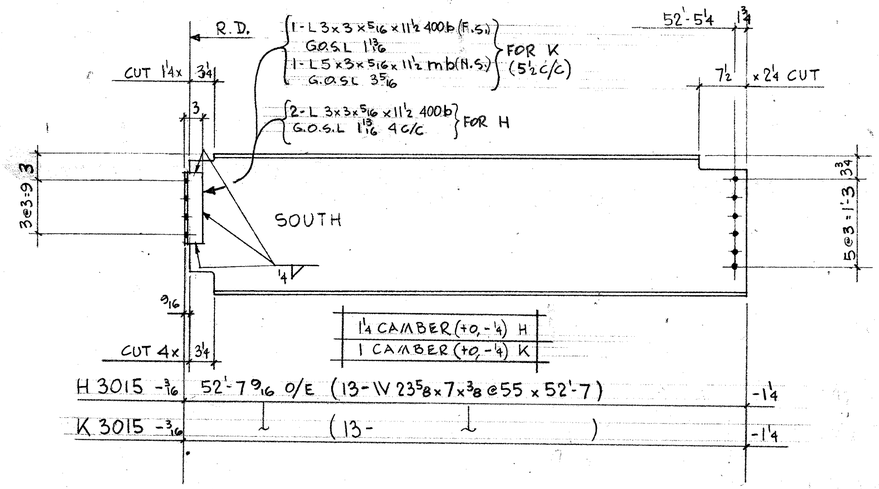

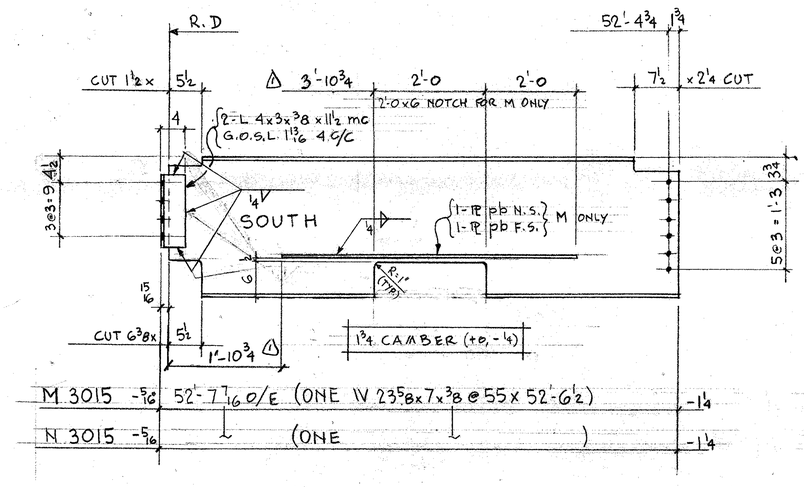

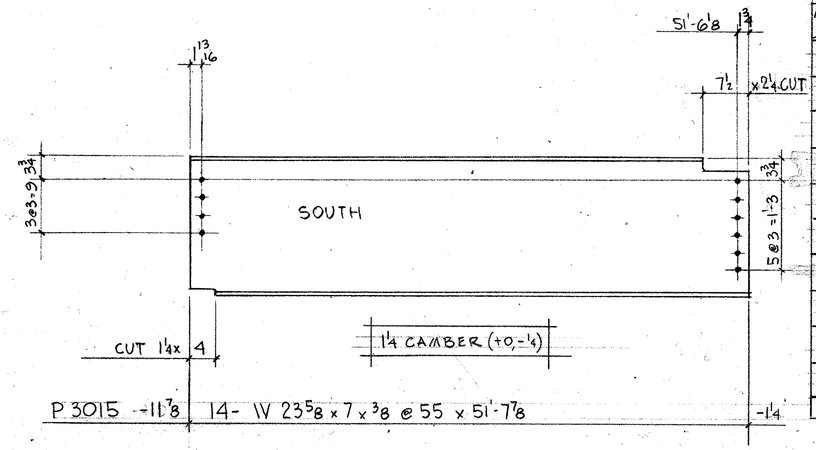

MARK / DIV.	0904	1104	1304	1504	1704	1904	2104	0911	1111	1311	1511	1711	1911	2111	0914	1114	1314	1514	1714	1914	2114	0918	1118	1318	1518	1718	1918	2118
A 3015																						1	1	1	1	1	1	1
B 3015								4	4	4	4	4	4	2														
C 3015																						1	1	1	1	1	1	
D 3015																					1							
G 3015																					1							
H 3015															2	2	2	2	2	2	1							
K 3015															2	2	2	2	2	2	1							
M 3015														1														
N 3015														1														
P 3015	2	2	2	2	2	2	2																					
T 3015																												

COMP. QUAN.	WEIGHT	NO. PCS.	ASSEM. MK.	SHAPE	LENGTH	REMARKS	SHOP OPER.	ORDERED
		7	A3015	W24x55	52 6½	A572 GR50		2/12
		26	B3015	W24x55	52 6½			2/12
		6	C3015	W24x55	52 6½			2/12
1		~~1~~	~~C3015~~	~~W24x55~~	~~52 6½~~			~~5/34~~
		1	D3015	W24x55	52 7			5/33
		2	PA	PL 3½x1½	5 0			22/5
		1	G3015	W24x55	52 7			5/34
		2	PA	PL 3½x1½	5 0			22/5
		13	H3015	W24x55	52 7	↓		2/17
		26	400B	L 3x3x5/16	0 11½	A36		
		13	K3015	W24x55	52 7	A572 GR50		2/18
		13	400B	L 3x3x5/16	0 11½	A36		
		13	MB	L 5x3x5/16	0 11½	↓		
		1	M3015	W24x55	52 6½	A572 GR50		2/12
		2	MC	L 4x3x3/8	0 11½	A36		
		2	PB	PL 3½x1½	6 0	A572 GR50		22/6
		1	N3015	W24x55	52 6½	A572 GR50		2/12
		2	MC	L 4x3x3/8	0 11½	A36		
		14	P3015	W24x55	51 7⅞	A572 GR50		2/24
1		1	T3015	W24x55	52 6½	A572 GR50		5/31
1		2	PA	PL 3½x1½	5 0	A572 GR50		30/3

June 6/85

REVISIONS
1-C3015 CANCELLED
1-T3015 ADDED
1-D3015 & 1-G3015 REVD
1-M3015 REVD
JUNE 5/85 - BF (X28)

STEEL STRUCTURES CORP.

□ MAIN OFFICE
120 PLEASANT AVE.
P.O. BOX 98
UPPER SADDLE RIVER, N.J. 07458

□ SUBSIDIARY
BETHLEHEM IRON WORKS, INC.
1700 RIVERSIDE DRIVE
BETHLEHEM, PA. 18015

BEAMS (8TH TO 21ST FLOOR)
7 WORLD TRADE CENTER
NEW YORK

BOLTS 7/8ϕ A325	HOLES 15/16ϕ U/N
PAINT SSPC SP 2 (NO PAINT)	
DRAWN BY H.W.	CONT. NO. C 1275
CHECK BY ES 21-5-85	SH. NO. 3015
IN CHARGE OF F.R.	