


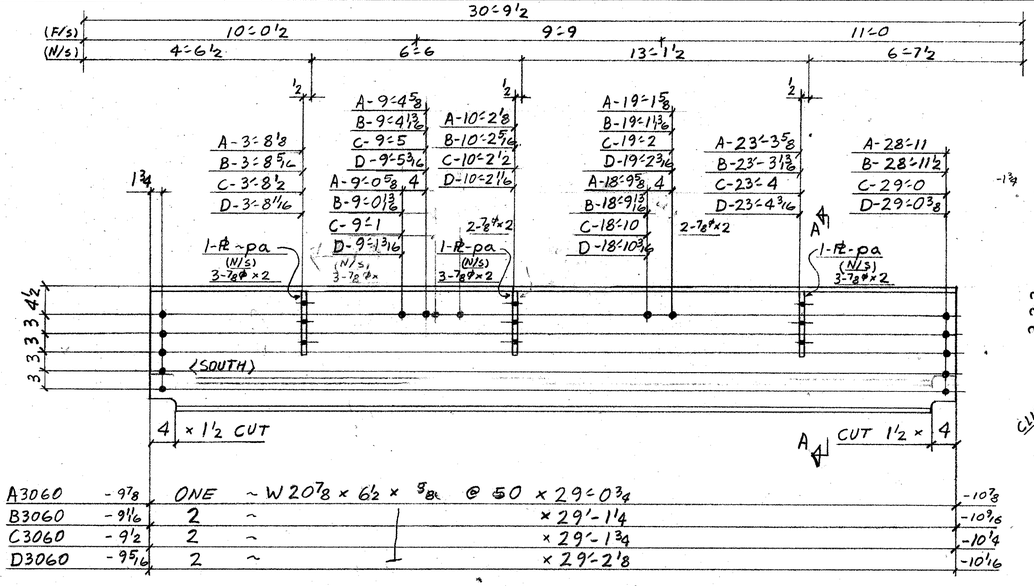


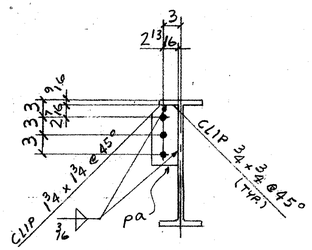


SECT. A-A

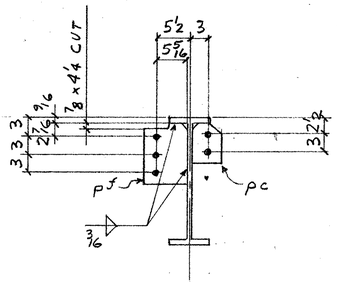


SECT. D-D

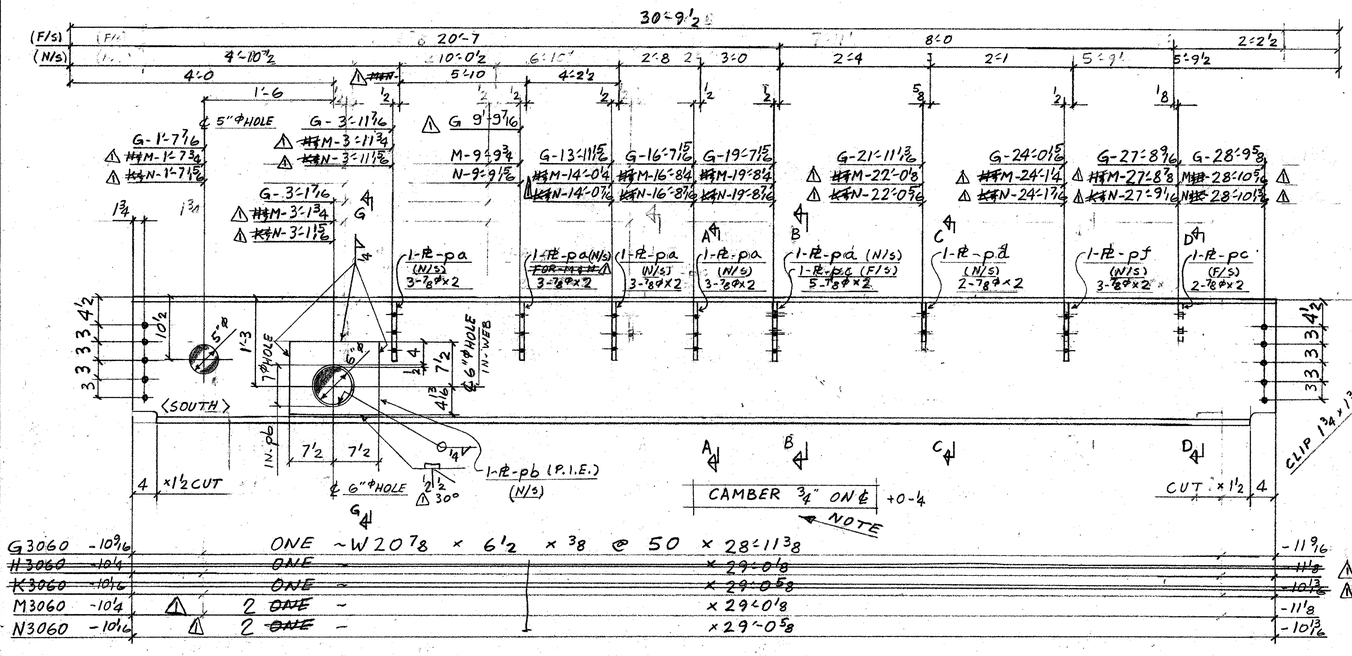

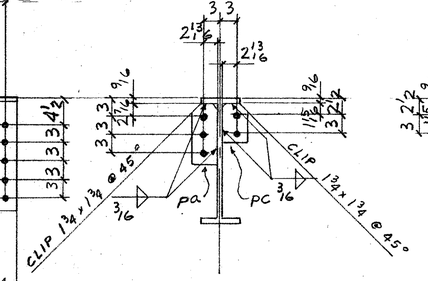


SECT. B-B

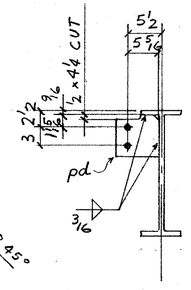

SECT. C-C

MARK / DIV.	2508	2708	2908	3108
A3060	1			
B3060		2		
C3060			2	
D3060				2
G3060	1			
H3060		#		
K3060			#	
M3060		#		
N3060			#	

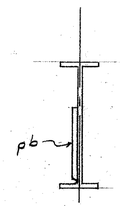

SECT. G-G

FIELD BOLTS

2 11 ~~202~~ - 7/8"Ø A325 x 2

SHOP NOTES
MAT'L AS NOTED
E70 SERIES ELECTRODES
REF. DWG. E25 TO E31
901, 9154

COMP. QUAN.	WEIGHT	NO. PCS.	ASSEM. MK.	SHAPE	LENGTH	REMARKS	SHOP OPER.	ORDERED
		1	A3060	W21 x 50	29 0 3/4	A572 GR50		12/13
		2	B3060		29 1 1/4			12/14
		2	C3060		29 1 3/4			12/15
		2	D3060		29 2 1/8			12/16
		21	pa	PL 4 3/4 x 3/8	0 10	A36		
		1	G3060	W21 x 50	28 11 3/8	A572 GR50		12/21
		~~1~~	~~H3060~~		~~29 0 3/8~~			~~12/22~~
		~~1~~	~~K3060~~		~~29 0 5/8~~			~~12/23~~
		2 ~~1~~	M3060		29 0 1/8			12/22
		2 ~~1~~	N3060		29 0 5/8			12/23
		25 ~~22~~	pa	PL 4 3/4 x 3/8	0 10	A36		
		10	pc	PL 4 3/4 x 3/8	0 6 1/2			
		5	pd	PL 6 1/2 x 3/8	0 7 7/8			
		5	pf	PL 7 3/8 x 3/8	0 10			
		5	pb	PL 12 5/16 x 1/2	1 3	A572 GR50		

Aug. 7/85

REVISIONS
BEAMS H & K CANCELLED
BEAMS M & N QUANTITY REV.
BEAM G CONN. ADDED
D.Z. Aug. 29/85

X44

STEEL STRUCTURES CORP.

☐ MAIN OFFICE
120 PLEASANT AVE.
P.O. BOX 98
UPPER SADDLE RIVER, N.J. 07458

☐ SUBSIDIARY
BETHLEHEM IRON WORKS, INC.
1700 RIVERSIDE DRIVE
BETHLEHEM, PA. 18015

BEAMS (25TH TO 31ST FLR.)

7 WORLD TRADE CENTER
NEW YORK

BOLTS 7/8"Ø A325 HOLES 15/16"Ø
PAINT SSPC SP2 (NO PAINT)
DRAWN BY SF
CHECK BY D.Z. JULY 26/85
IN CHARGE OF FR
CONT. NO. C1275
SH. NO. 3060

AISC MEMBER OF STEEL CONSTRUCTION INSTITUTE