



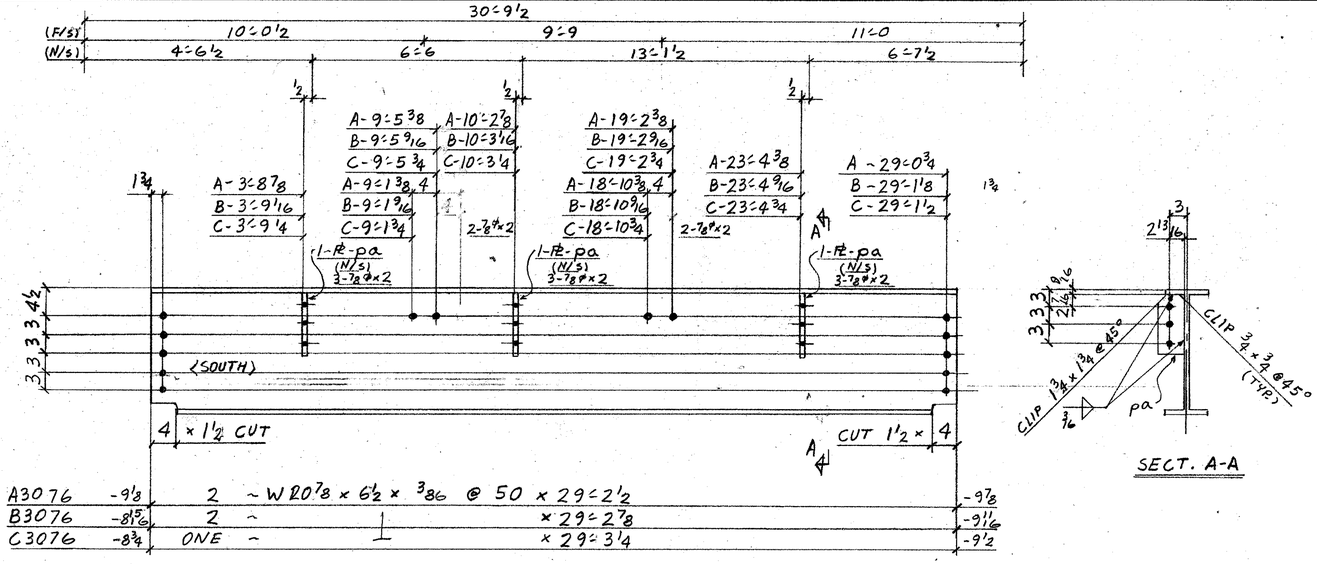


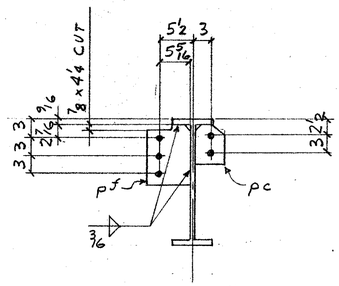

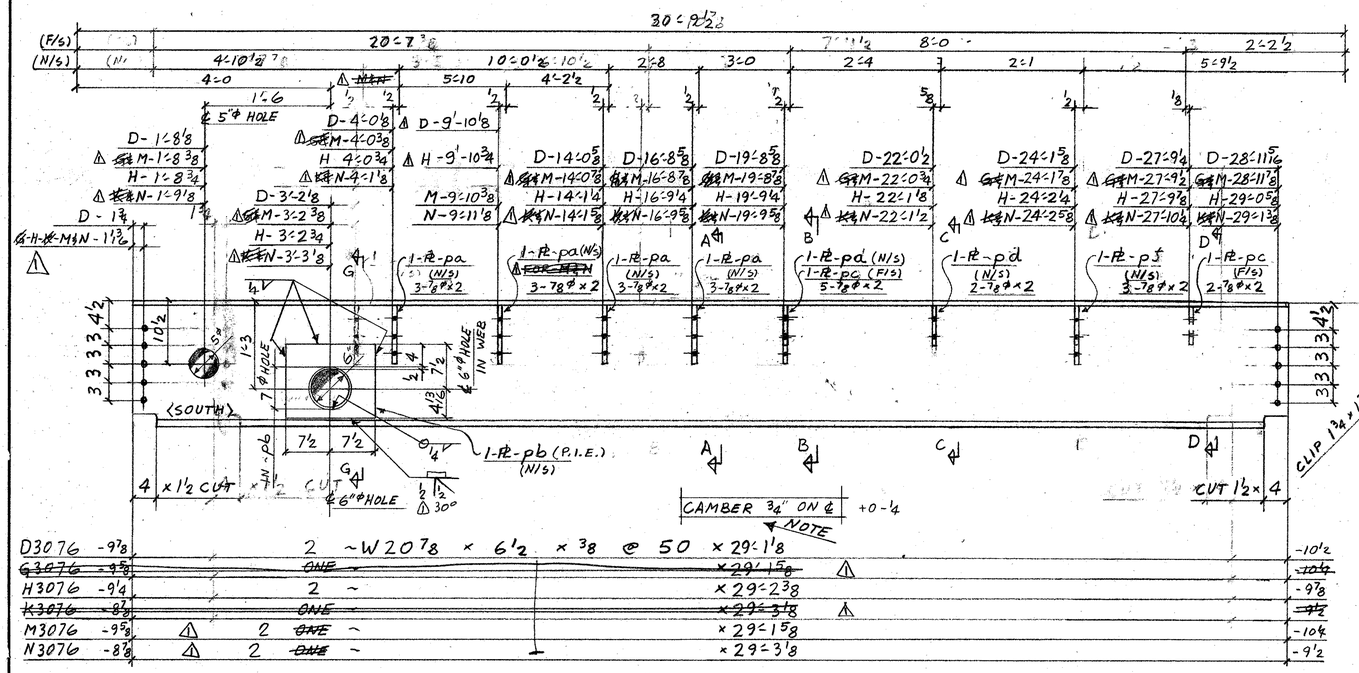

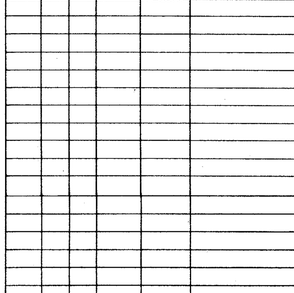

MARK / DW.	3108	3308	3508	3708
A3076		2		
B3076			2	
C3076				1
D3076	2			
~~G3076~~		~~=~~		
H3076			2	
~~K3076~~				~~=~~
M3076		?=		
N3076				?=

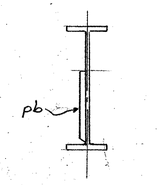

SHOP NOTES
MAT'L AS NOTED
E70 SERIES ELECTRODES
REF. DWG. E30 TO E37
901, 9154

FIELD BOLTS
1 857 ~~239~~ - 7/8"ø A325 x 2
~ x

COMP. QUAN.	WEIGHT	NO. PCS.	ASSEM. MK.	SHAPE	LENGTH	REMARKS	SHOP OPER.	ORDERED
		2	A3076	W21 x 50	29 2 1/2	A572 GR50		12/17
		2	B3076		29 2 7/8			12/18
		1	C3076		29 3 1/4			12/19
		15	pa	PL 4 3/4 x 3/8	0 10	A36		
		2	D3076	W21 x 50	29 1 1/8	A572 GR50		12/24
		~~1~~	~~G3076~~		~~29 1 5/8~~			~~12/25~~
		2	H3076		29 2 3/8			12/26
		~~1~~	~~K3076~~		~~29 3 1/8~~			~~12/27~~
		2 ?	M3076		29 1 5/8			12/25
		2 ?	N3076		29 3 1/8			12/27
		40 ~~34~~	pa	PL 4 3/4 x 3/8	0 10	A36		
		16	pc	PL 4 3/4 x 3/8	0 6 1/2			
		8	pd	PL 6 1/2 x 3/8	0 7 3/8			
		8	pf	PL 7 3/8 x 3/8	0 10			
		8	pb	PL 12 5/16 x 1/2	1 3	A572 GR50		

REVISIONS
1 BEAMS G & K CANCELLED BEAMS M & N QUANTITY REV. BEAMS D & H CONNECTION ADDED D.Z. AUG. 29/85

x44

Aug 7/85

STEEL STRUCTURES CORP.

□ MAIN OFFICE
120 PLEASANT AVE.
P.O. BOX 98
UPPER SADDLE RIVER, N.J. 07458

□ SUBSIDIARY
BETHLEHEM IRON WORKS, INC.
1700 RIVERSIDE DRIVE
BETHLEHEM, PA. 18015

BEAMS (30TH TO 37TH FLR.)

7 WORLD TRADE CENTER
NEW YORK

BOLTS 7/8"ø A325 HOLES 15/16"ø
PAINT SSPC SP2 (NO PAINT)
DRAWN BY: SF
CHECK BY D.Z. JULY 26/85
IN CHARGE OF FR
CONT. NO. C1275
SH. NO. 3076