



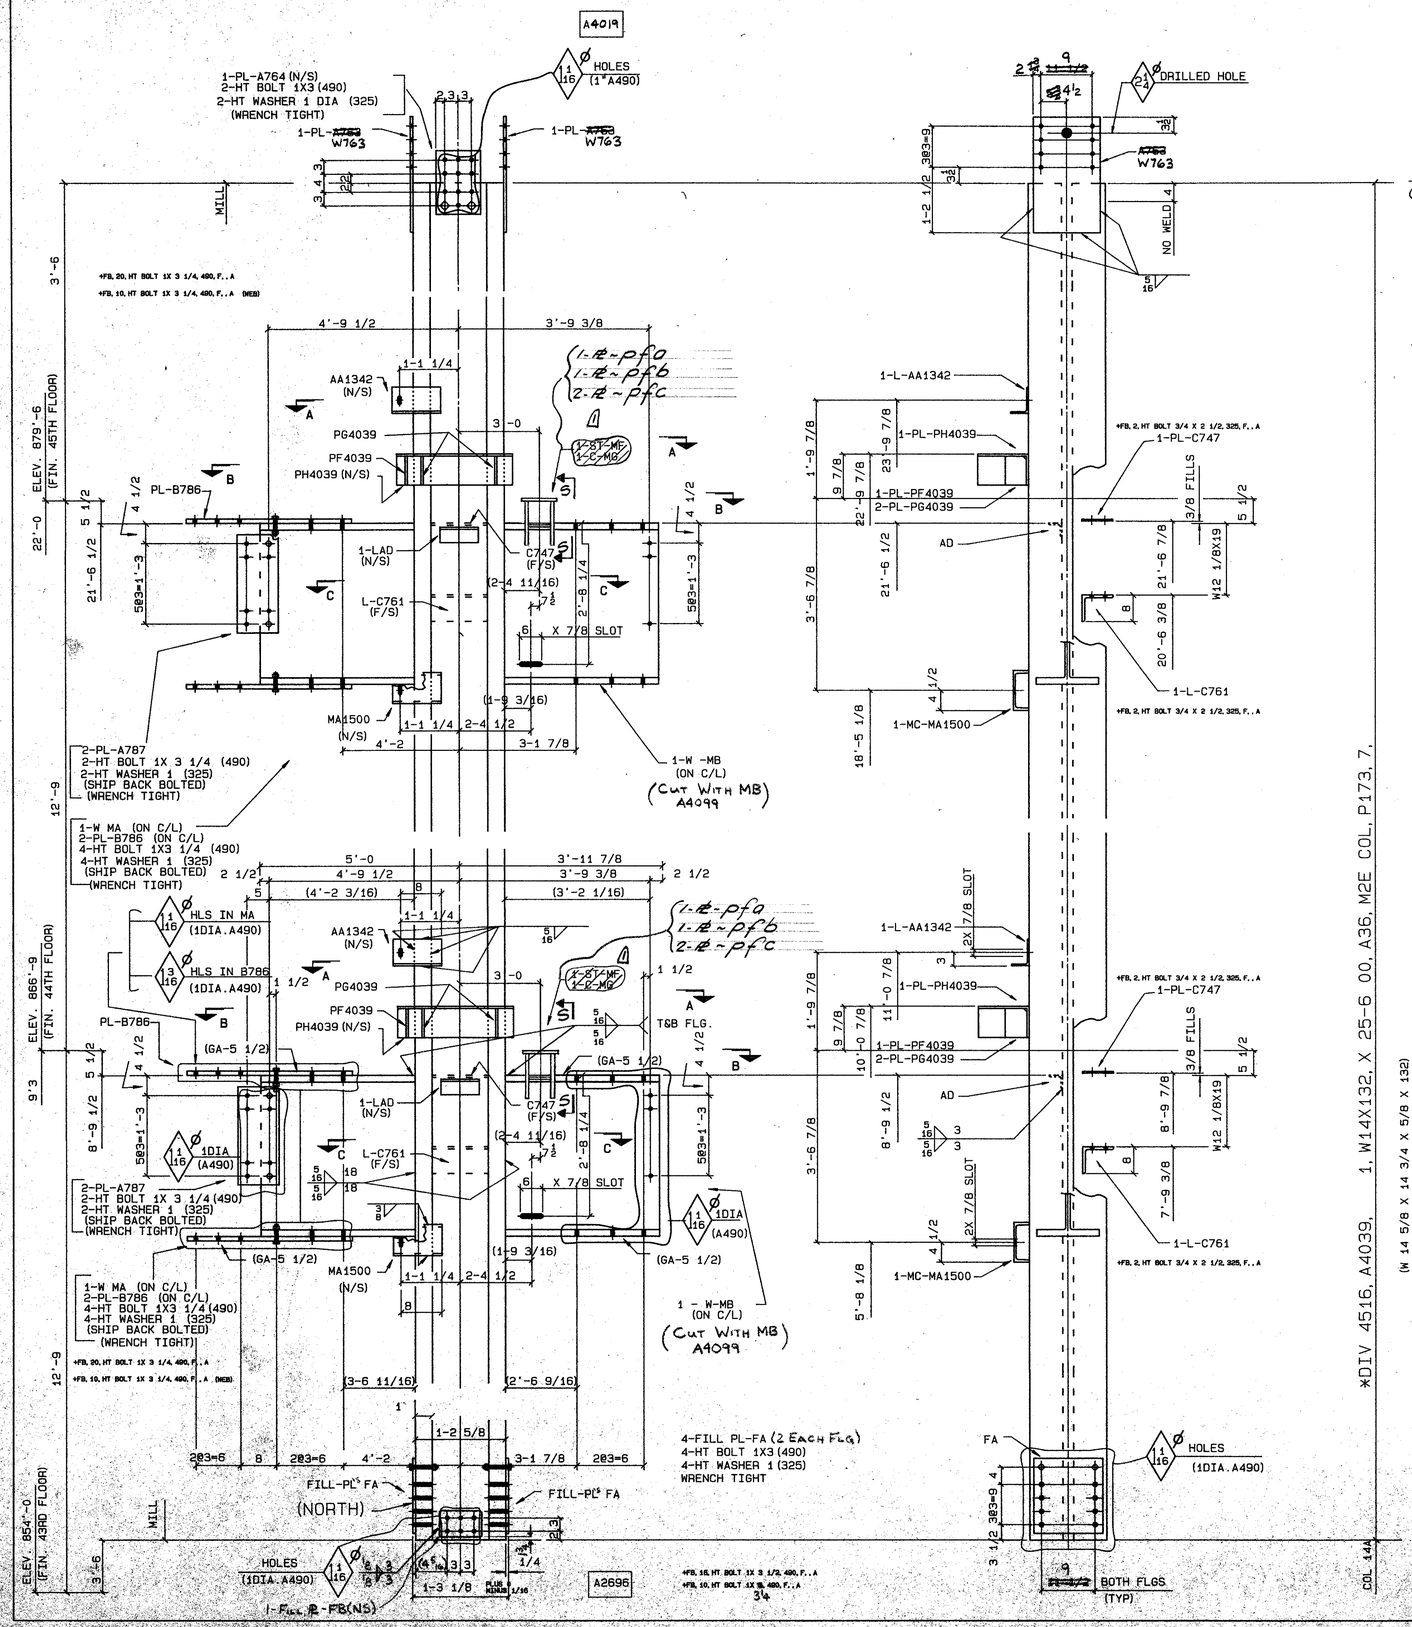


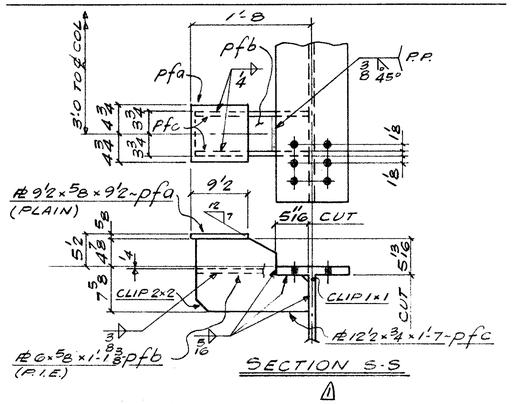

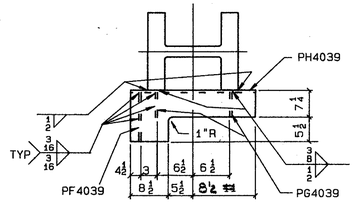

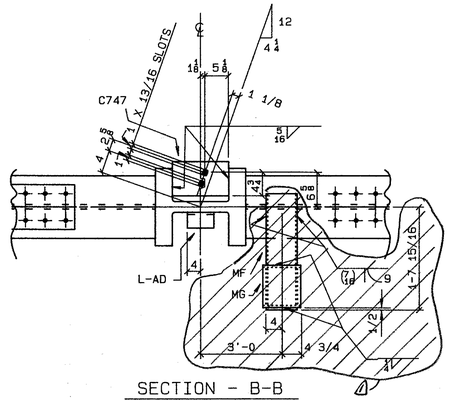

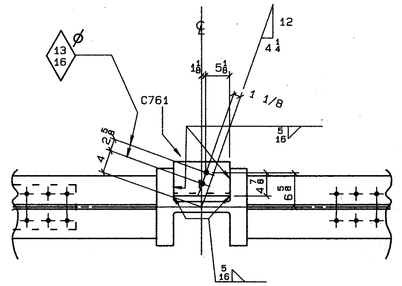

13 x 3/4

MATERIAL

~~: 2, 9015, X 0-9 1/2, MG, A36, , P159, 23, , A~~ (6)
~~: 2, ST 8 X 3 X 313, X 1-11 00, MF, A500GRB, , P159, 22, , A~~
: 4, PI 006 1/2 X00 3/8, X 0-6 3/4, PG4039, 44W, , , , , A
: 2, PI ~~015 00~~ ~~X00 5/8~~, X 2-1 1/2, W763, 44W, , , , A
: 2, PI 006 1/2 X00 3/8, X 1-0 1/4, PF4039, 44W, , , , A
: 2, PI 019 1/4 X00 1/2, X ~~2-1 1/2~~, PH4039, 44W, BENT, , , , A 1'-10 1/2
: 2, PI 006 1/2 X00 3/8, X 1-0 1/2, C747, 44W, , , , A
: 4, PI 008 1/2 X00 1/2, X 1-6 1/2, A787, 44W, , , , A

: 2, L 6 X 4 X 5/16, X 0-9 1/2, AA1342, 44W, , , , , A
: 2, L 8 X 6 X 3/4, X 1-0 1/2, C761, 44W, , , , A
: 2, L 3 X 3 X 3/8, X 0-8 00, AD, 44W, , , , A
: 1, PI, 6'2 x 1'8 x 9'2, FB, 44W

: 2, 9MC25.4, X 0-9 1/2, MA1500, A36, , ~~P147~~ P218, 2, , A
~~: 2, PI 009 00 X00 3/4, X 2-5 1/2, A786, 44W, , , , A~~
: 1, PI 010 00 X00 5/8, X 1-2 00, A764, 44W, , , , A

: 12, HTBOLT 1X3 1/4, , 490, , , , A

: 6, HTBOLT 1X3, , 490, , , , A

: 18, HT WASHER 1, , , 325, , , , A
+FB, 86, HT WASHER 1, 325, , , A
: 1, 1F 3/16, X12-0 00, , A
: 1, 1F 5/16, X50-0 00, , A
: 1, 1F 1/2, X~~6-0 00~~ 3'-0, , A
: 1, 1F 3/8, X~~3-0 00~~ 1'-0, , A
: 1, 1F 1/4, X3-0 00, , A
: 2, W36X150, X 4-4 3/16, MA, A36, CUT B743, P170, 4, , A
: 2, W36X150, X 3-4 1/16, MB, A36, CUT C744, P170, 7, , A
: 4, PI 009 00 X00 1/2, X 1-11 1/2, B786, 44W, , , , , A
: 4, PI ~~018 00~~ 013 00 X00 ~~3/16~~ 1/8, X ~~1-1 1/2~~ 1-5 00, FA, 44W, , , , A

*DIV 4516, A4039, 1, W14X132, X 25-6 00, A36, M2E COL, P173, 7, (W 14 5/8 X 14 3/4 X 5/8 X 132)

SHOP NOTES
MATERIAL G40.21-44W U/N
E70 SERIES ELECTRODES
REF. DWGS. E44, E45, 9130, E118A, CW2, 9172, E118

22Jul/85 R
NOV 4/85

DIM'S SHOWN IN BRACKETS ARE BASED ON ACCURATE COL SIZES.

SHOP SCRIBE VISIBLE C/L ON BOTH FLGS & B/S WEB TOP & BOTT.

FOR 1DIA.A490

R	3	DATE	BY	SPEC	AS NOTED	FRANKEL STEEL LIMITED	
E	2	DATE	BY	HOLES	1 3/16 DIA U/N	220 ATTWELL DRIVE, UNIT 1, REXDALE, ONTARIO M9W 5B2	
V	1	DATE NOV 14/85	BY GM	FINISH	NONE		
MADE 27 MB		DATE 22AUG85	SQUAD FR	PROJECT: 7 WORLD TRADE CENTER		CONTRACT 84-153	DWG. NO. 4039
CHK'D 28 BF		DATE OCT 31/85		DETAIL: COLUMN (23RD TIER) ZONE 4			

BRKT REV'D SEE SECT'S-5