

A4025

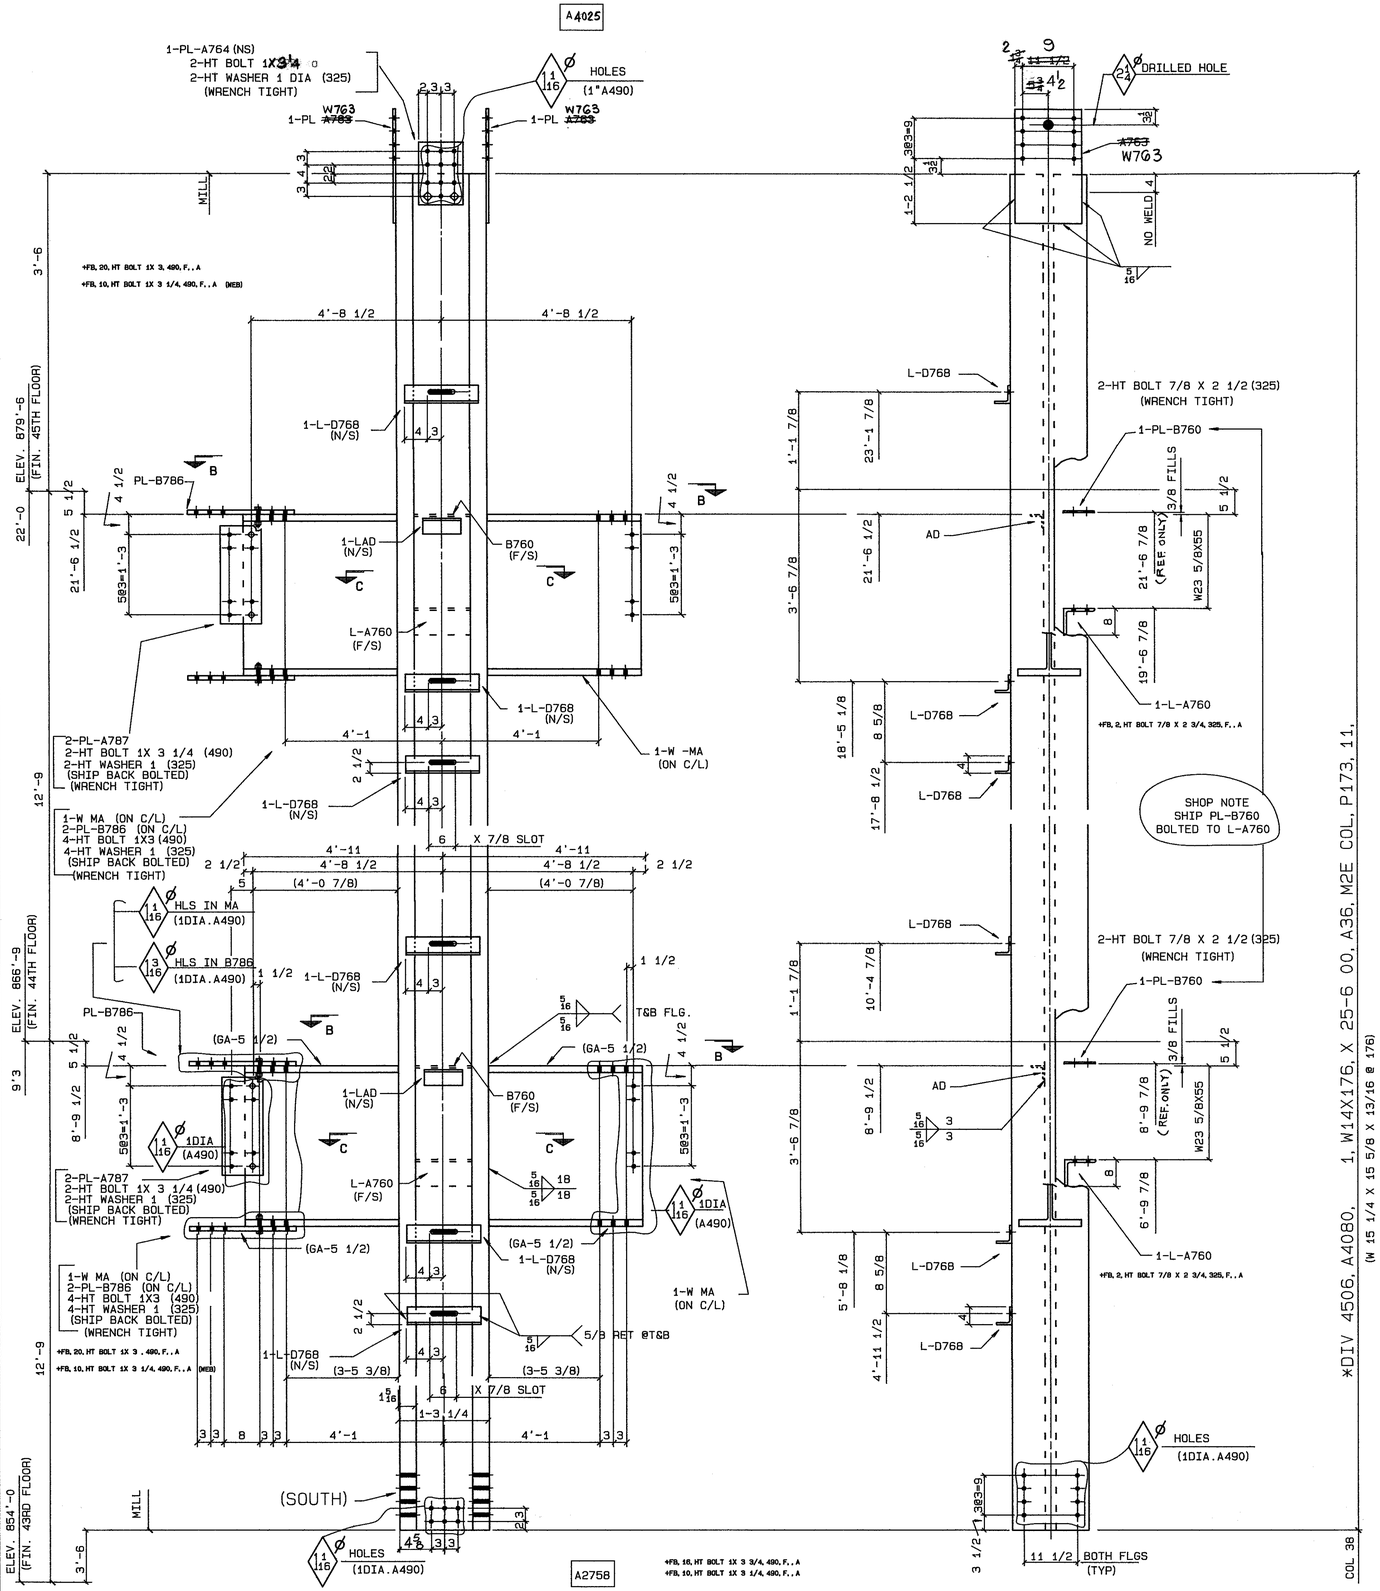


*DIV 4506, A4080, 1, W14X176, X 25-6 00, A36, M2E COL, P173, 11, (W 15 1/4 X 15 5/8 X 13/16 @ 176)

A2758

+FB, 16, HT BOLT 1X 3 3/4, 490, F., A
+FB, 10, HT BOLT 1X 3 1/4, 490, F., A

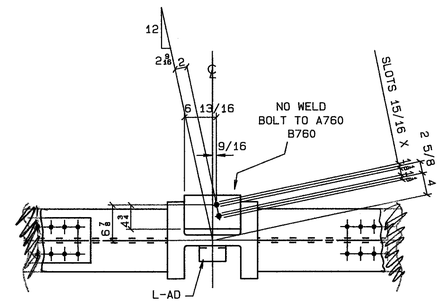

SECTION - B-B

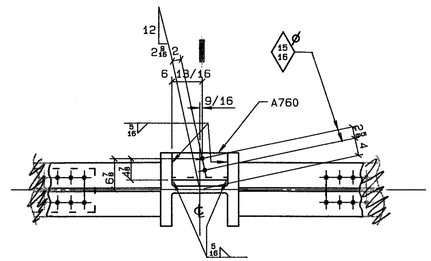

SECTION-C-C

MATERIAL

: 1, PI 010 00 X00 5/8, X 1-2 00, A764, 44W, , , , A
: ~~2, PI 015 00 X00 5/8, X 2-1 1/2, A763, 44W, , , , A~~
: 4, PI 009 00 X00 1/2, X 1-11 1/2, B786, 44W, , , , A
: 2, PI 006 1/2 X00 3/8, X 1-0 1/2, B760, 44W, , , , A
: 4, PI 008 1/2 X00 1/2, X 1-6 1/2, A787, 44W, , , , A
: 2, L 8 X 6 X 3/4, X 1-0 1/2, A760, 44W, , , , A
: 6, L 4 X 3 X 3/8, X 1-2 00, D768, 44W, , , , A
: 2, L 3 X 3 X 3/8, X 0-8 00, AD, 44W, , , , A
: 2 PI 13 X 3/4 X 2'-1 1/2 - W763 , 44W , , , , A

: 4, W36X135, X 4-2 7/8, MA, A36, CUT A740, 44W, , , A

: 6, HT BOLT 1X 3 1/4, , , 490, , , , , A
: 8, HT BOLT 1X 3 , , , 490, , , , , A
: 14, HT WASHER 1, , , 325, , , , A
+FB, 86, HT WASHER 1, 325, , A

: 1, 1F 5/16, X 45'-0 ~~22'-4~~ 00, , A
: ~~1, 1F 3/8, X 10-8 00, , A~~

SHOP NOTES
MATERIAL G40.21-44W U/N
E70 SERIES ELECTRODES
REF. DWGS. ~~S45-543-1327~~, E118A, CW2, 9172, E118
E44, E45, 9128

Nov 12/85

DIM'S SHOWN IN BRACKETS ARE BASED ON ACCURATE COL SIZES.

SHOP SCRIBE VISIBLE C/L ON BOTH FLGS & B/S WEB TOP & BOTT.

FOR 1DIA.A490

R	3	DATE	BY	SPEC	AS NOTED	FRANKEL STEEL LIMITED	
E	2	DATE	BY	HOLES	1 3/16 DIA U/N	220 ATTWELL DRIVE, UNIT 1, REXDALE, ONTARIO M9W 5B2	
V	1	DATE	BY	FINISH	NONE		
MADE 27 MB		DATE 29AUG85	SQUAD FR	PROJECT: 7 WORLD TRADE CENTER		CONTRACT	DWG. NO.
CHK'D 28 BF		DATE Nov.8/85		DETAIL: COLUMN (23RD TIER) ZONE 4		84-153	4080