

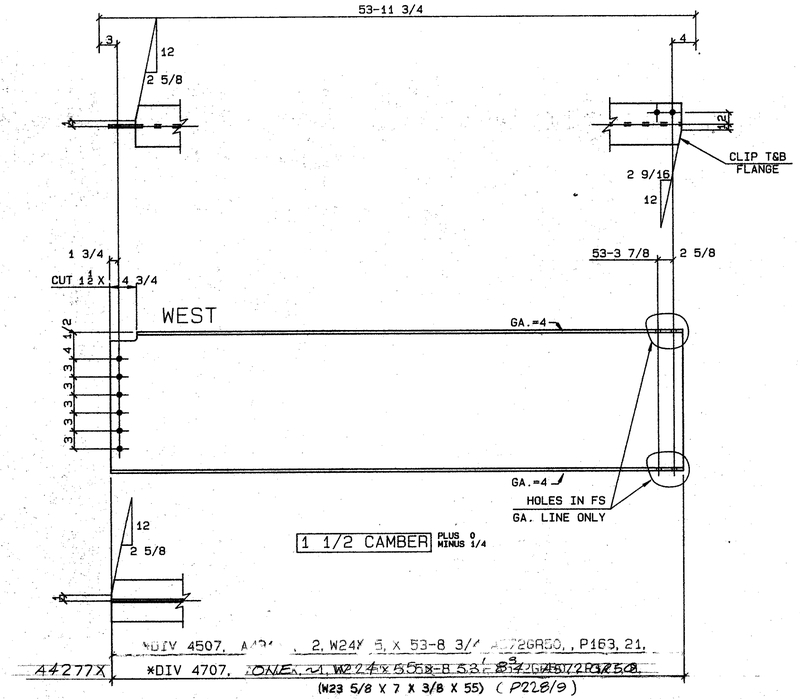



44277X *DIV 4507, A4[illegible], 2, W24X55, X 53-8 3/4, A572GR50, , P163, 21,
*DIV 4707, ~~ONE~~, ~~W24X55, X 53-8 3/4, A572GR50~~ (W23 5/8 X 7 X 3/8 X 55) (P228/9)

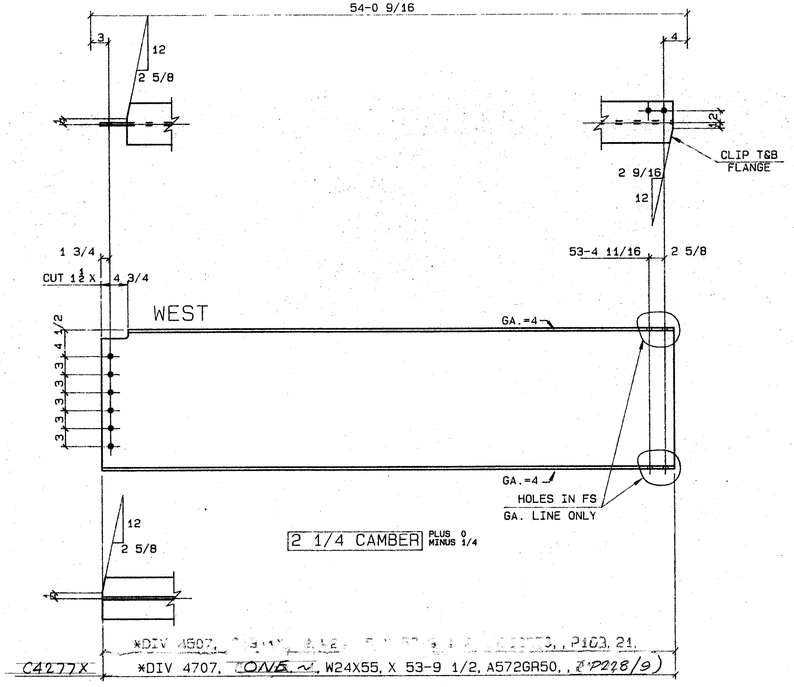


C4277X *DIV 4507, D4311X, 2, W24X55, X 53-9 1/2, A572GR50, , P163, 21,
*DIV 4707, ~~ONE~~, W24X55, X 53-9 1/2, A572GR50, , (P228/9)

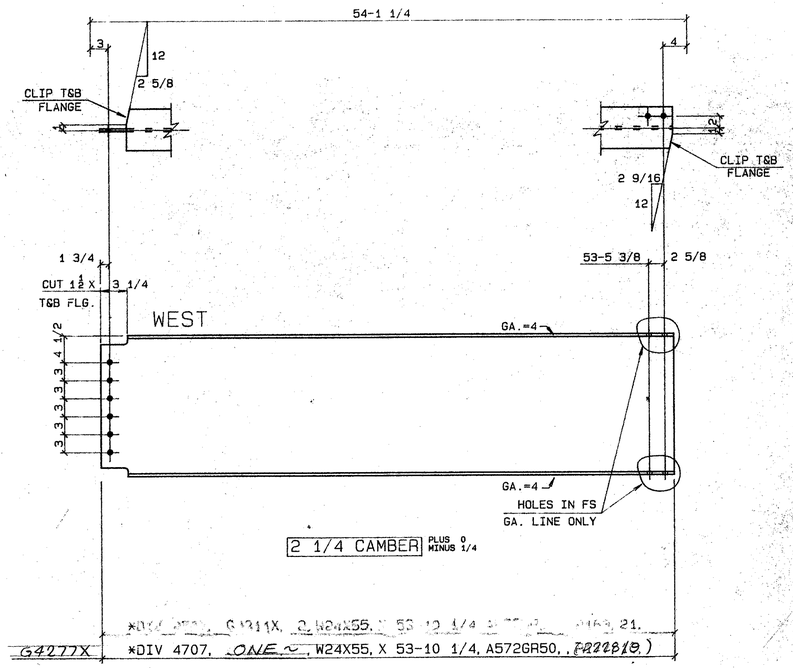


G4277X *DIV 4507, G4311X, 2, W24X55, X 53-10 1/4, A572GR50, , P163, 21,
*DIV 4707, ~~ONE~~, W24X55, X 53-10 1/4, A572GR50, , (P228/9)

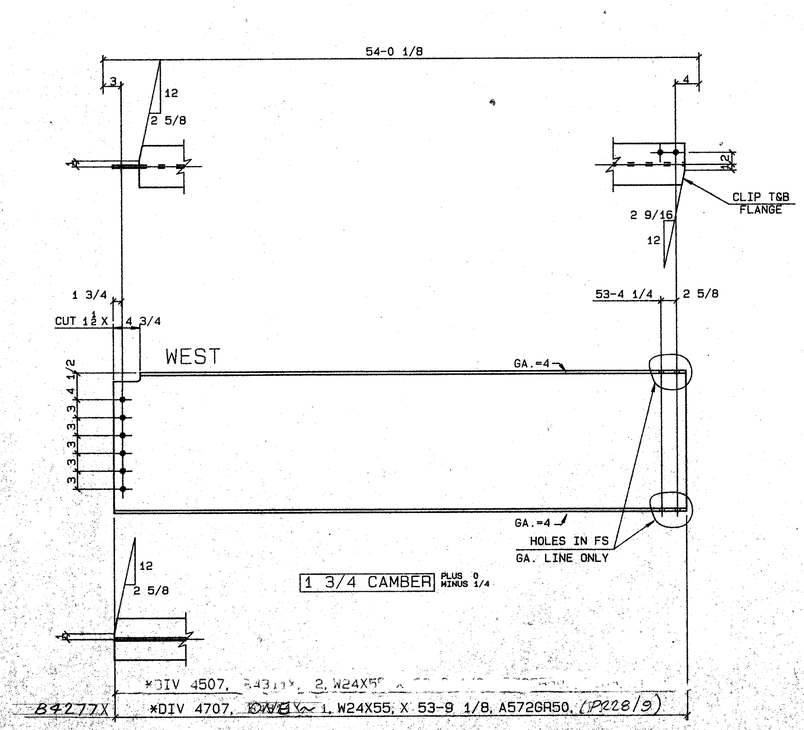

B4277X *DIV 4507, B4311X, 2, W24X55, X 53-9 1/8, A572GR50, , P163, 21,
*DIV 4707, ~~ONE~~, W24X55, X 53-9 1/8, A572GR50, (P228/9)

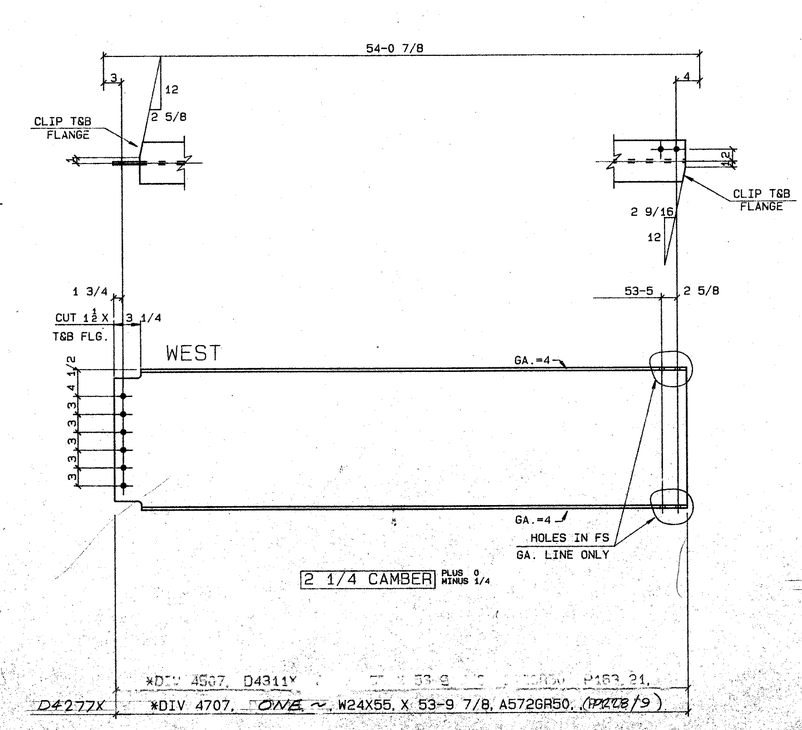

D4277X *DIV 4507, D4311X, 2, W24X55, X 53-9 7/8, A572GR50, , P163, 21,
*DIV 4707, ~~ONE~~, W24X55, X 53-9 7/8, A572GR50, (P228/9)

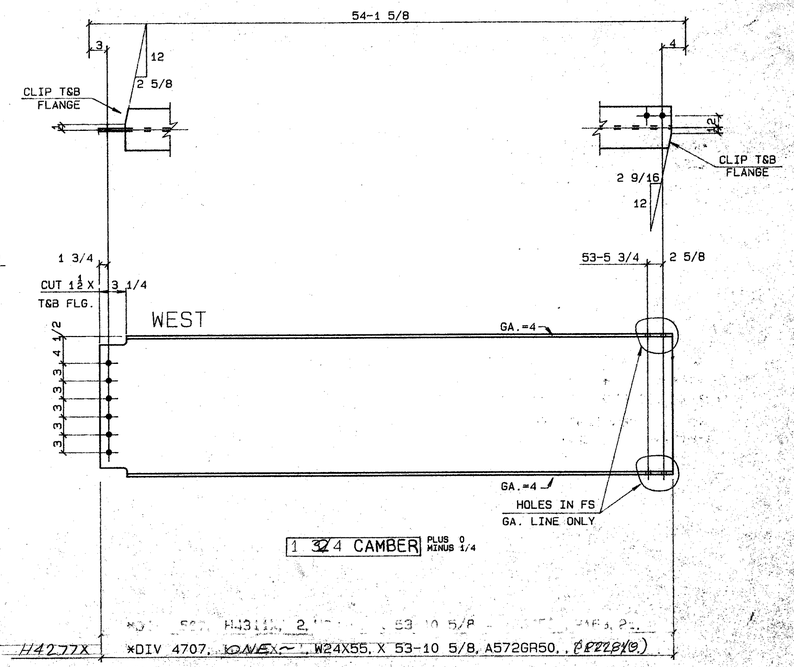

H4277X *DIV 4507, H4311X, 2, W24X55, X 53-10 5/8, A572GR50, , P163, 21,
*DIV 4707, ~~ONE~~, W24X55, X 53-10 5/8, A572GR50, (P228/9)

SHOP NOTES
MATERIAL AS NOTED
USE E70 SERIES ELECTRODES
REF. DWGS. 901, 9171
9172, 9182, E4049181

Apr 16/86

FOR 7/8 DIA. A325

R 3	DATE	BY	SPEC	AS NOTED	FRANKEL STEEL LIMITED		
E 2	DATE	BY	HOLES	15/16 DIA	220 ATTWELL DRIVE, UNIT 1, REXDALE, ONTARIO M9W 5B2		
V 1	DATE	BY	FINISH	NONE			
MADE 27 WWP	DATE ~~FEB 26/86~~	SQUAD FR	PROJECT: 7 WORLD TRADE CENTER		CONTRACT	DWG. NO.
CHK'D 28 J.B.	DATE ~~MAR 24/86~~		DETAIL: BEAMS ~~47TH FLOOR~~ H FLOOR		84-153	4277

X64