
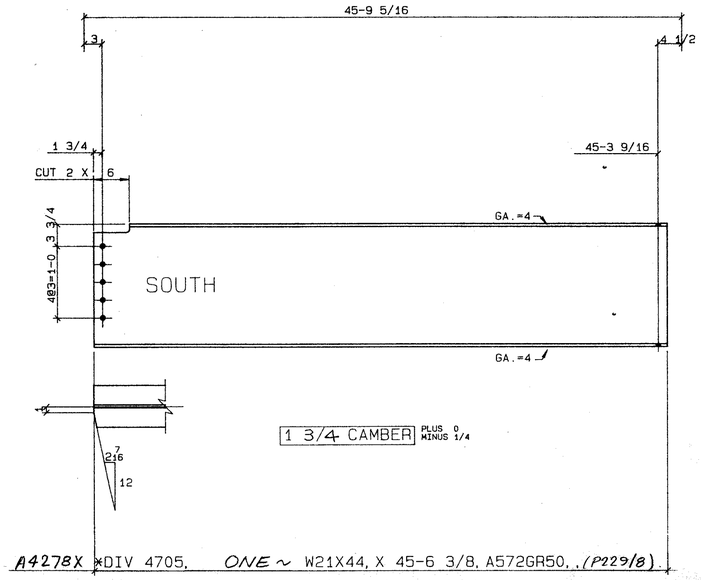



A4278X *DIV 4705, ONE ~ W21X44, X 45-6 3/8, A572GR50, (P229/8)

(W20 5/8 X 6 1/2 X 3/8 @ 44)

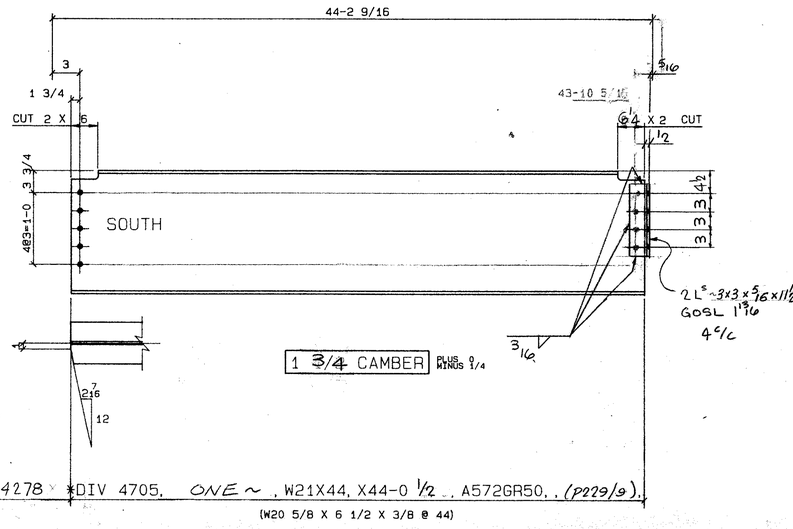


C4278 *DIV 4705, ONE ~ , W21X44, X44-0 1/2 , A572GR50, (P229/9)

(W20 5/8 X 6 1/2 X 3/8 @ 44)

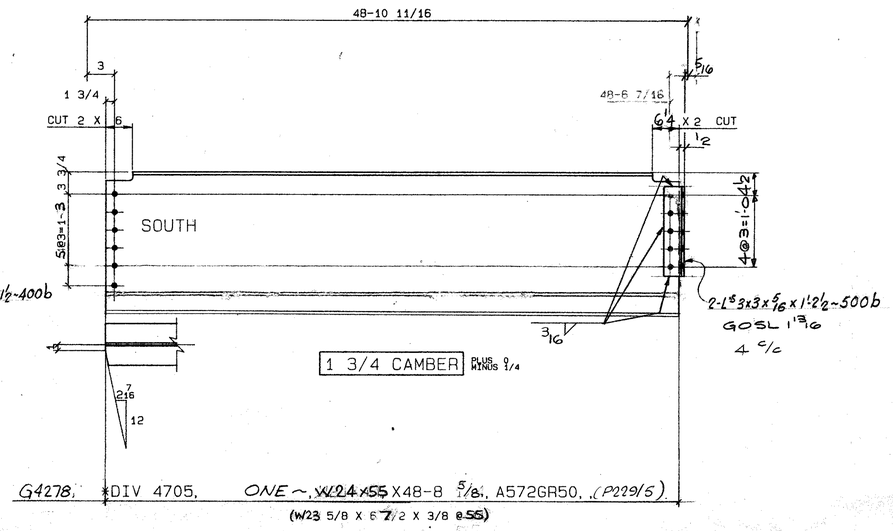


G4278 *DIV 4705, ONE ~ ~~W24x55~~ X48-8 5/8, A572GR50, (P229/5)

(W23 5/8 X 6 ~~7~~ 1/2 X 3/8 @ ~~55~~)

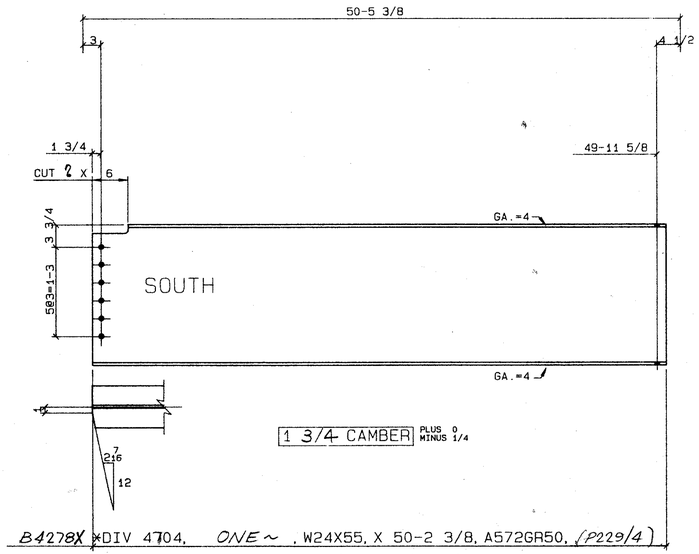


B4278X *DIV 4704, ONE ~ , W24X55, X 50-2 3/8, A572GR50, (P229/4)

(W23 5/8 X 7 X 3/8 @ 55)

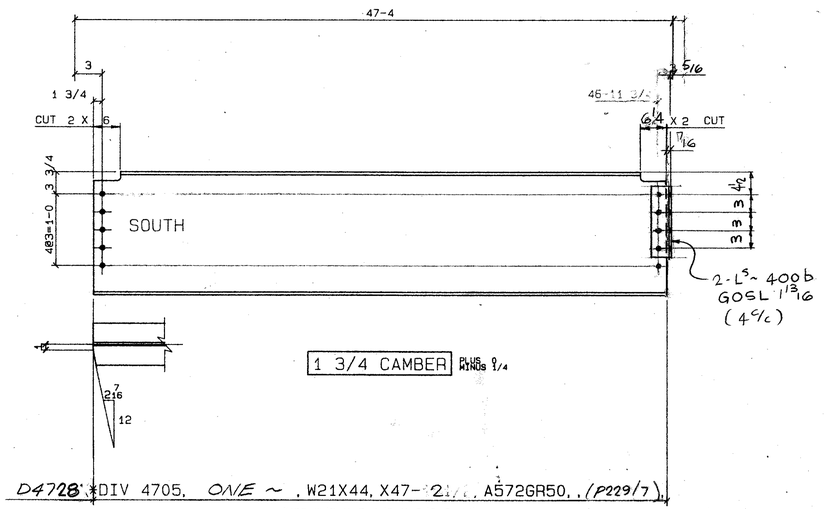

D4728 *DIV 4705, ONE ~ , W21X44, X47-2 1/2 , A572GR50, (P229/7)

(W20 5/8 X 6 1/2 X 3/8 @ 44)

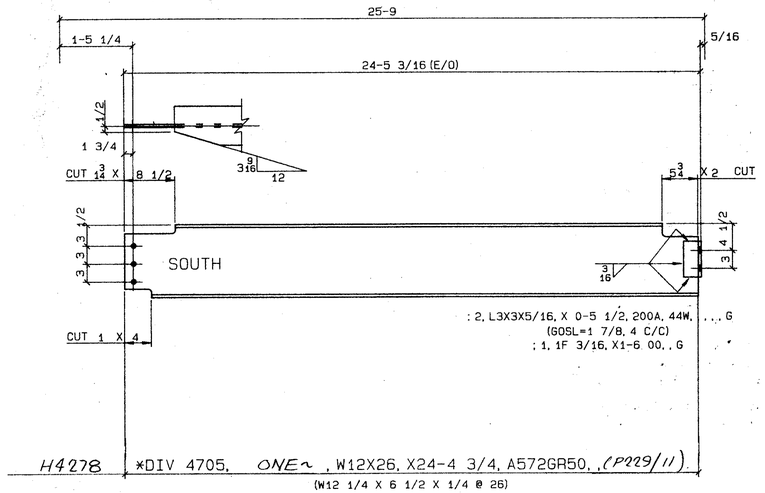

H4278 *DIV 4705, ONE ~ , W12X26, X24-4 3/4, A572GR50, (P229/11)

(W12 1/4 X 6 1/2 X 1/4 @ 26)

SHOP NOTES Apr 16/86
MATERIAL AS NOTED
USE E70 SERIES ELECTRODES
REF. DWGS. E47A5, 901, 9171
9173, 9181, 9183, E46
9196

FOR 7/8 DIA. A325

R	3	DATE	BY	SPEC	AS NOTED
E	2	DATE	BY	HOLES	15/16 DIA
V	1	DATE	BY	FINISH	NONE

FRANKEL STEEL LIMITED
220 ATTWELL DRIVE, UNIT 1, REXDALE, ONTARIO M9W 5B2

X64	MADE 27 YWP	DATE Feb 21/86	SQUAD FR	PROJECT: 7 WORLD TRADE CENTER	CONTRACT 84-153	DWG. NO. 4278
	CHK'D 28 J.B.	DATE Mar 24/86		DETAIL: BEAMS 47TH FLOOR		