
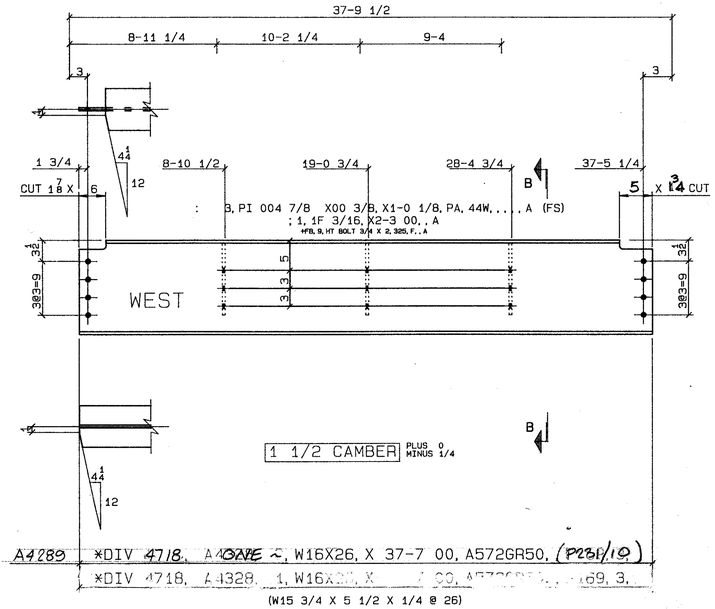



A4289 *DIV 4718, A4328 ~, W16X26, X 37-7 00, A572GR50, (P228/10)

*DIV 4718, A4328 1, W16X[illegible], X [illegible] 00, A572GR[illegible] [illegible]69, 3,

(W15 3/4 X 5 1/2 X 1/4 @ 26)

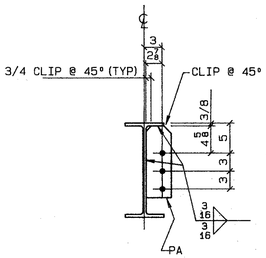

SECTION B-B

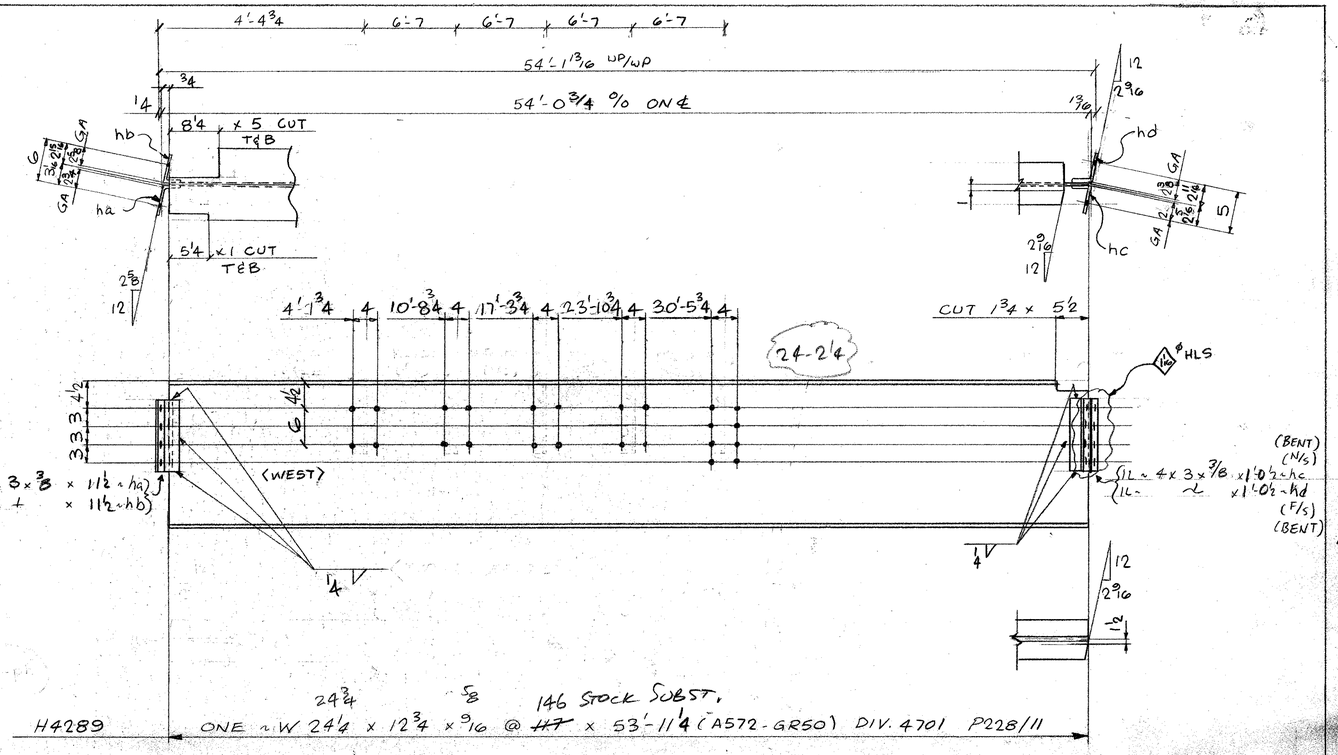


(N/S)(BENT) L ~ 4 x 3 x 3/8 x 1'-1 1/2 ~ ha

(F/S)(⊥) L ~ + x 1'-1 1/2 ~ hb

(N/S)(BENT) L ~ 4 x 3 x 3/8 x 1'-0 1/2 ~ hc

(F/S)(BENT) L ~ x 1'-0 1/2 ~ hd


H4289 ONE ~ W 24 1/4 x 12 3/4 x 9/16 @ ~~HT~~ x 53'-11 1/4 (A572-GR50) DIV. 4701 P228/11

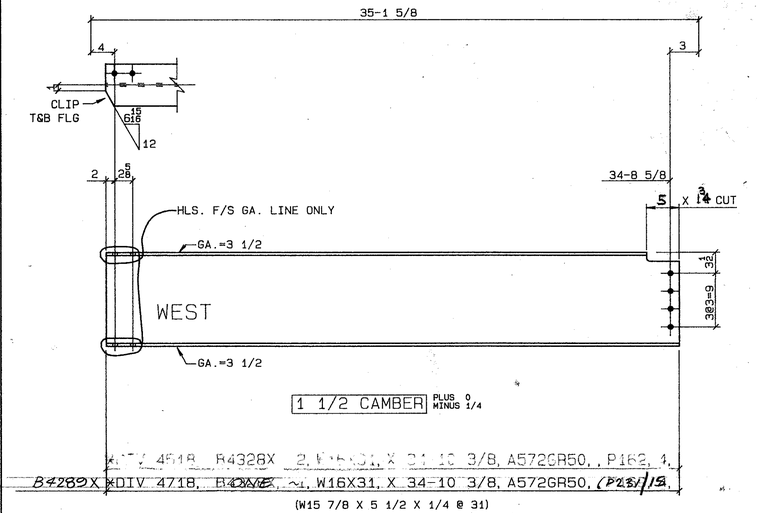

B4289X *DIV 4718, B4328X 2, W16X31, X 34-10 3/8, A572GR50, , P162, 1,

B4289X *DIV 4718, B~~ONE~~ ~1, W16X31, X 34-10 3/8, A572GR50, (P228/12)


(W15 7/8 X 5 1/2 X 1/4 @ 31)

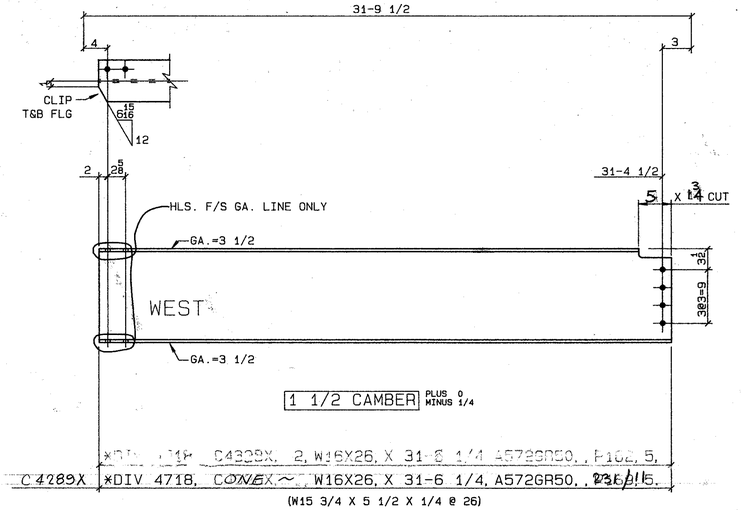

C4289X *DIV 4718, C4328X, 2, W16X26, X 31-6 1/4 A572GR50, , P162, 5,

C4289X *DIV 4718, C~~ONE~~X ~, W16X26, X 31-6 1/4, A572GR50, , (P228/15)

(W15 3/4 X 5 1/2 X 1/4 @ 26)

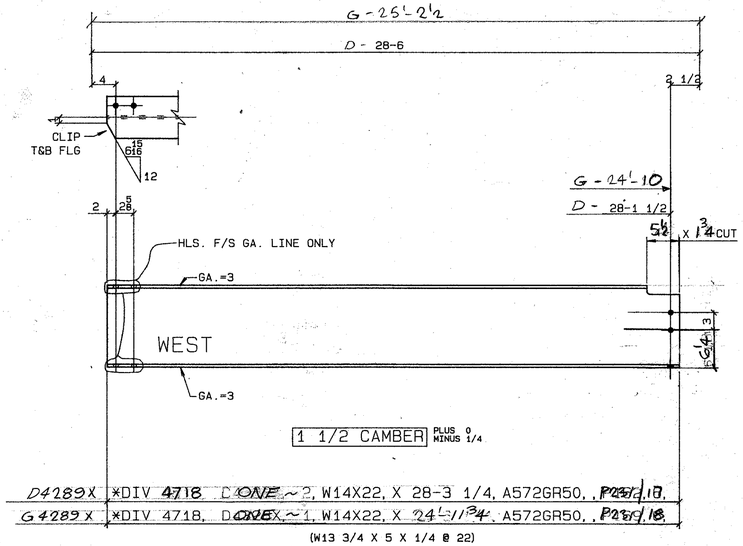

D4289X *DIV 4718 D~~ONE~~ ~2, W14X22, X 28-3 1/4, A572GR50, , P228/18,

G4289X *DIV 4718, D~~ONE~~X ~1, W14X22, X 24'-11 3/4, A572GR50, , P228/18,

(W13 3/4 X 5 X 1/4 @ 22)

FIELD BOLTS

24 - HT BOLT 7/8 x 2 1/4 (A325).

9 - 1 x 2 (l)

SHOP NOTES Appr 16/8/6

MATERIAL AS NOTED

USE E70 SERIES ELECTRODES

REF. DWGS. E4424A, 901, 9171, 9172, 9173, 9175, E45, 9181, 9182, 9183, 9185

FOR 7/8 DIA. A325

R 3 DATE BY	SPEC AS NOTED	FRANKEL STEEL LIMITED			
E 2 DATE BY	HOLES 15/16 DIA	220 ATTWELL DRIVE, UNIT 1, REXDALE, ONTARIO M9W 5B2			
V 1 DATE BY	FINISH NONE				
X64	MADE 27 VWP DATE 5/DEC/1/84	SQUAD FR	PROJECT: 7 WORLD TRADE CENTER	CONTRACT 84-153	DWG. NO. 4289
	CHK'D 28 JB DATE 5/Dec 12/84		DETAIL: BEAMS 46TH 47TH 48TH FLOOR		