
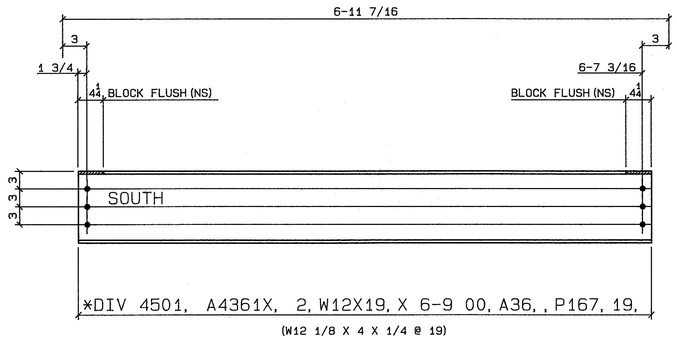


*DIV 4501, A4361X, 2, W12X19, X 6-9 00, A36, , P167, 19,

(W12 1/8 X 4 X 1/4 @ 19)

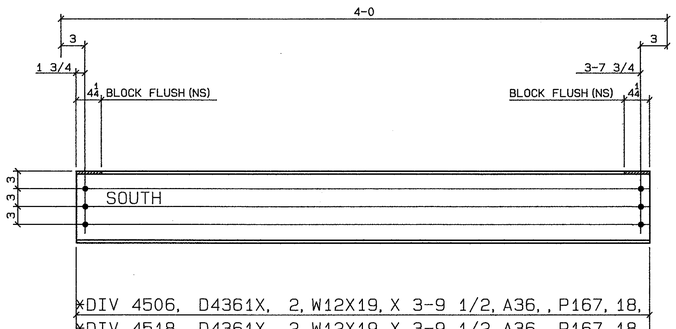


*DIV 4506, D4361X, 2, W12X19, X 3-9 1/2, A36, , P167, 18,

*DIV 4518, D4361X, 2, W12X19, X 3-9 1/2, A36, , P167, 18,

*DIV 4706, D4361X, 1, W12X19, X 3-9 1/2, A36, , P183, 25,

*DIV 4718, D4361X, 1, W12X19, X 3-9 1/2, A36, , P183, 25,


(W12 1/8 X 4 X 1/4 @ 19)

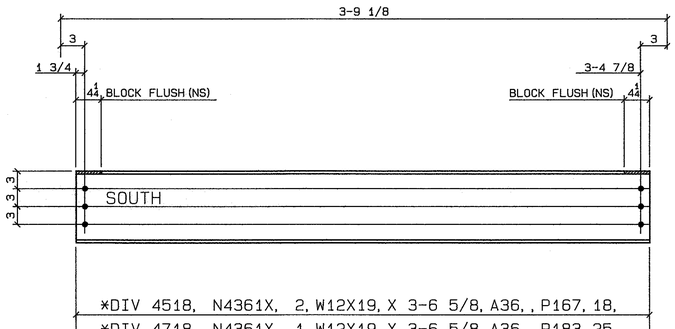

*DIV 4518, N4361X, 2, W12X19, X 3-6 5/8, A36, , P167, 18,


*DIV 4718, N4361X, 1, W12X19, X 3-6 5/8, A36, , P183, 25,

(W12 1/8 X 4 X 1/4 @ 19)

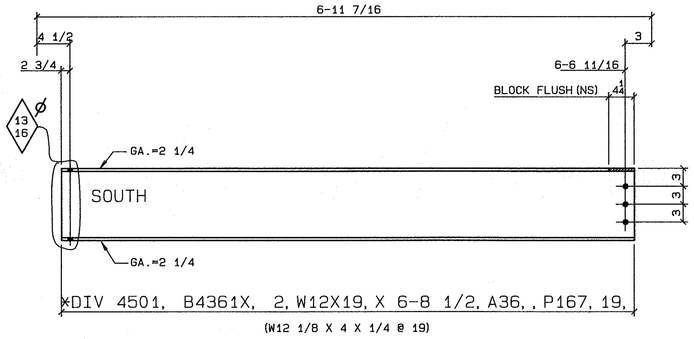

*DIV 4501, B4361X, 2, W12X19, X 6-8 1/2, A36, , P167, 19,

(W12 1/8 X 4 X 1/4 @ 19)

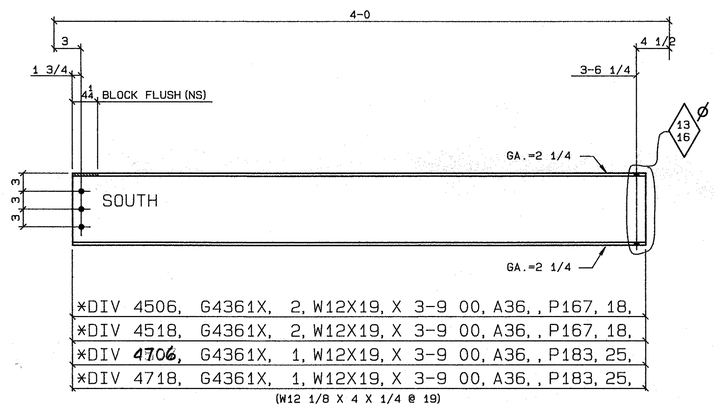


*DIV 4506, G4361X, 2, W12X19, X 3-9 00, A36, , P167, 18,

*DIV 4518, G4361X, 2, W12X19, X 3-9 00, A36, , P167, 18,

*DIV 4706, G4361X, 1, W12X19, X 3-9 00, A36, , P183, 25,

*DIV 4718, G4361X, 1, W12X19, X 3-9 00, A36, , P183, 25,

(W12 1/8 X 4 X 1/4 @ 19)

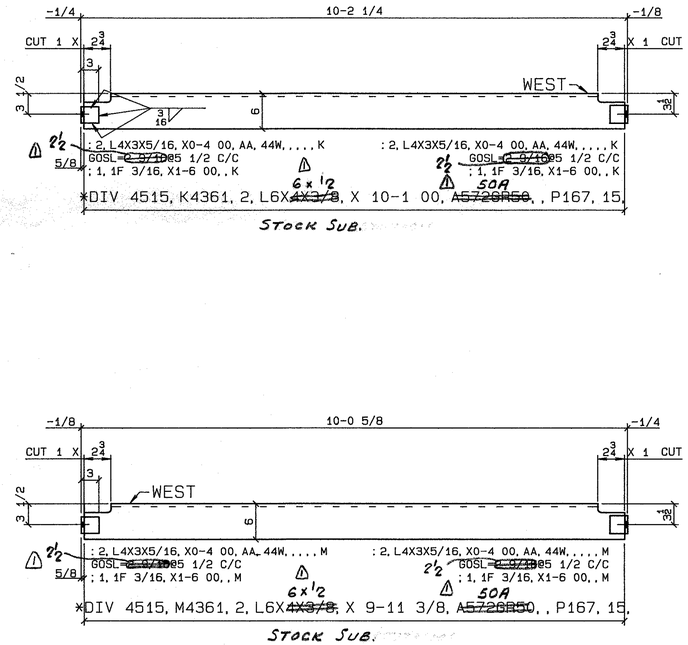


*DIV 4515, K4361, 2, L6X~~4X3/8~~, X 10-1 00, ~~A572GR50~~ 50A, , P167, 15,

STOCK SUB.


*DIV 4515, M4361, 2, L6X~~4X3/8~~, X 9-11 3/8, ~~A572GR50~~, , P167, 15,

STOCK SUB.

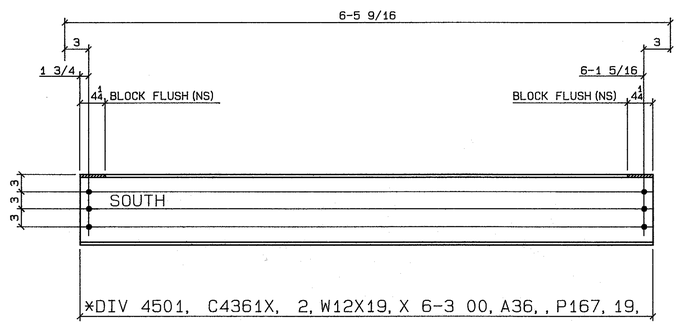

*DIV 4501, C4361X, 2, W12X19, X 6-3 00, A36, , P167, 19,

(W12 1/8 X 4 X 1/4 @ 19)

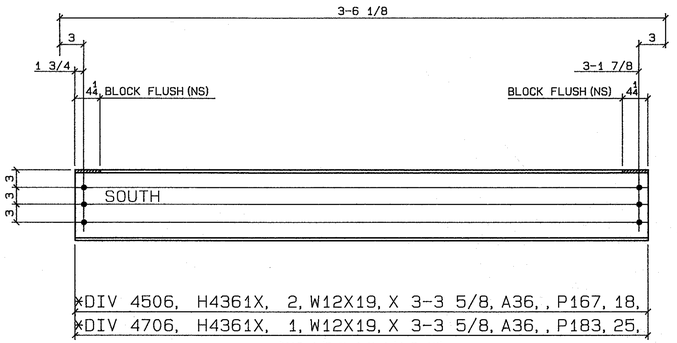

*DIV 4506, H4361X, 2, W12X19, X 3-3 5/8, A36, , P167, 18,

*DIV 4706, H4361X, 1, W12X19, X 3-3 5/8, A36, , P183, 25,

(W12 1/8 X 4 X 1/4 @ 19)

SHOP NOTES
MATERIAL AS NOTED
USE E70 SERIES ELECTRODES
REF. DWGS. E44/E45, 901, 9171
9173, 9181, E46

Dec 13/85 R.
Nov 12/85

FOR 7/8 DIA. A325

STOCK SUB

R	3	DATE	BY	SPEC	AS NOTED	FRANKEL STEEL LIMITED	
E	2	DATE	BY	HOLES	15/16 DIA	220 ATTWELL DRIVE, UNIT 1, REXDALE, ONTARIO M9W 5B2	
V	1	DATE DEC 13/85	BY D.Z.	FINISH	NONE		
MADE 27 MB		DATE SEP26/85	SQUAD FR	PROJECT: 7 WORLD TRADE CENTER		CONTRACT	DWG. NO.
CHK'D 28 D.Z.	0	DATE 0 Nov.1/85		DETAIL: BEAMS 44TH TO 46TH FLOOR		84-153	4361